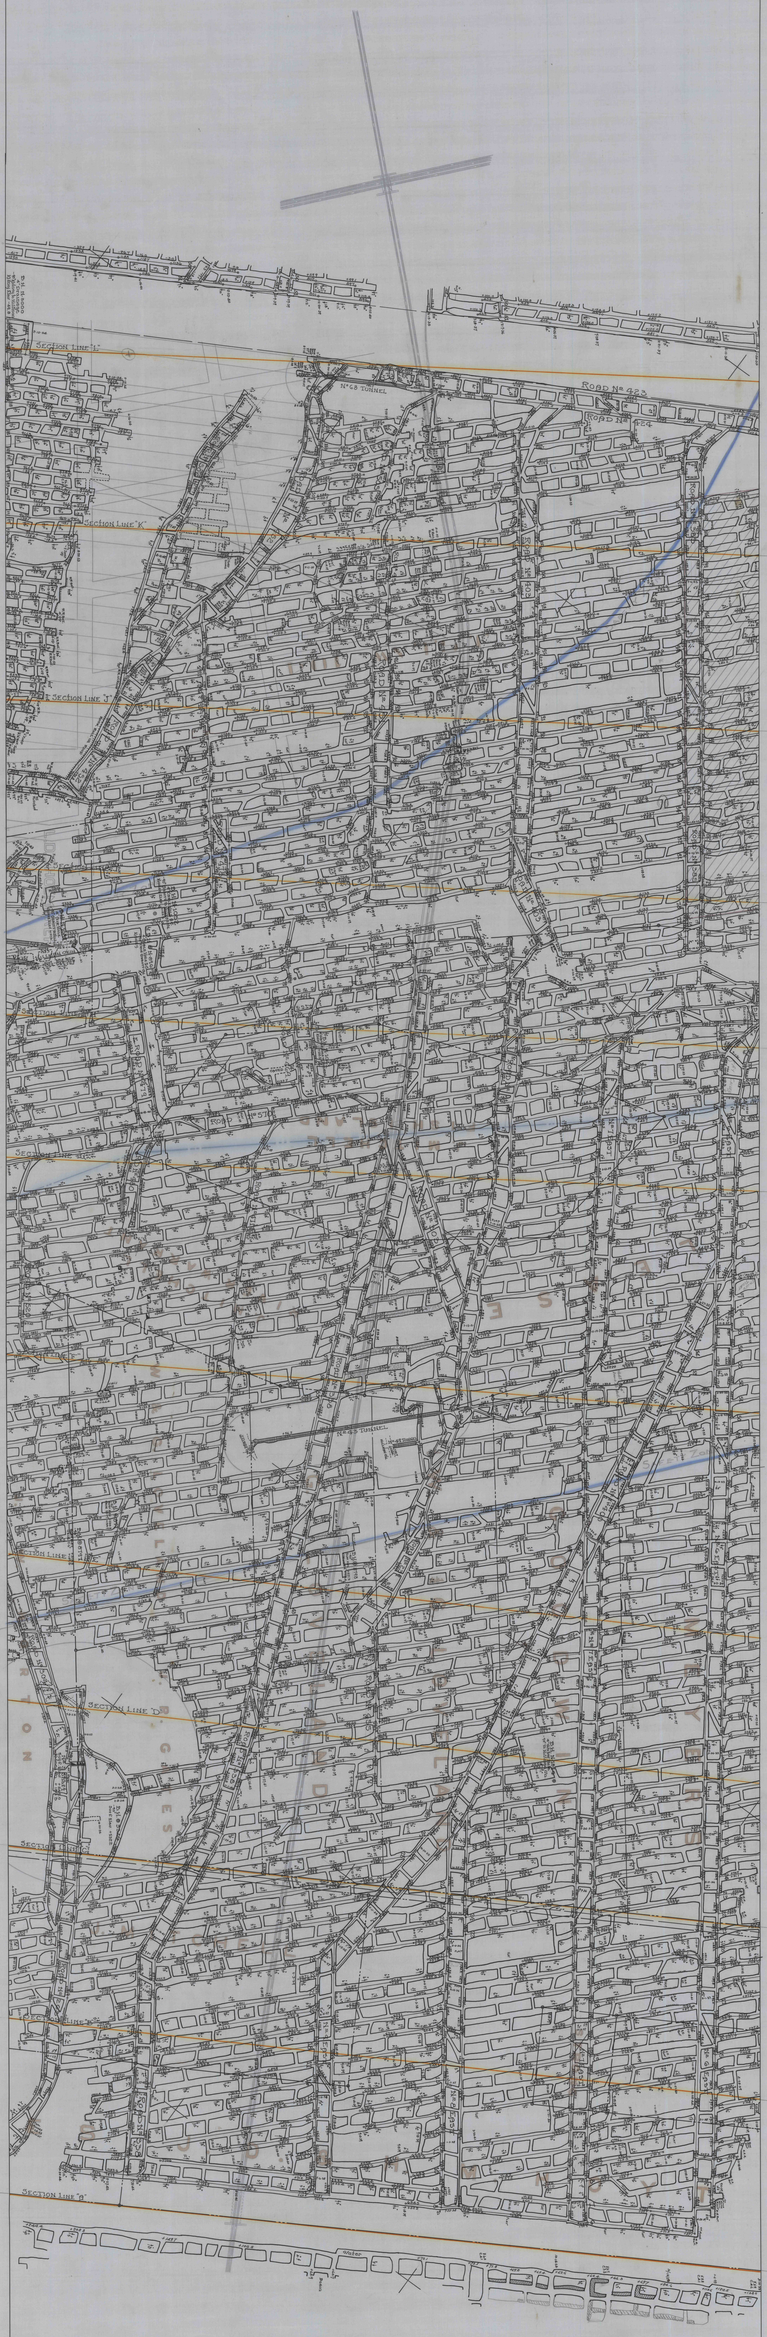

WOODWARD COLLIERY - KIDNEY VEIN