


POSTED.	
In Service Jun. 30.	
Apr. 16, 40.	F
Sept. 1, 43.	F
Apr. 24, 45.	F

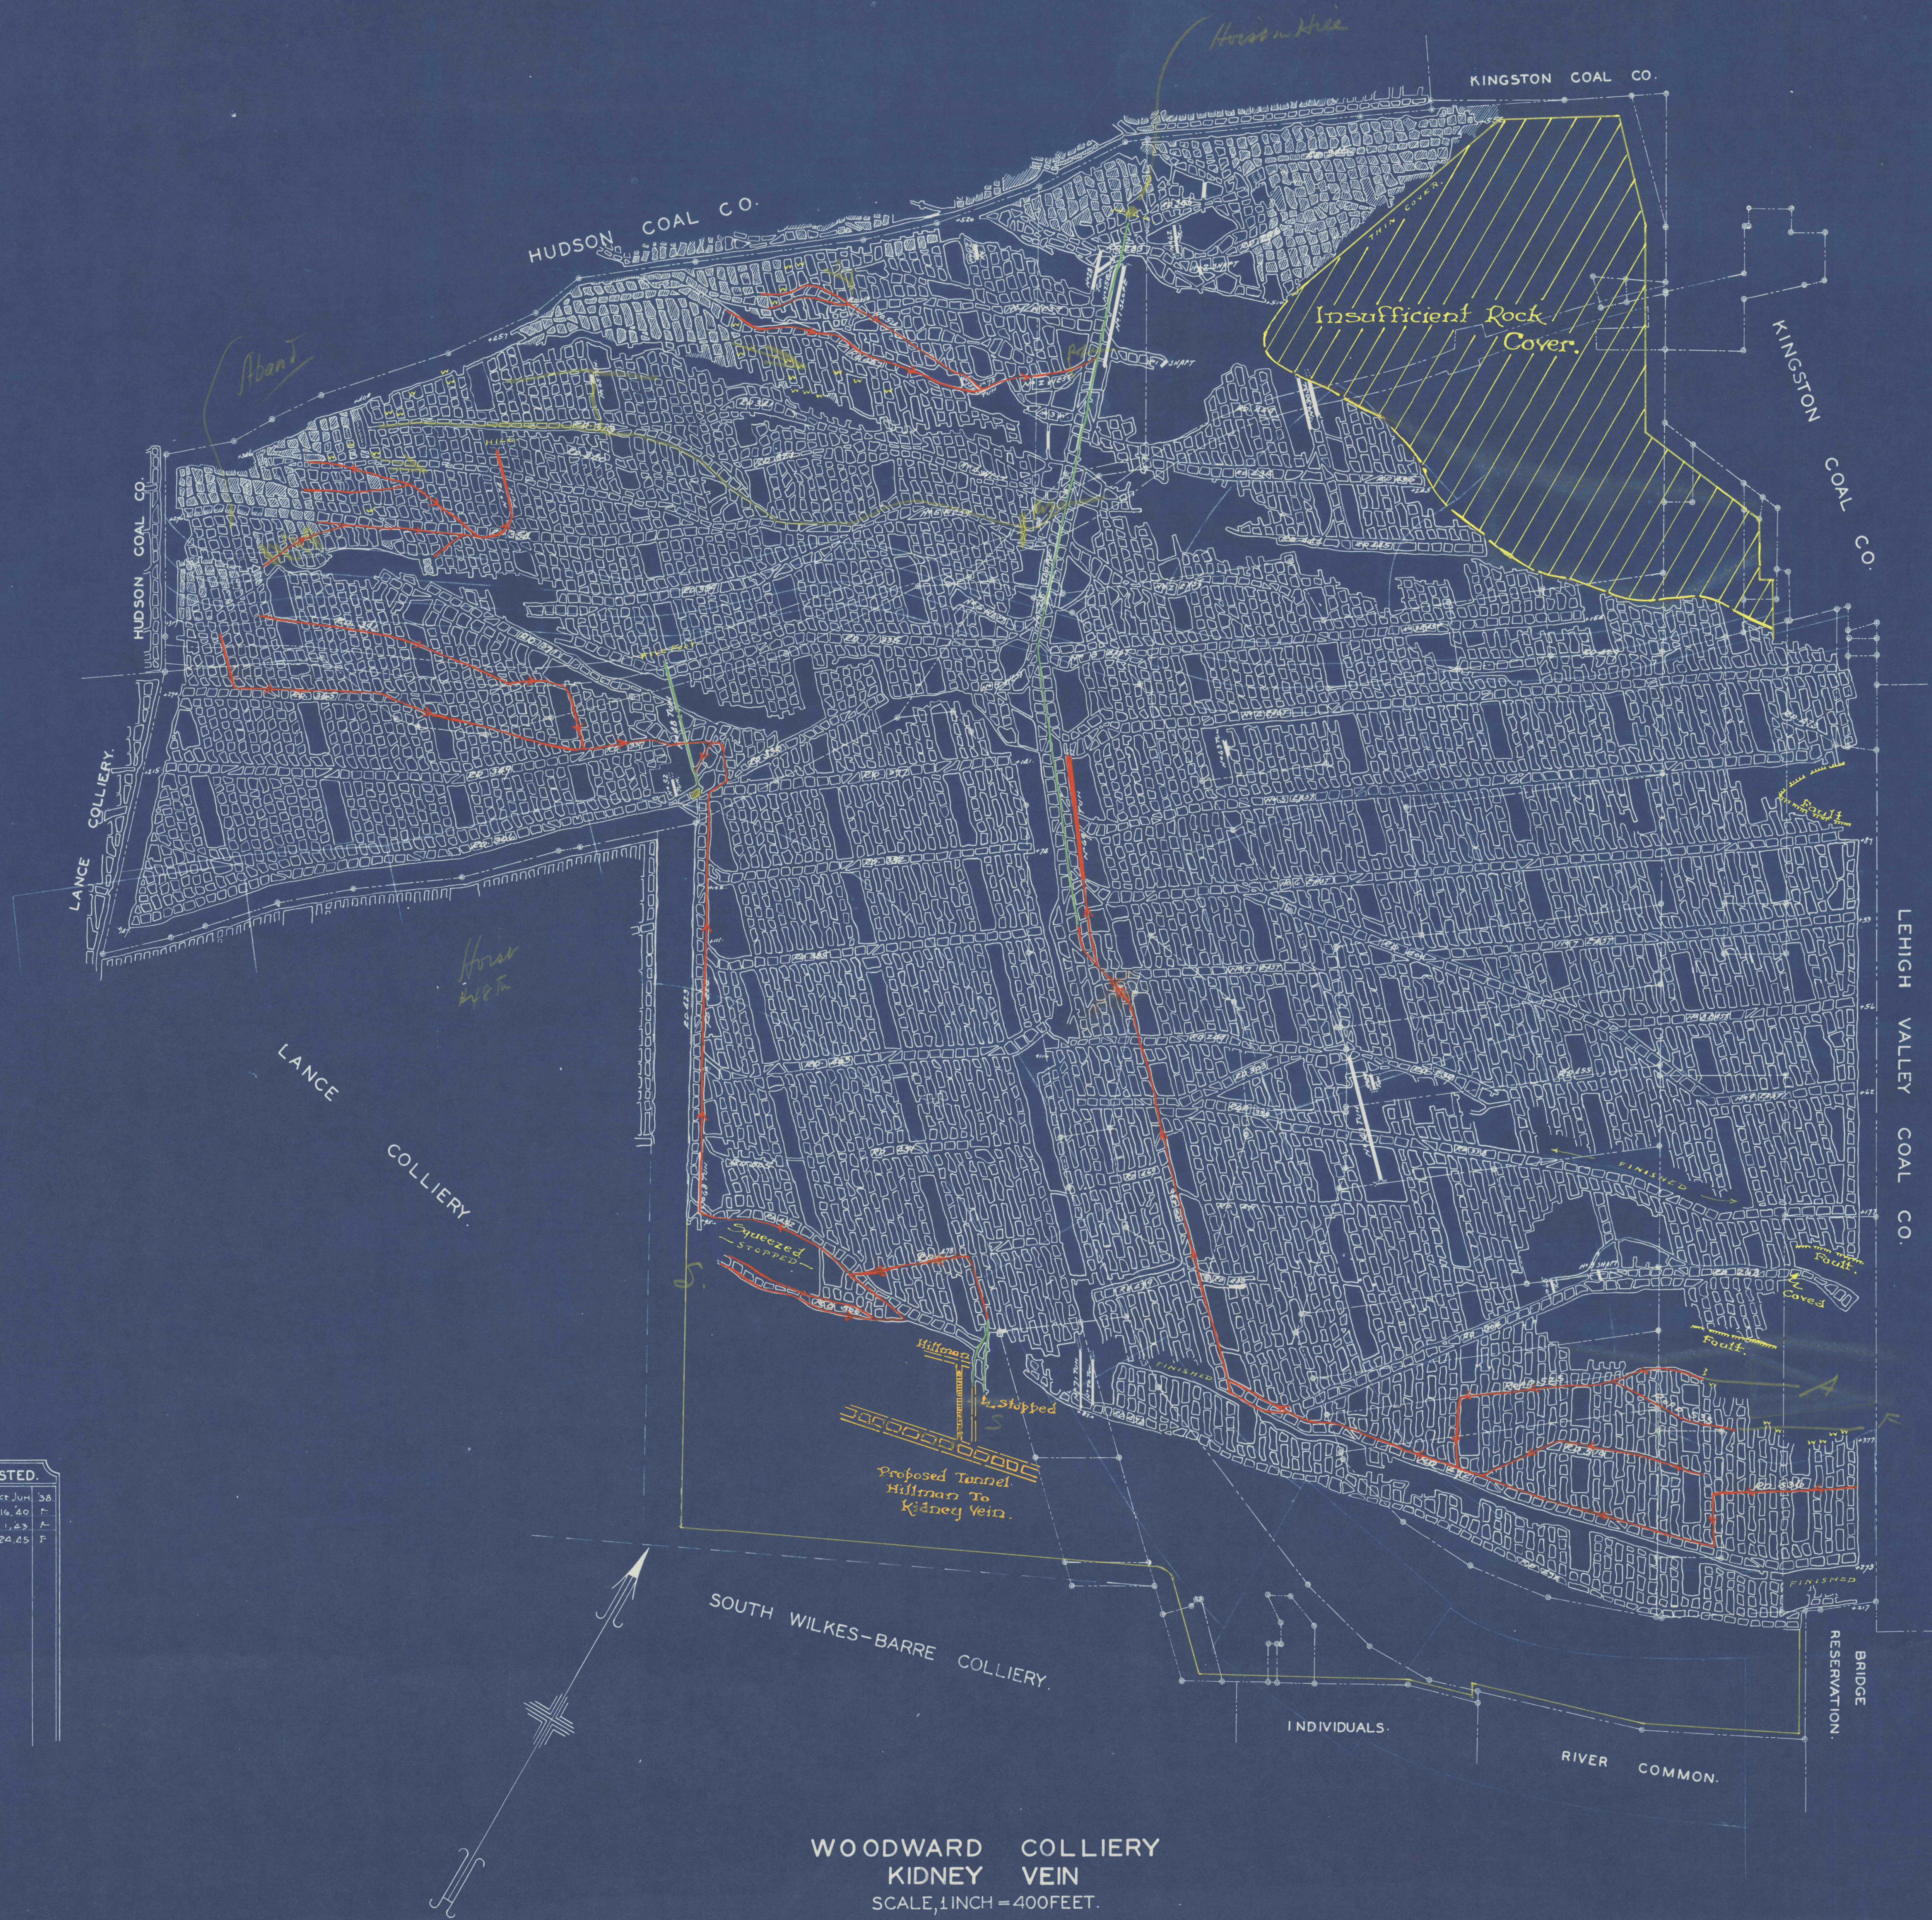

WOODWARD COLLIERY
KIDNEY VEIN
SCALE, 1 INCH = 400 FEET.