


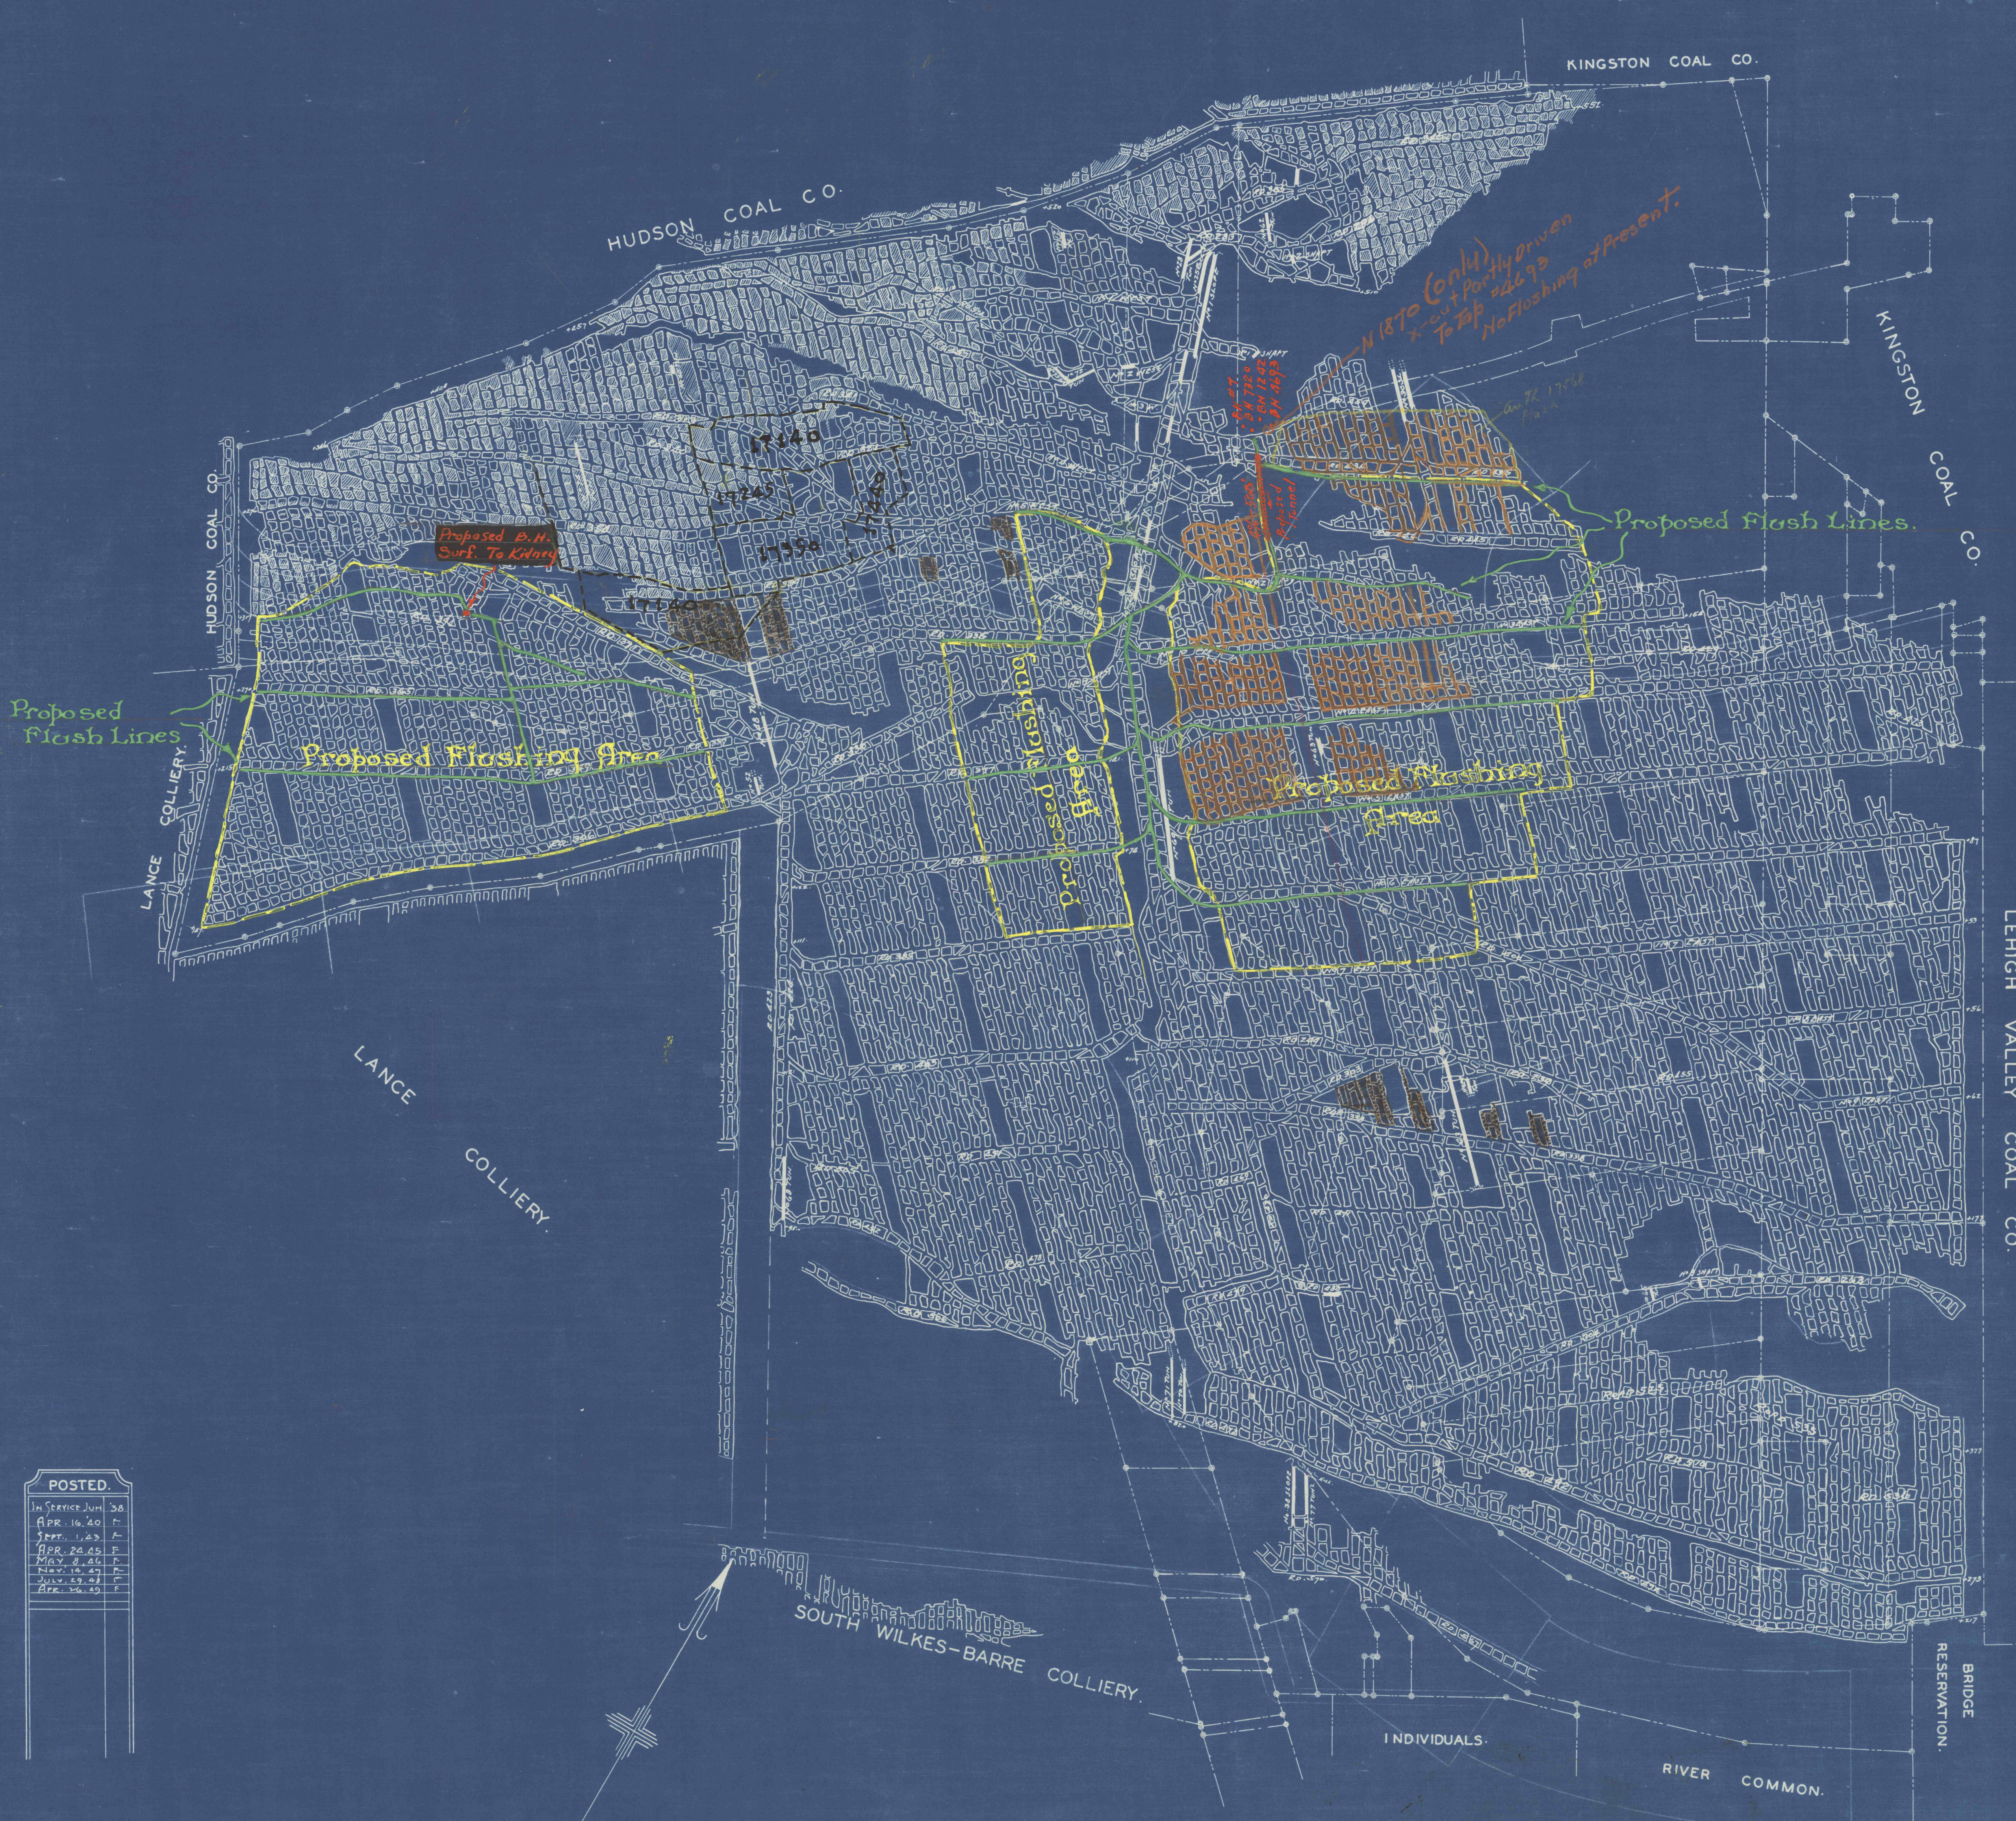

POSTED.

IN SERVICE JUN. 38
APR. 19, 40 F
SEP. 1, 23 F
APR. 20, 45 F
MAY 8, 46 F
NOV. 10, 47 F
JULY 29, 48 F
APR. 26, 49 F

WOODWARD KIDNEY VEIN
SCALE, 1 INCH = 400 FEET.

LEGEND

PRESENT 6" FLUSH LINES.	AREAS ROCK PACKED, AND LATER FLUSHED.
PROPOSED 6" FLUSH LINES.	PROPOSED FLUSHING AREAS OUTLINED.
AREAS FLUSHED.	PROPOSED WATER COURSES.
AREAS ROCK PACKED.	