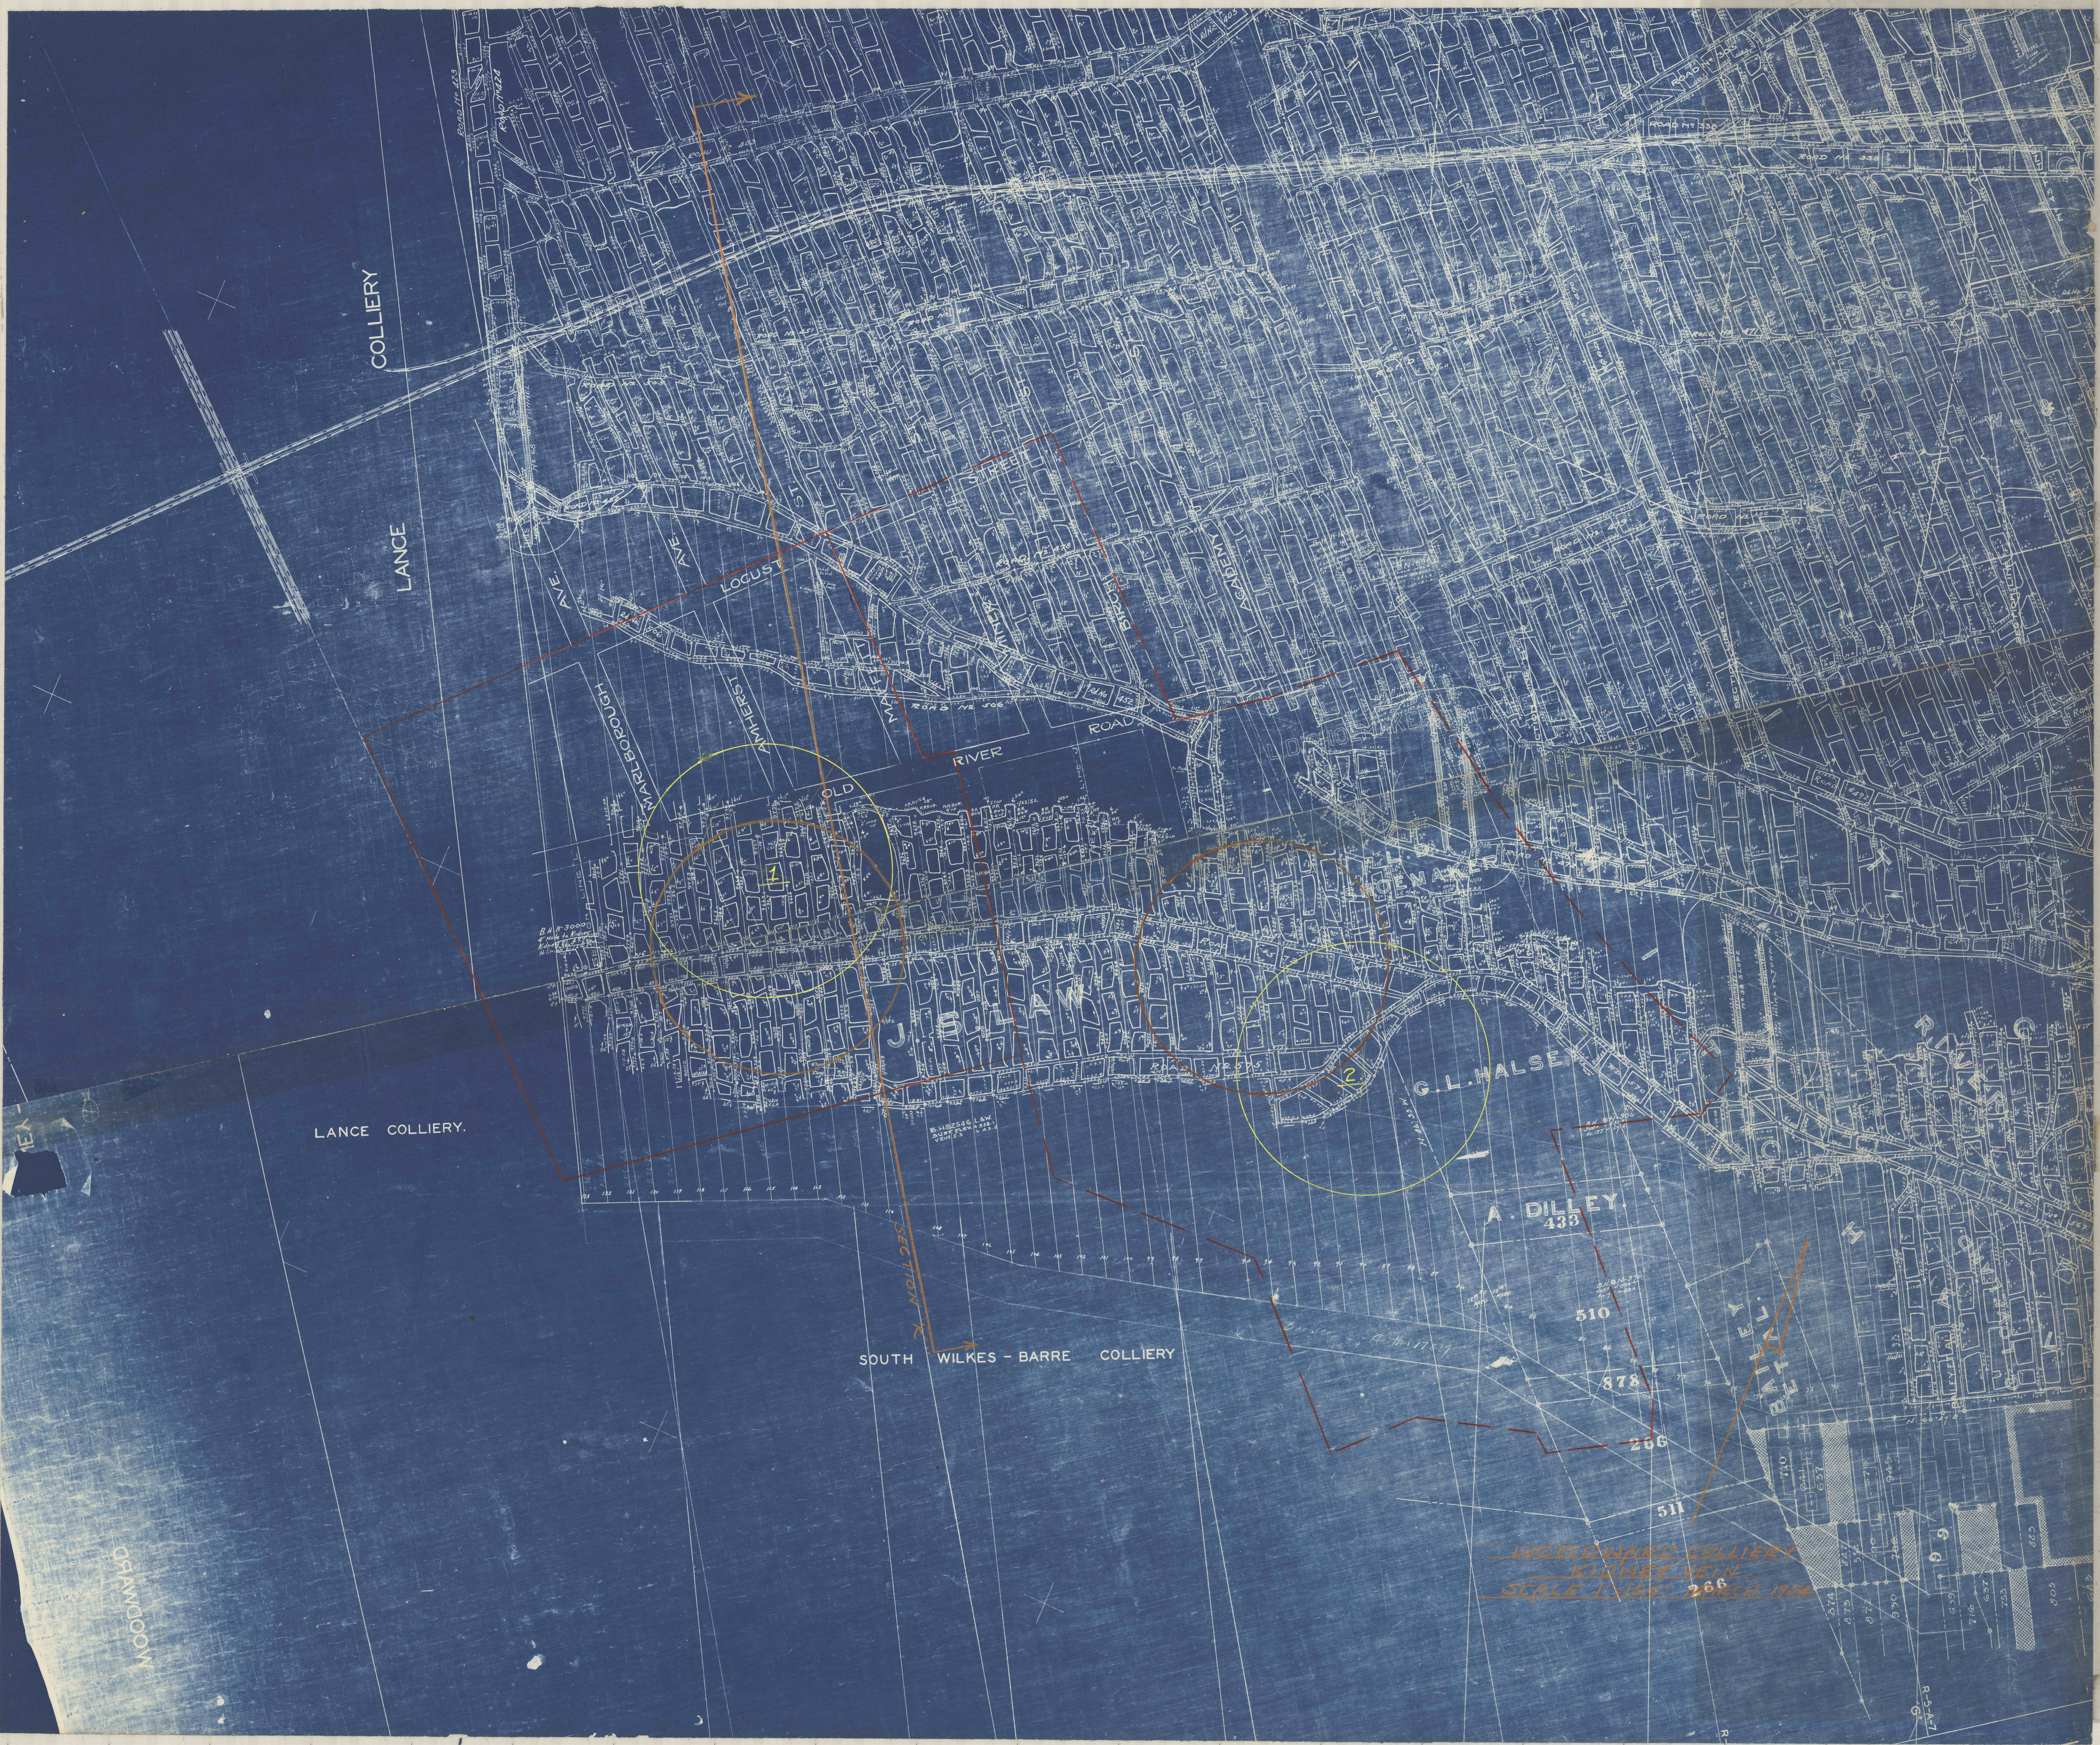
COLLIERY
LANCE
LANCE COLLIERY.
SOUTH WILKES - BARRE COLLIERY
WOODWARD
MARLBOROUGH AVE.
AMHERST AVE.
LOCUST ST.
STREET
BIRCH ST.
ACADEMY ST.
OLD RIVER ROAD
ROAD No 423
ROAD No 424
ROAD No 338
ROAD No 305
ROAD No 451
ROAD No 476
ROAD No 479
ROAD No 480
ROAD No 506
Rd. No 452
ROAD No 575
ROAD No 492
SECTION LINE G
SECTION LINE
J. S. LAW
L. D. SHOEMAKER
G. L. HALSEY
A. DILLEY
433
510
878
266
511
BAILEY
1
2
SECTION K
B.H. N-3000
4" Hole to Kidney
B.H. ⓪2546 L.&W.
SURF. ELEV. + 328.1
VEIN 5.3 + 43.5
N 46° 33' W.
N 60° 47' E
R-5-A-7
G
710
841
637
676
945
847
554
690
706
874
873
872
930
639
716
637
753
883
805
99

WOODWARD COLLIERY
KIDNEY VEIN
SCALE 1"=100' MARCH 1954