
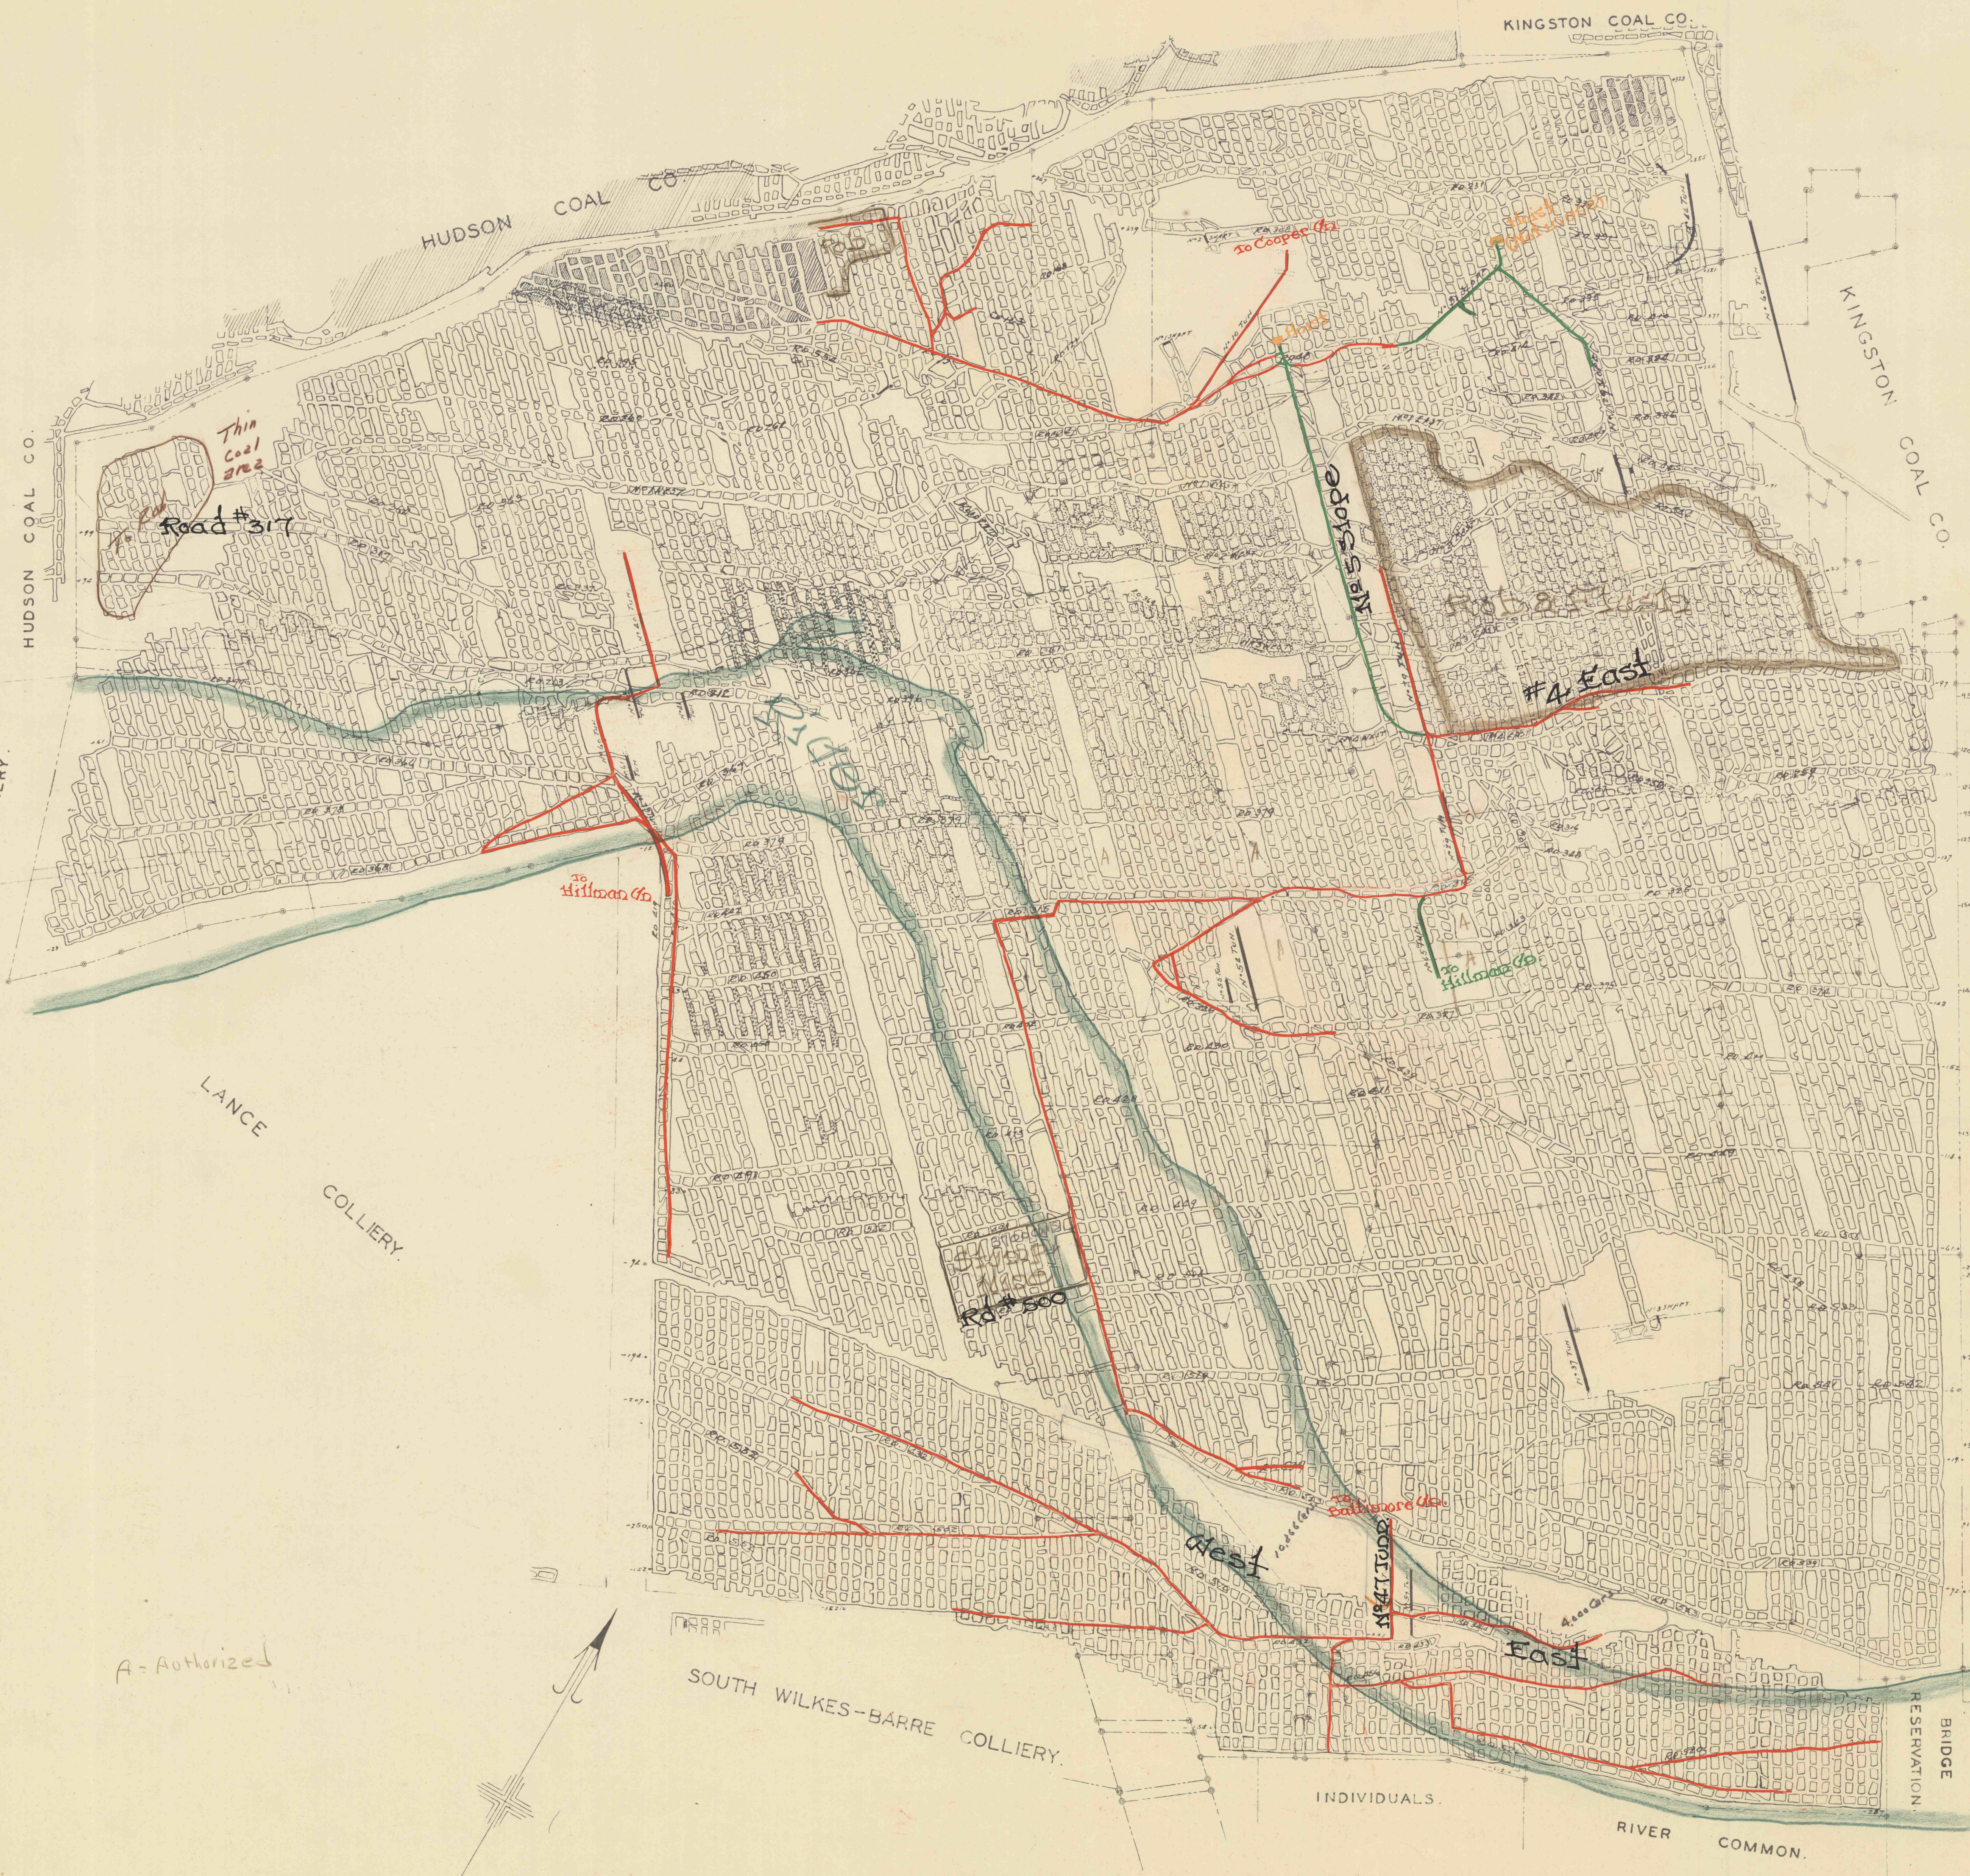


POSTED	
IN SERVICE	JUNE '38
APR 18, 20	F
NOV 2, 45	F
APR 30, 45	F
MAY 7, 46	F
NOV 20, 47	F
AUG 1, 48	F
APR 10, 49	F
FEB 7, 50	F
NOV 30, 50	F
JUL 27, 52	B M
MAY 26, 53	Y U
OCT 5, 53	Y U

A - Authorized

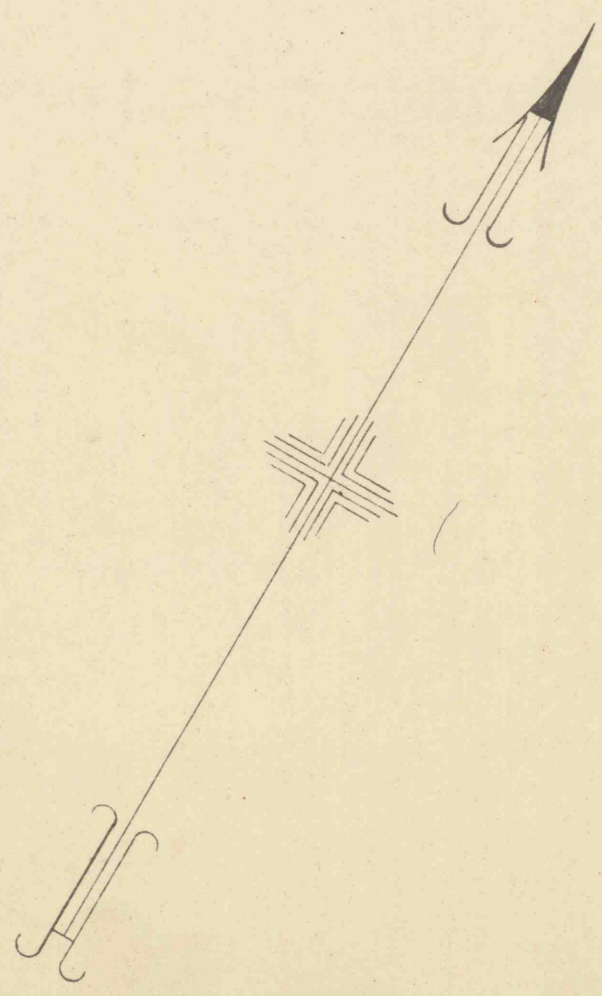

WOODWARD COLLIERY
FIVE FOOT VEIN
SCALE, 1 INCH = 400 FEET.