


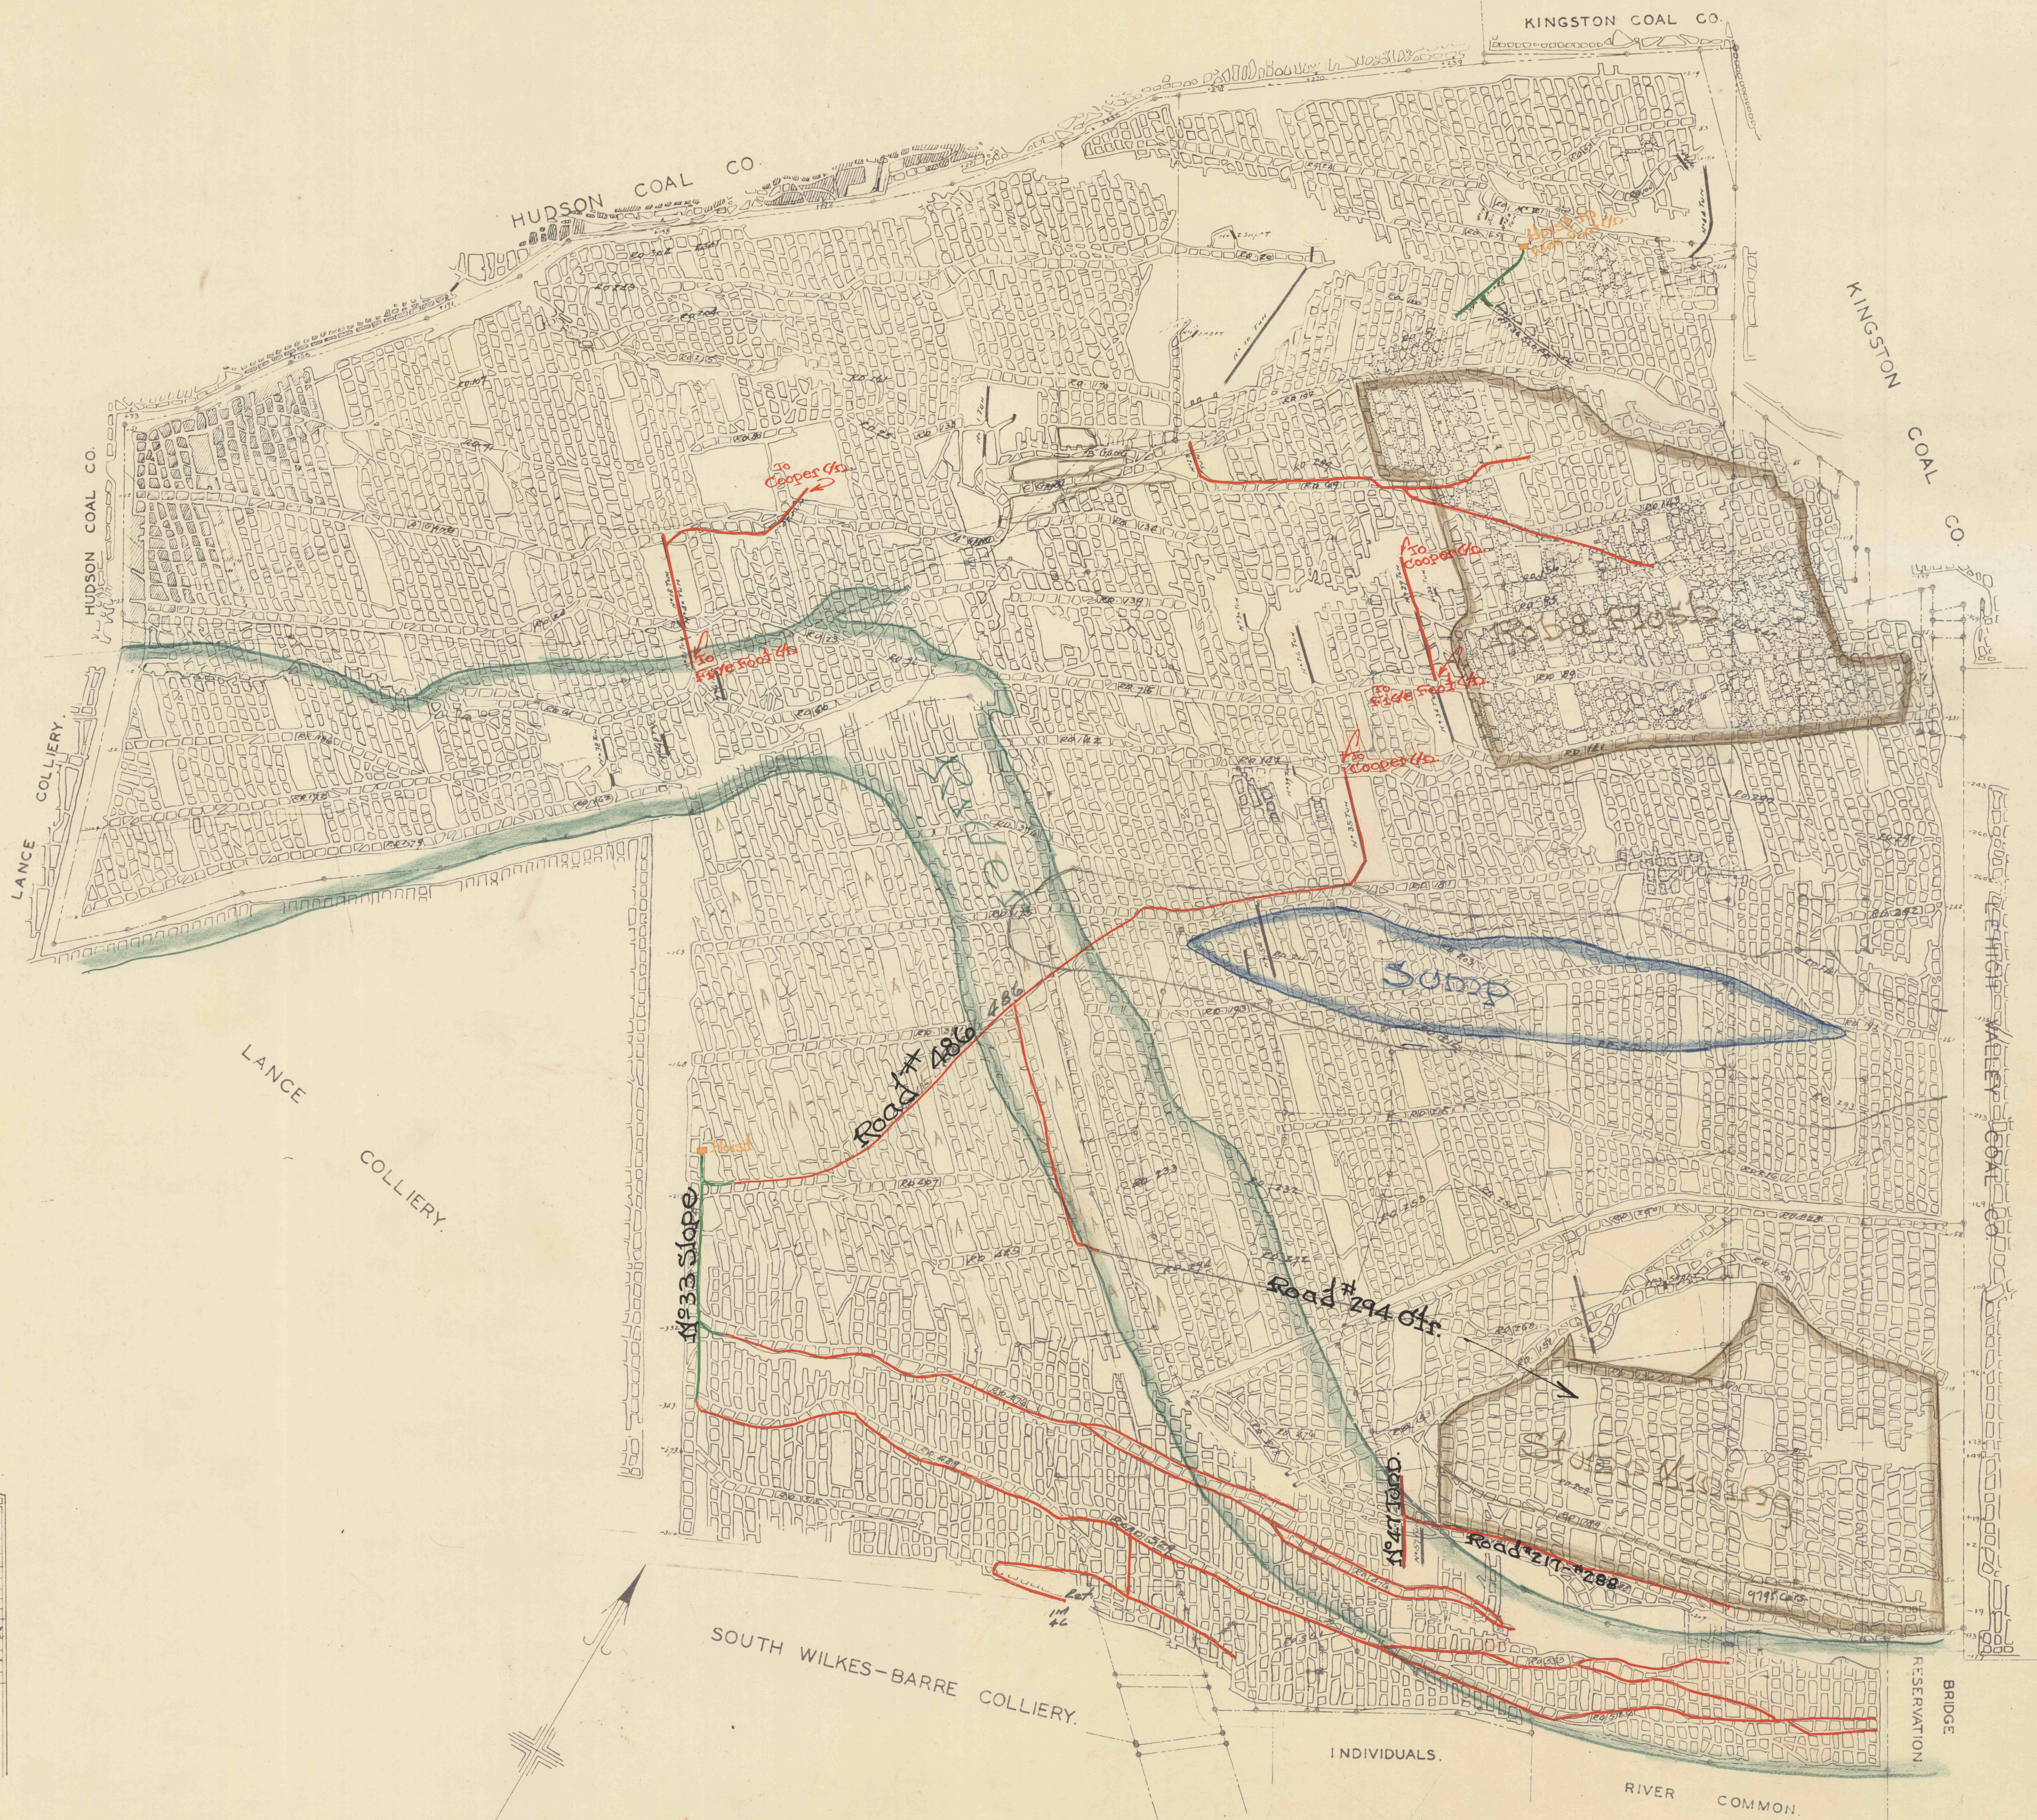

POSTED.

|             |         |
|-------------|---------|
| IN SERVICE  | JUNE 20 |
| APR 18, 40  | F       |
| NOV. 6, 42  | F       |
| APR 30, 45  | F       |
| MAY 10, 46  | F       |
| NOV 21, 47  | F       |
| AUG 3, 48   | F       |
| APR 22, 49  | F       |
| SEP. 4, 50  | F       |
| DEC. 1, 50  | F       |
| JULY 21, 52 | F       |
| MAY 21, 53  | F       |
| OCT. 5, 53  | F       |

WOODWARD LANCE VEIN  
 SCALE, 1 INCH = 400 FEET.