


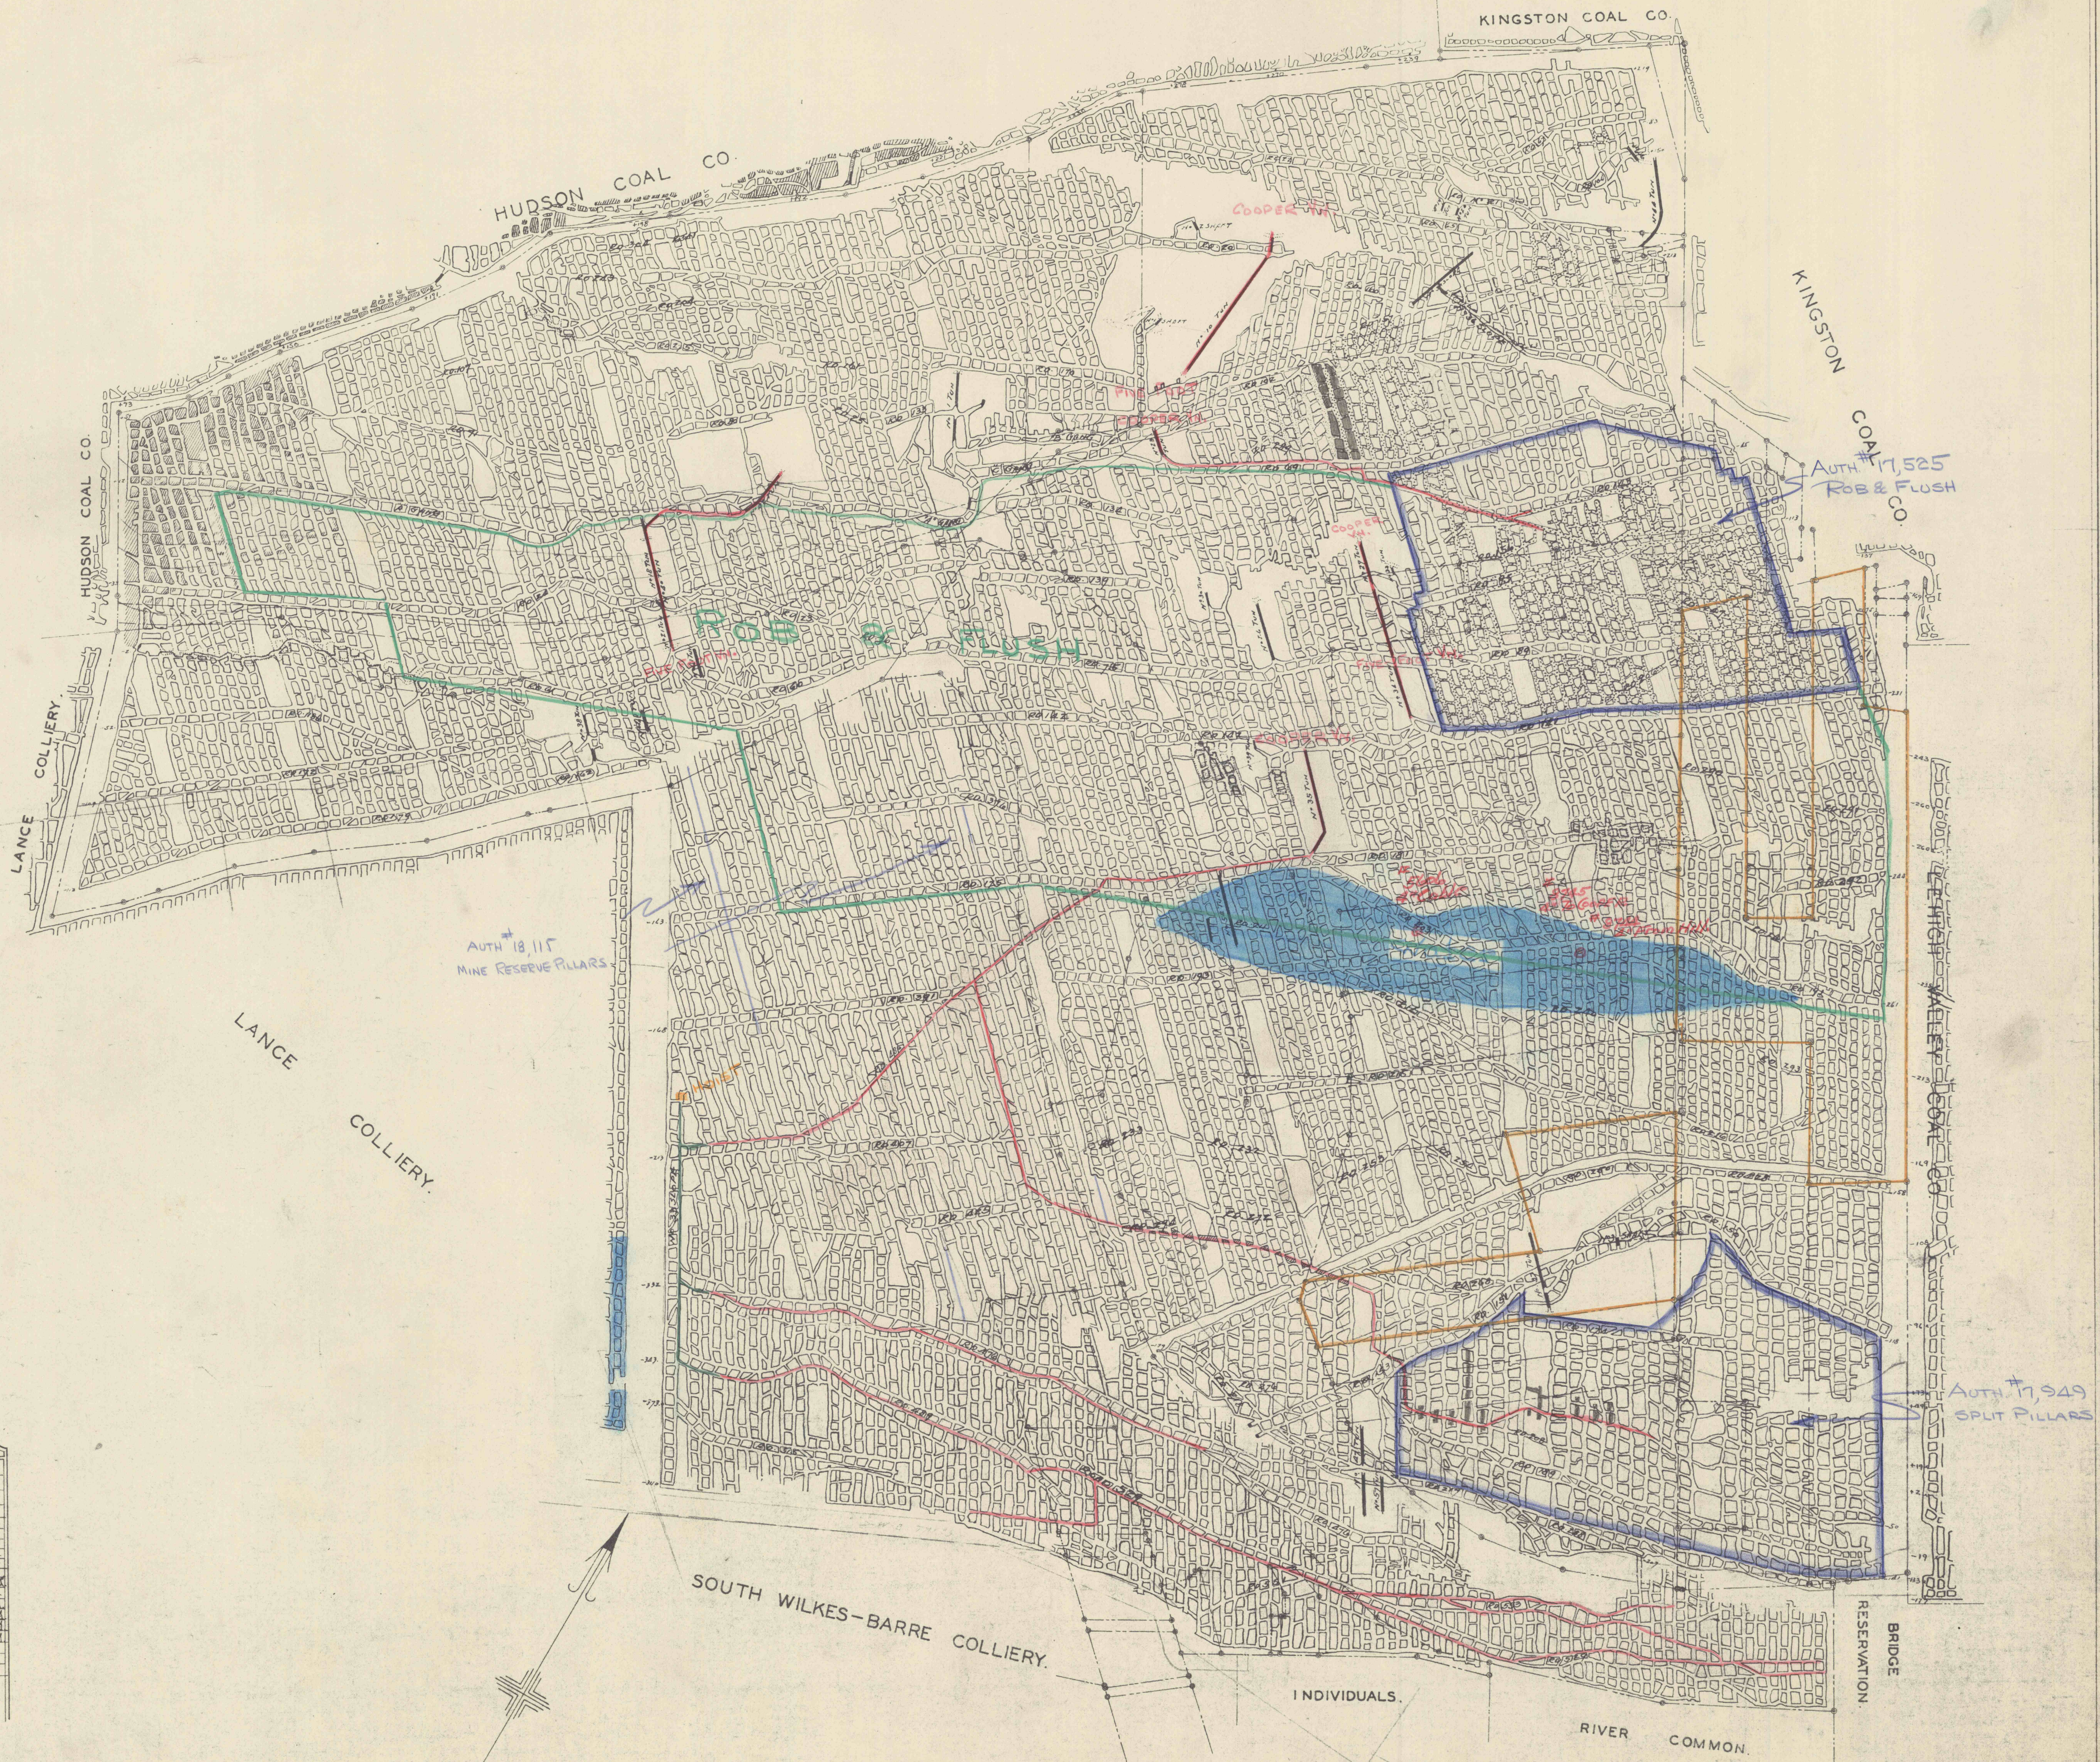

POSTED.

IN SERVICE JUNE 30.
APR. 18, 40. F.
MAY. 6, 43. F.
APR. 30, 45. F.
MAY. 6, 46. F.
MAY. 21, 47. F.
AUG. 3, 48. F.
APR. 20, 49. F.
FEB. 8, 50. F.
DEC. 1, 50. F.
MAY 29, 52. G.M.
MAY 27, 53. V.I.
OCT. 5, 53. G.M.
MARCH 30, 54. G.M.
MARCH 10, 55. G.M.
FEB. 2, 56. G.M.

WOODWARD COLLIERY
LANCE VEIN
SCALE, 1 INCH = 400 FEET.