


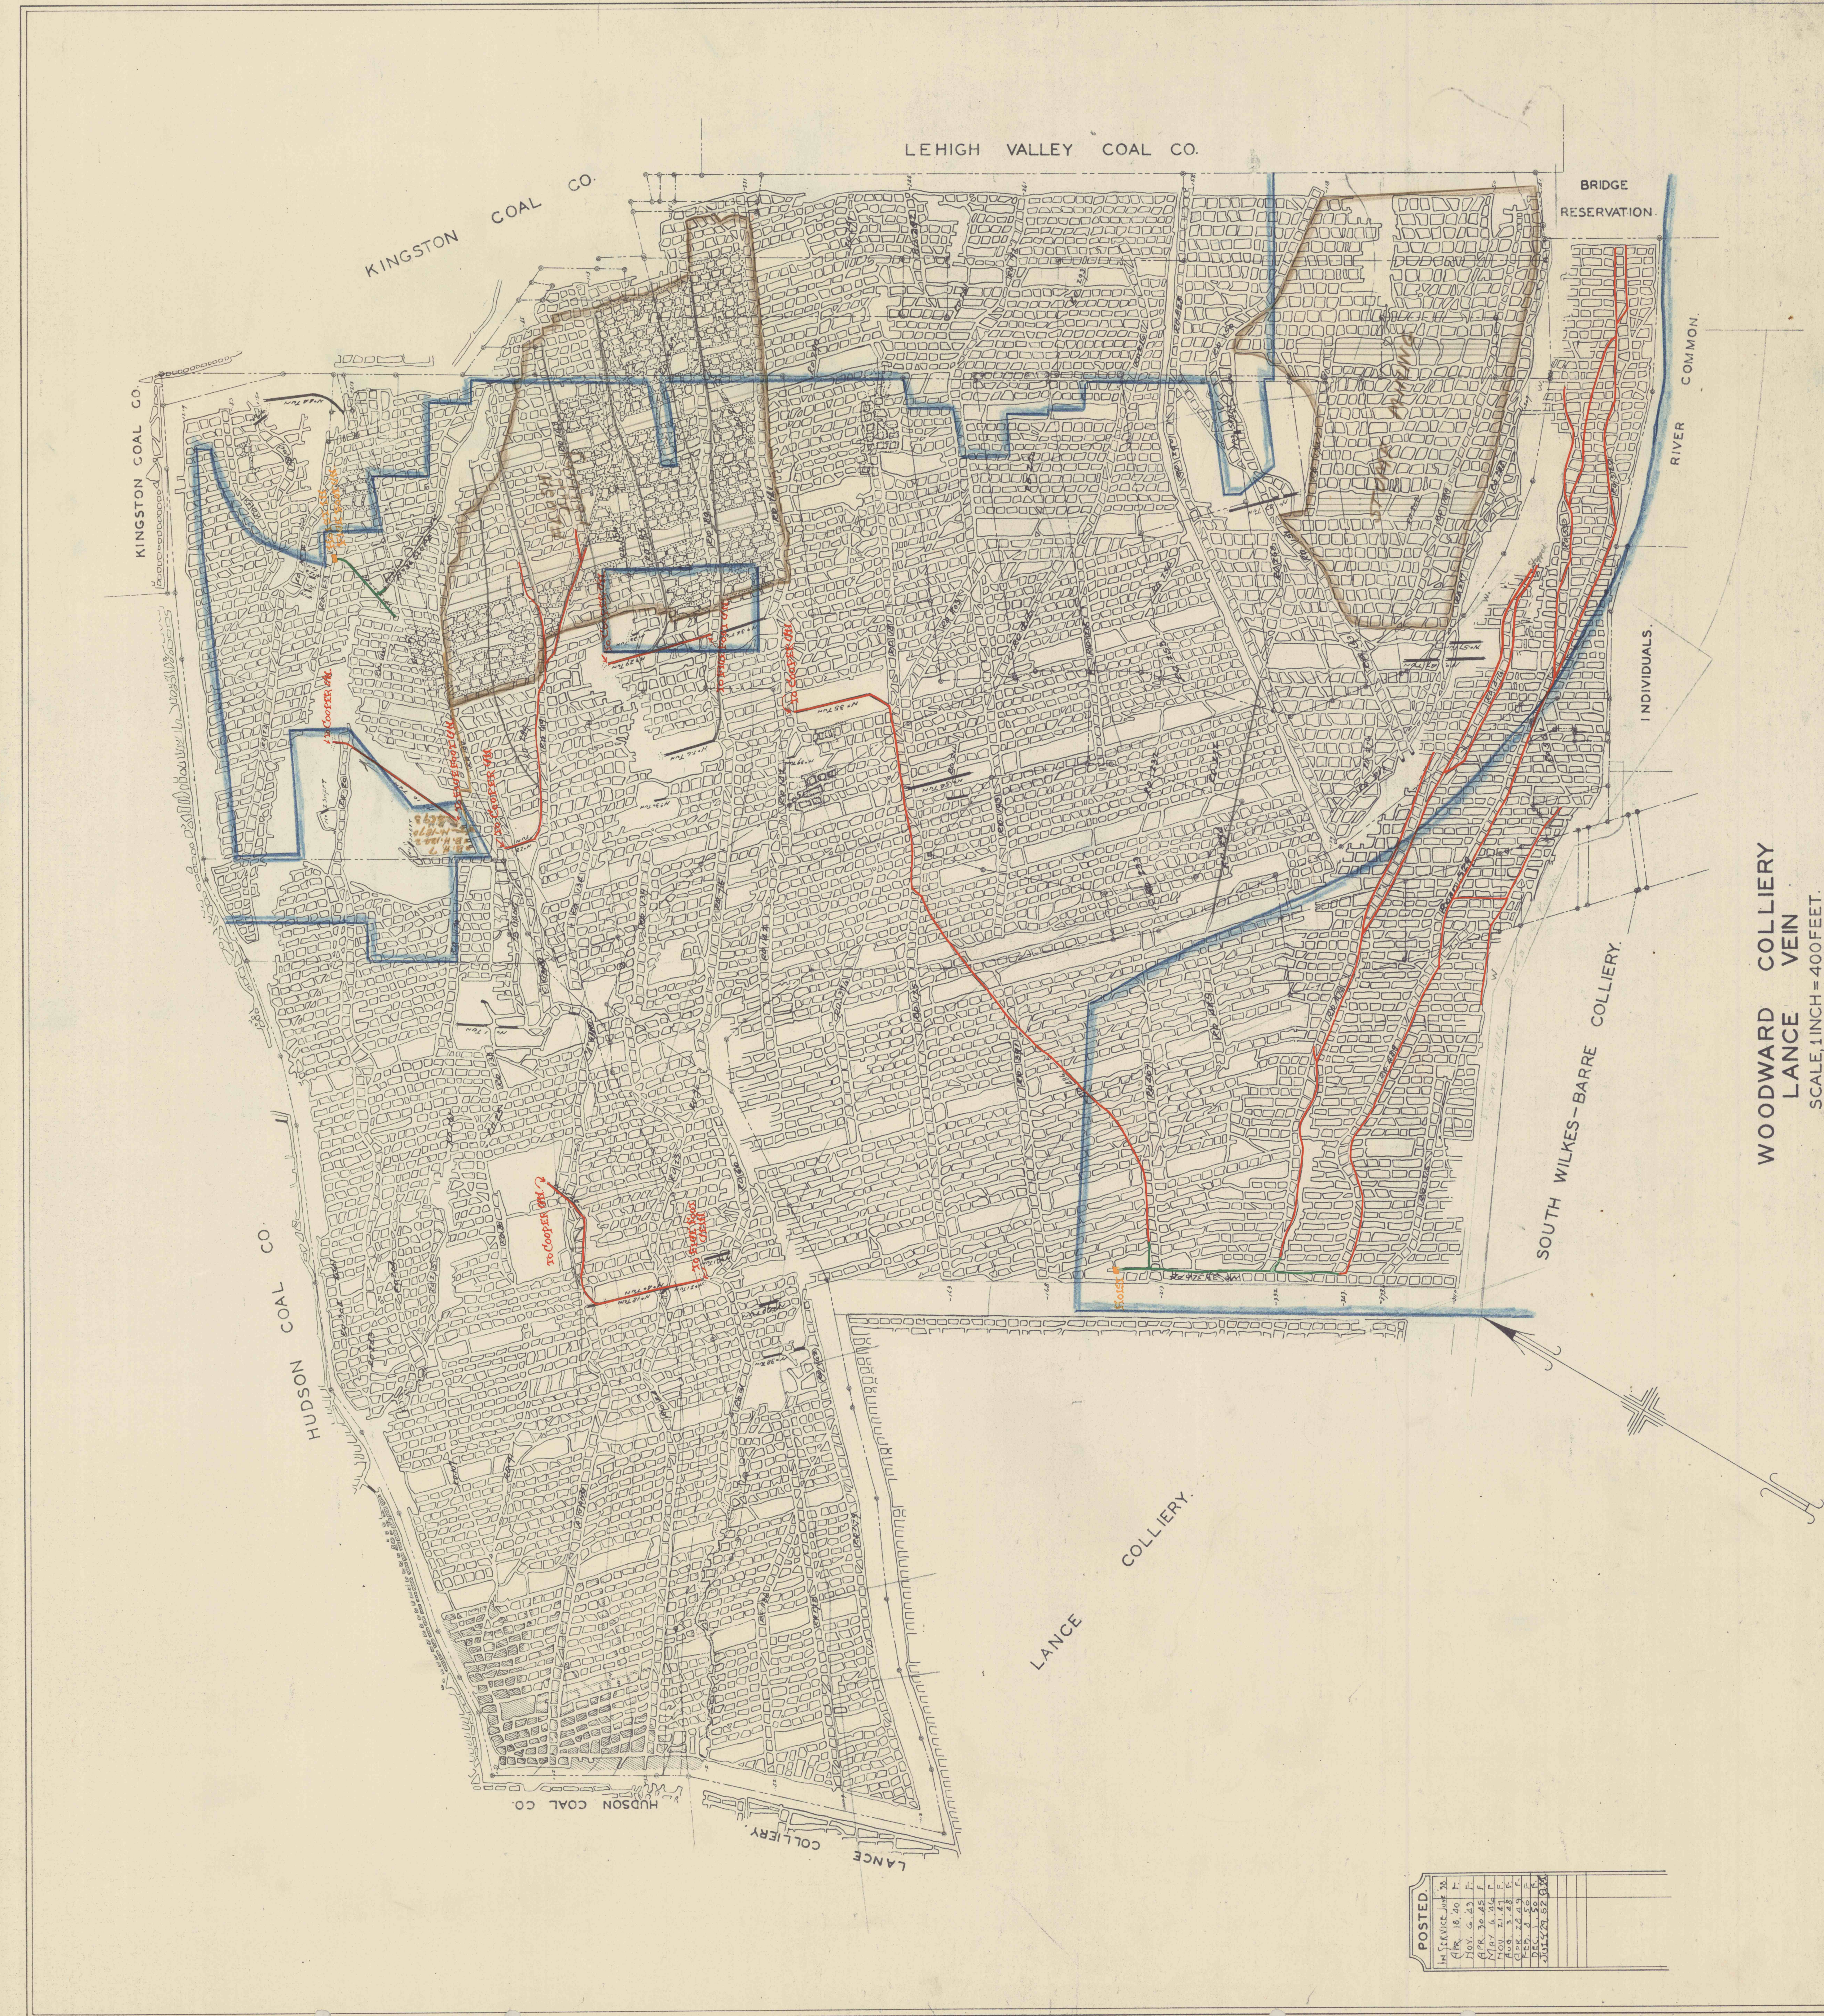

POSTED	
