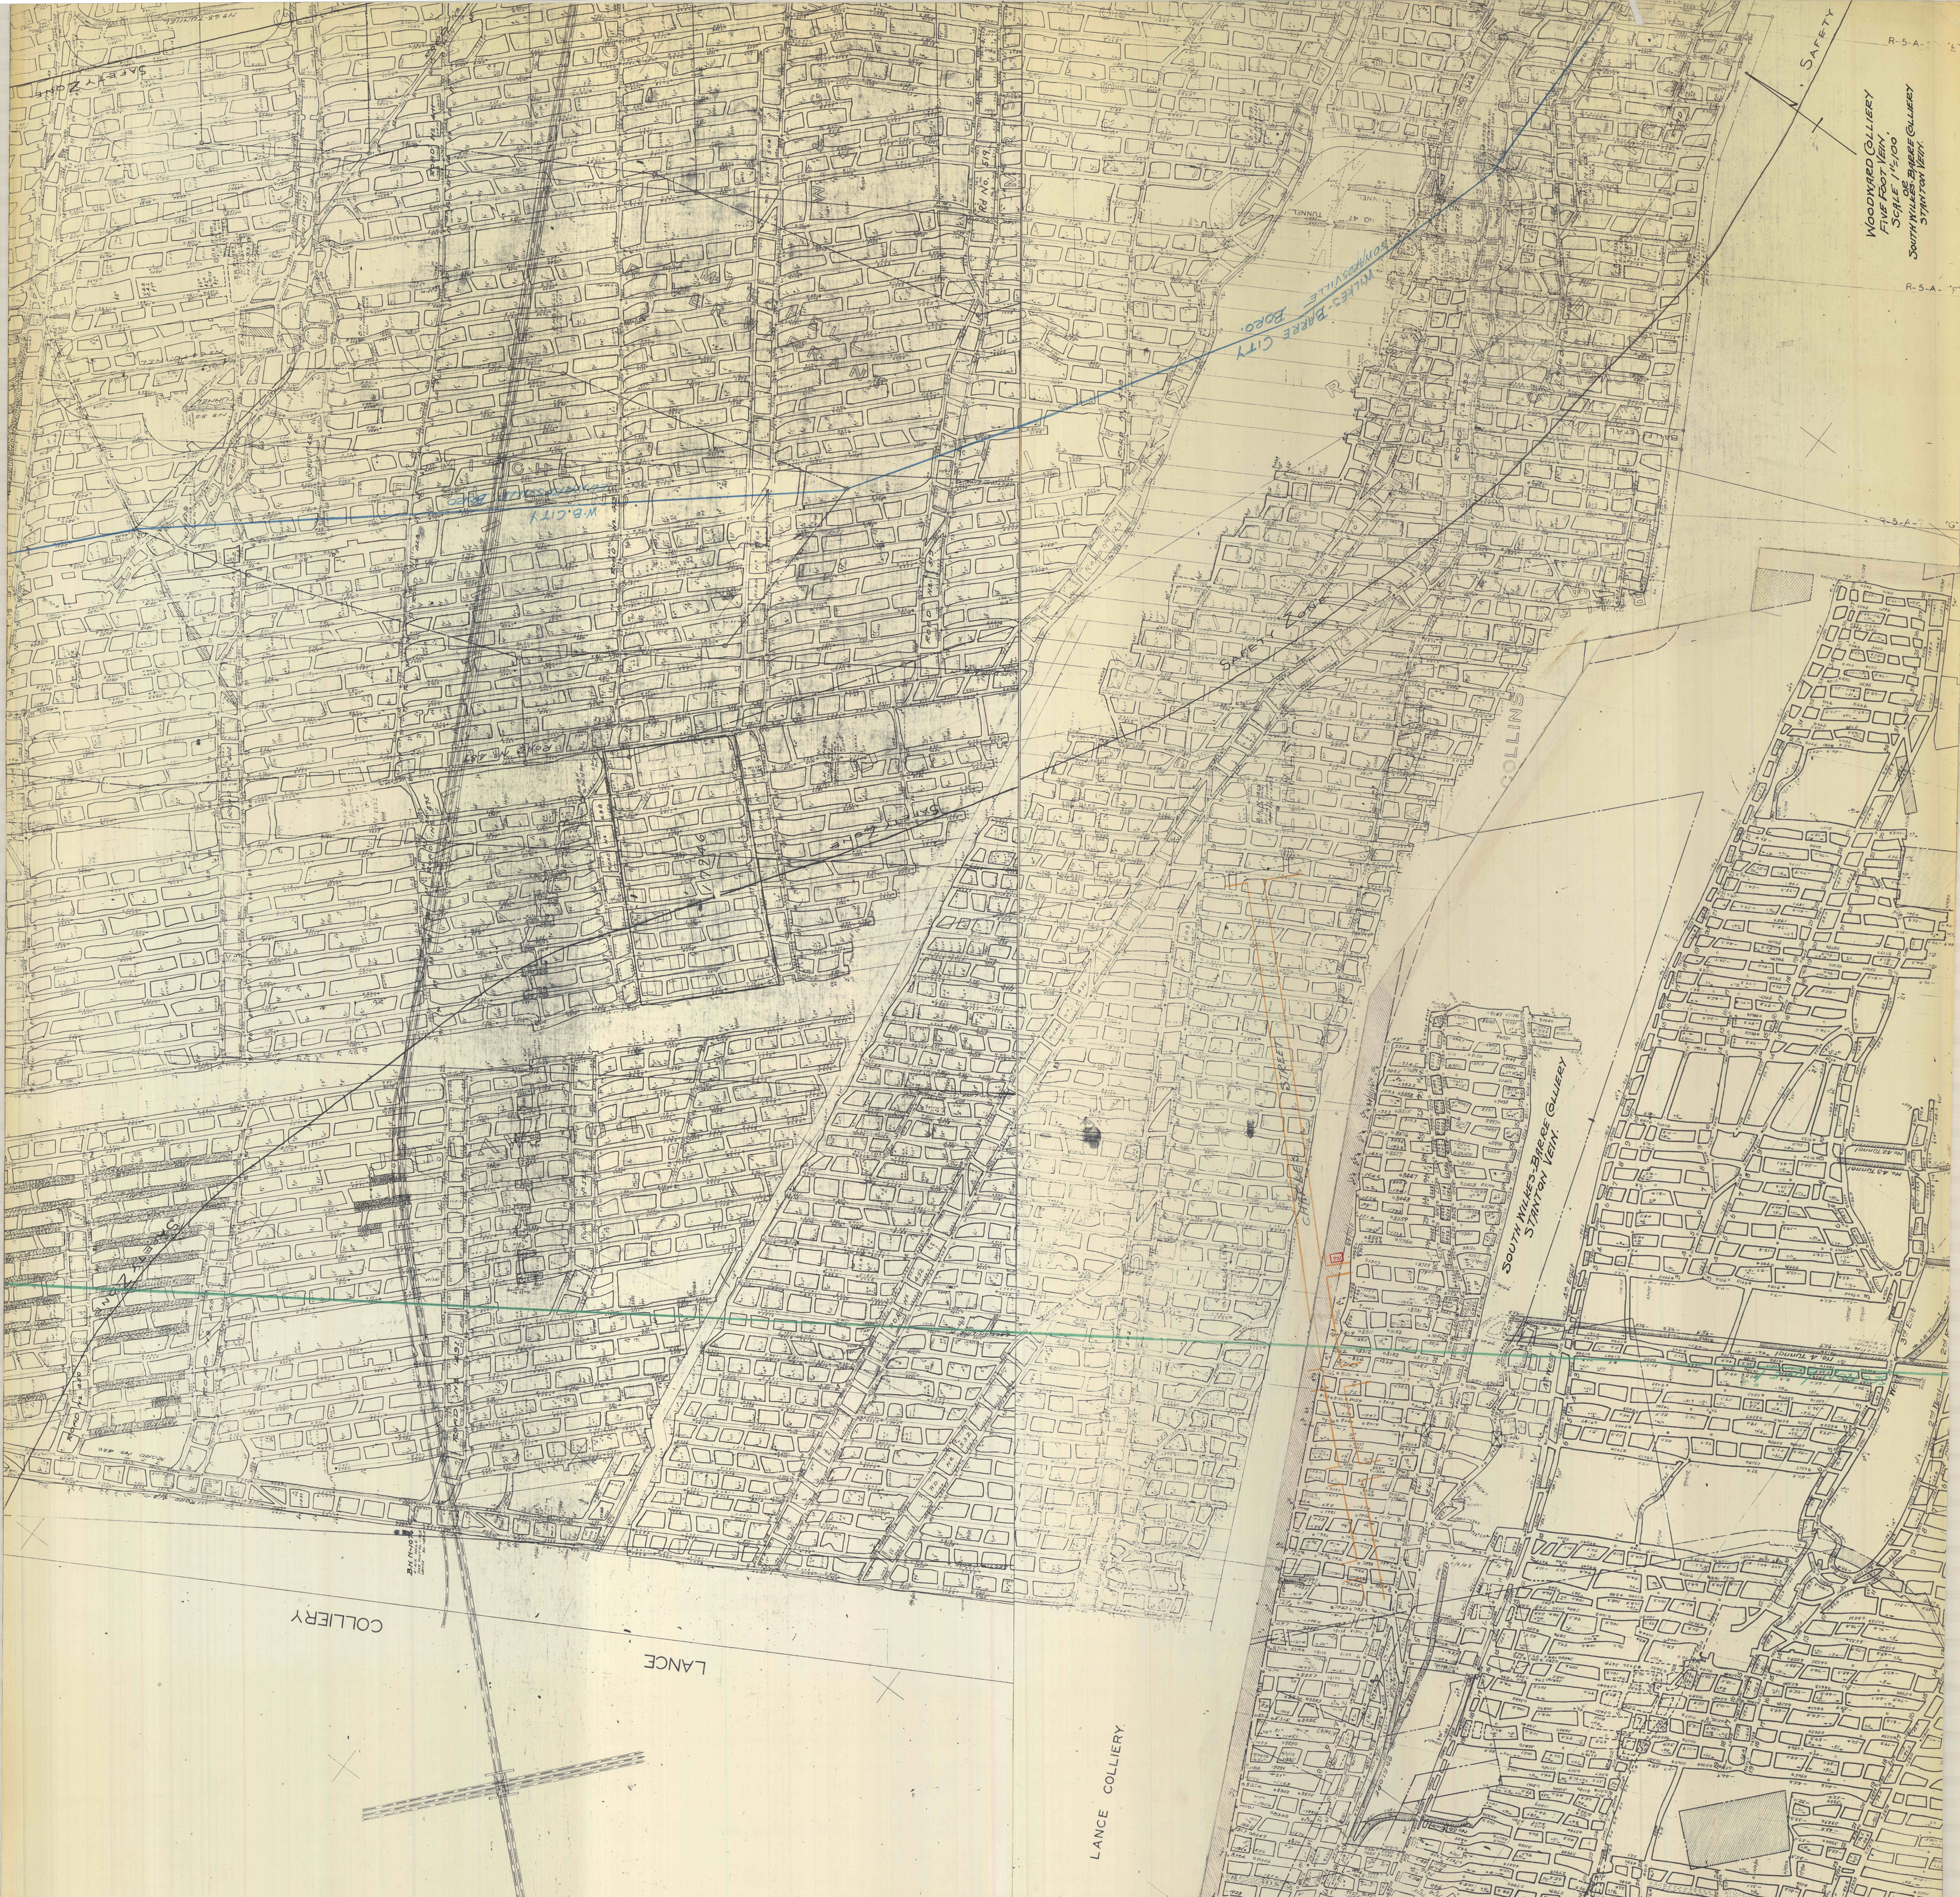
WOODWARD COLLIERY
FIVE FOOT VEIN.
SCALE 1"=100
OR
SOUTH WILKES-BARRE COLLIERY
STANTON VEIN.
SAFETY ZONE
SAFETY
No 65 TUNNEL
No 55 TUNNEL
MITCHELL
W.B. CITY
EDWARDSVILLE BORO.
WILKES-BARRE CITY
TUNNEL
NO. 47
ROAD No. 487
ROAD No. 523
ROAD No. 502
ROAD No. 432
ROAD No. 532
ROAD No. 491
ROAD No. 450
ROAD No. 420
SECTION LINE
COLLINS
CHARLES STREET
SOUTH WILKES-BARRE COLLIERY
STANTON VEIN.
No. 4 Tunnel
No. 42 Tunnel
No. 43 Tunnel
No. 56 Tunnel
4th East
4th West
3rd East
3rd West
2nd West
R-5-A "E"
R-5-A "F"
R-5-A-7 "G"
LANCE COLLIERY
LANCE
COLLIERY
B.H. No. 1076
AIR HOLE