


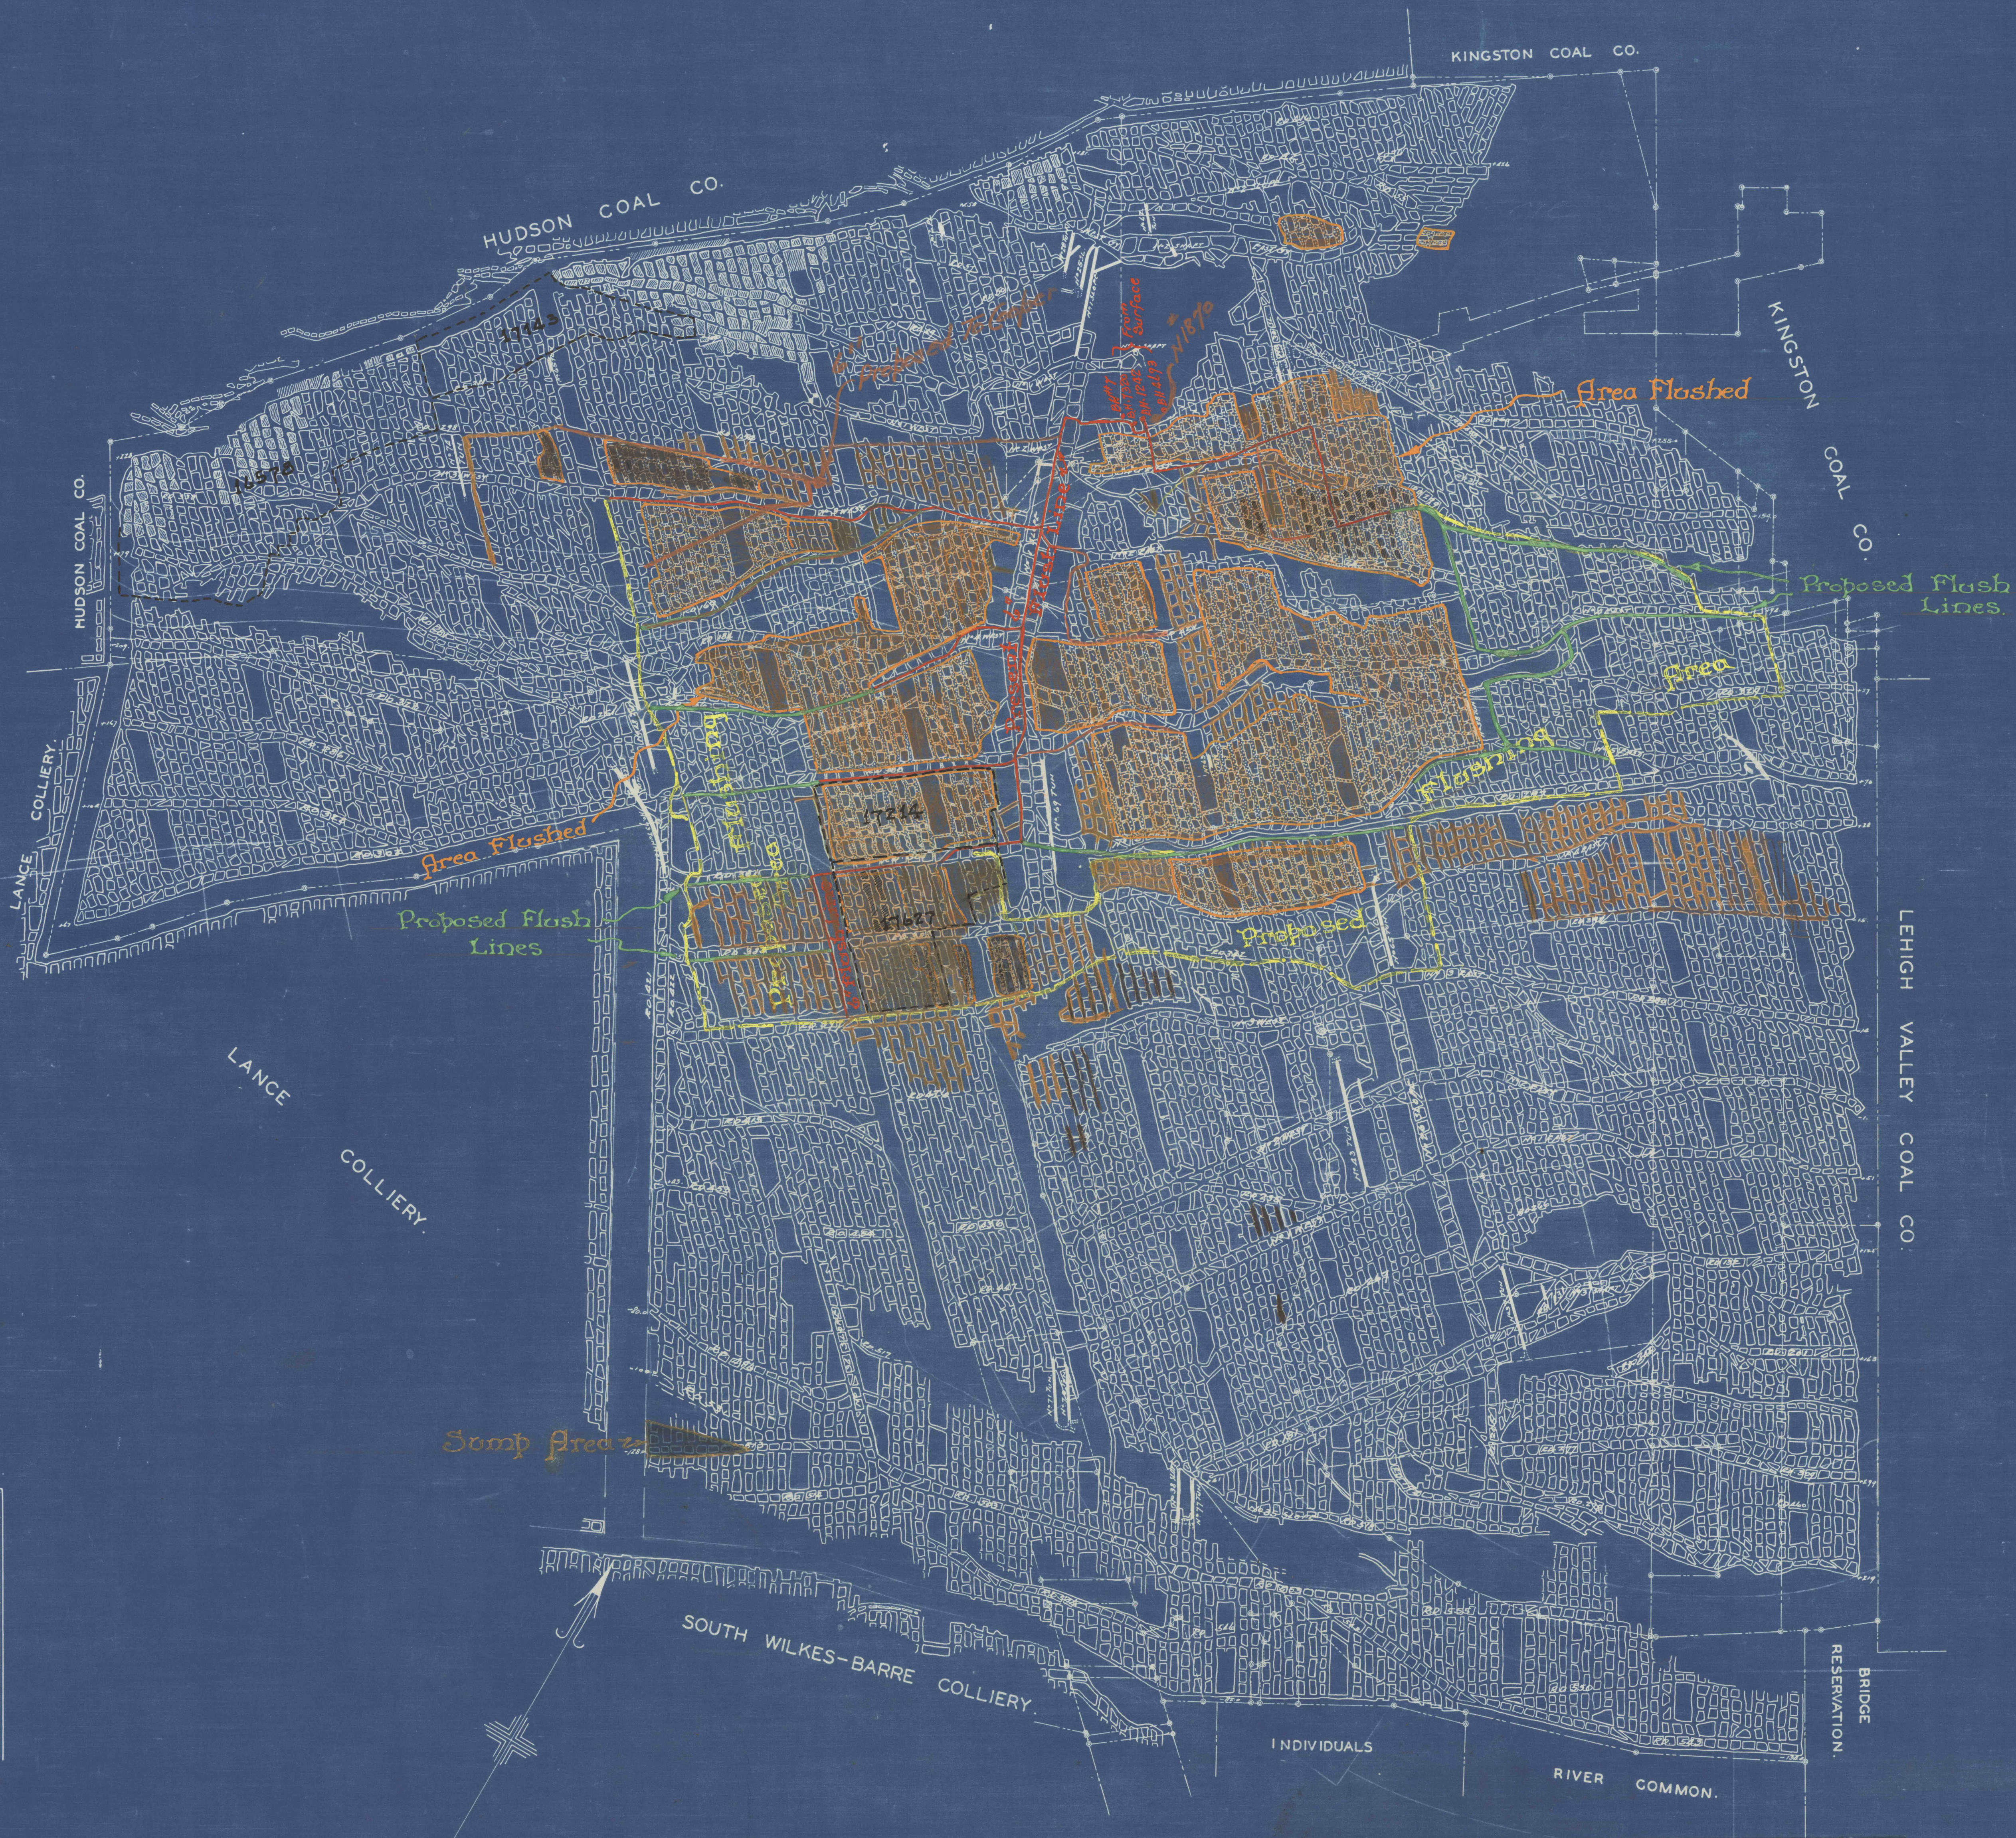

WOODWARD COLLIERY
HILLMAN VEIN
SCALE, 1 INCH = 400 FEET.

POSTED	
In Service June 30	
Apr. 17, 40	F.
May 3, 42	F.
Apr. 27, 45	F.
May 8, 46	F.
May 19, 47	F.
May 29, 48	F.
Apr. 27, 49	F.

LEGEND	
	PRESENT 6" FLUSH LINES.
	PROPOSED 6" FLUSH LINES.
	AREAS FLUSHED.
	AREAS ROCK PACKED.
	AREAS ROCK PACKED, AND LATER FLUSHED.
	PROPOSED FLUSHING AREAS OUTLINED.
	PROPOSED WATER COURSES.