


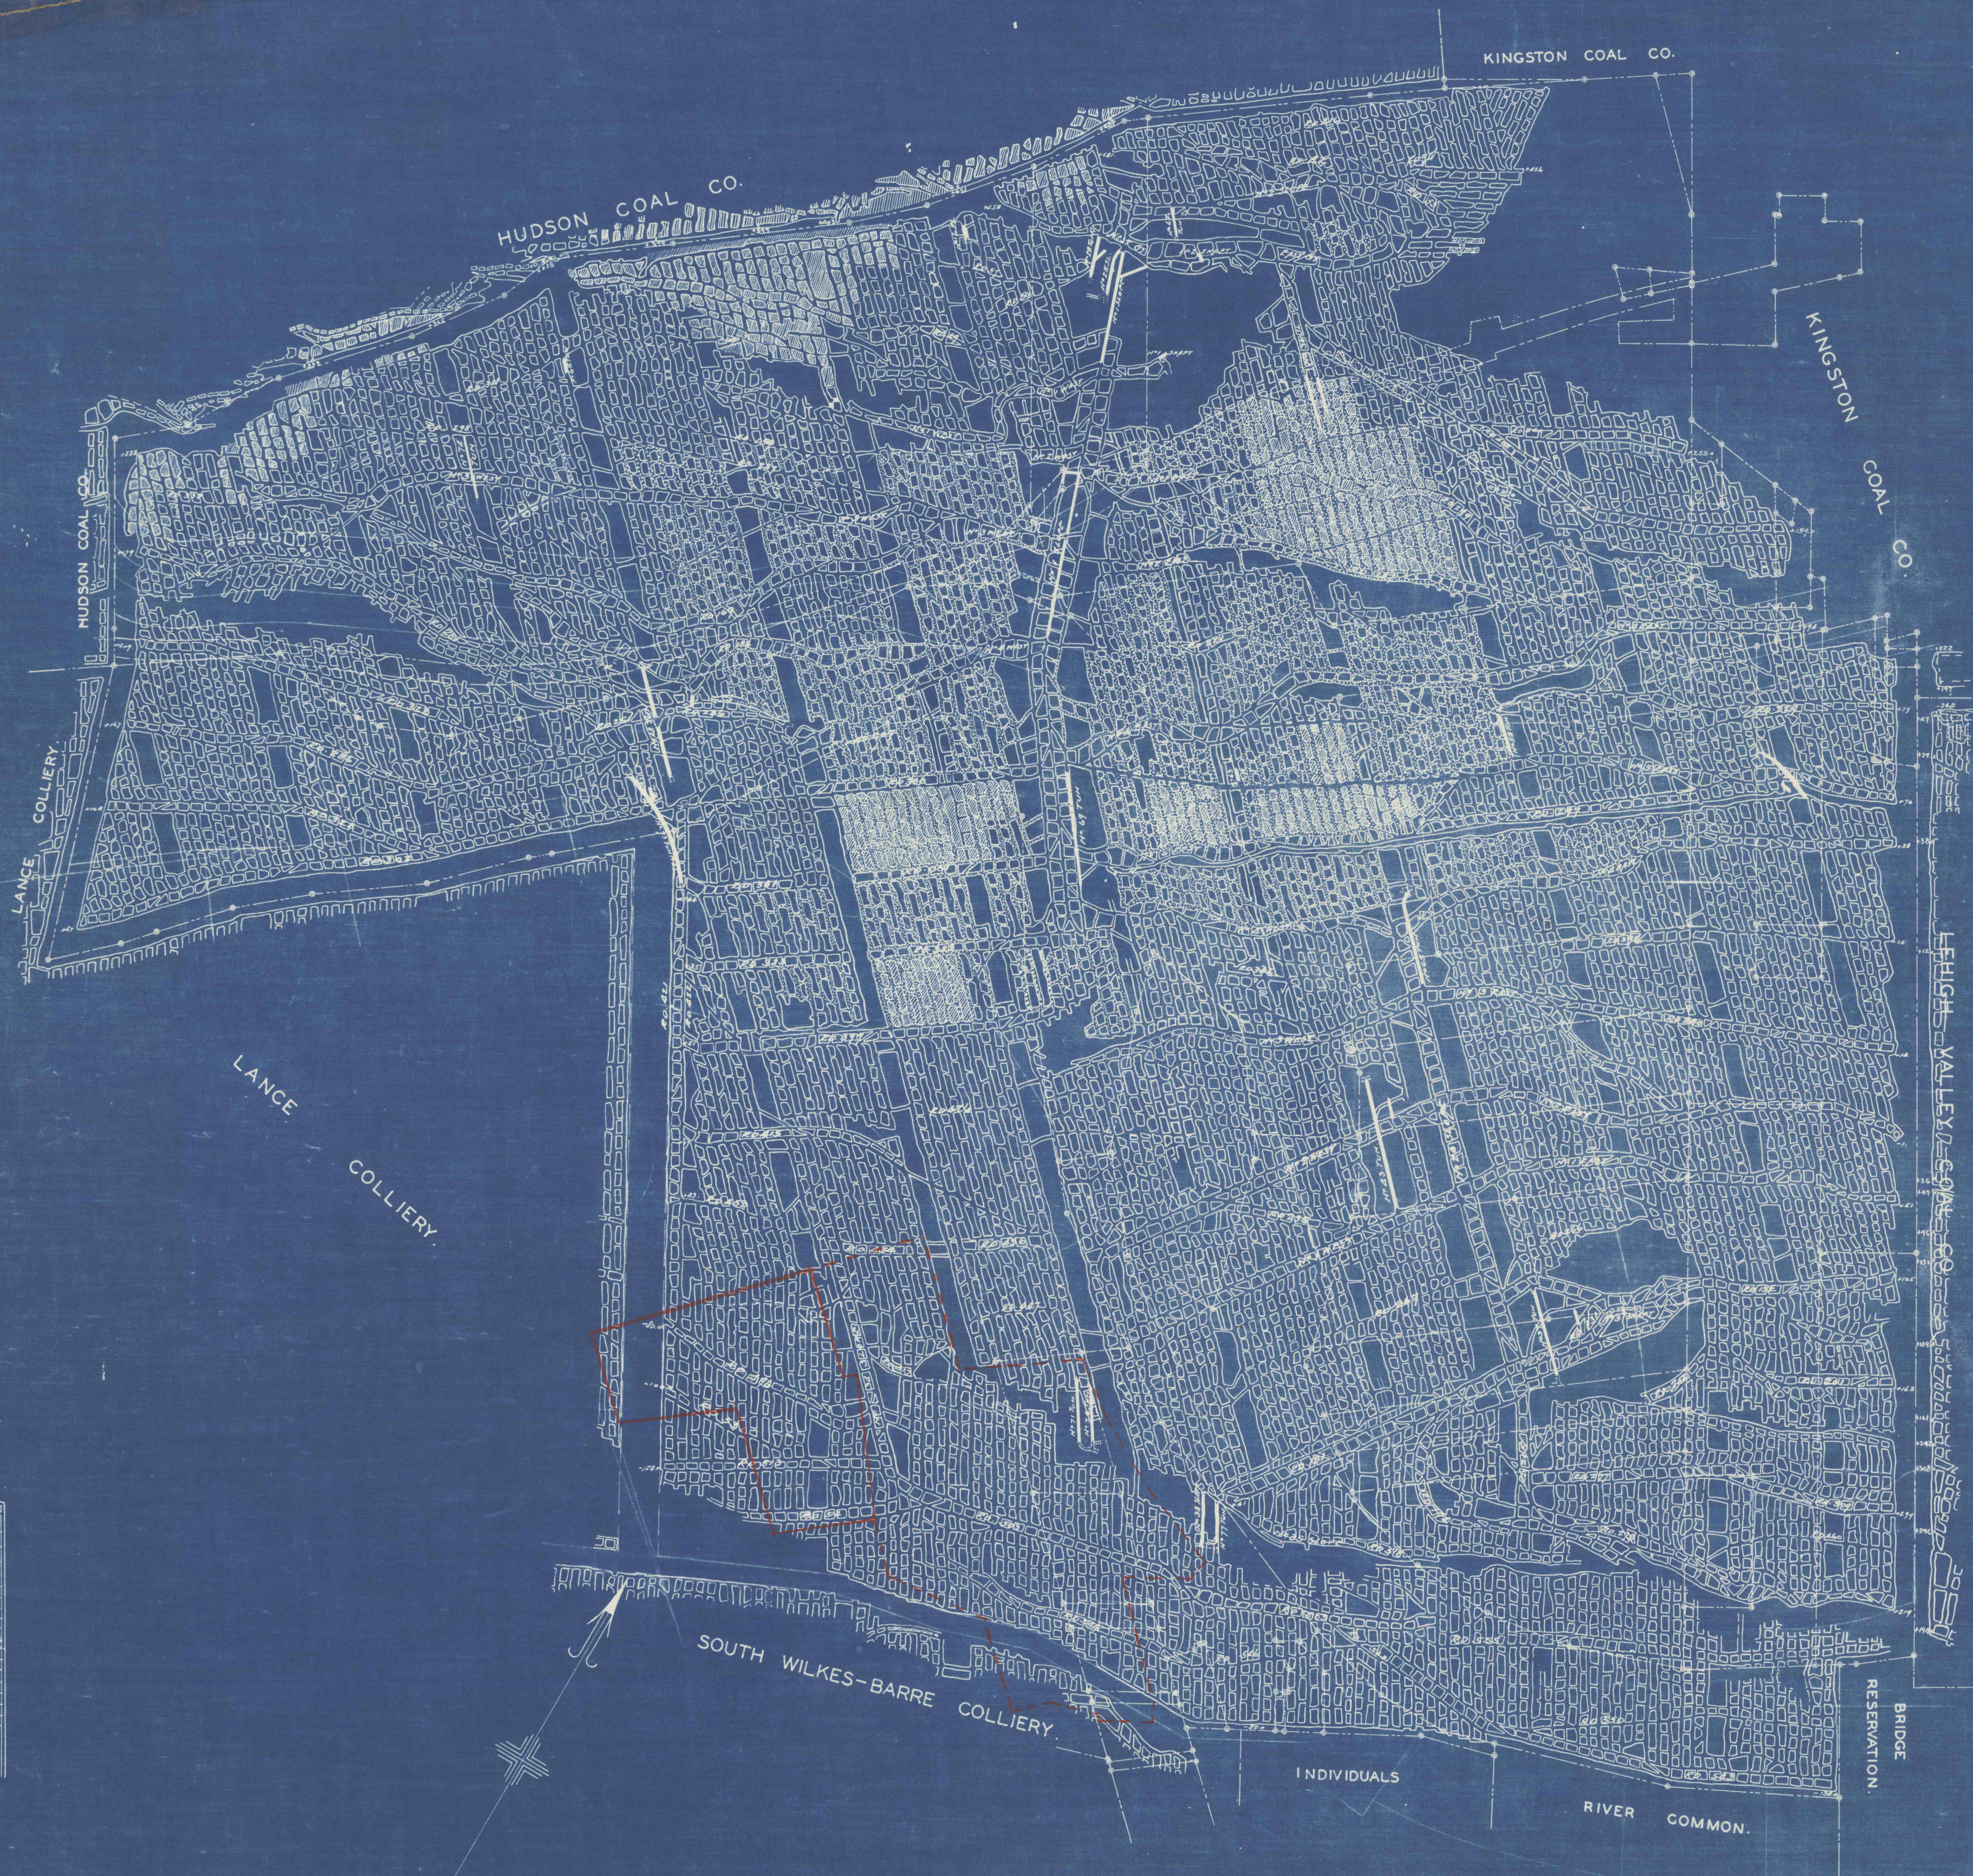

POSTED.	
IN SERVICE	JUN 30
APR 17	40 F
MAY 3	42 F
JUN 27	45 F
MAY 8	46 F
MAY 19	47 F
JULY 29	48 F
AUG 29	49 F
SEP 23	50 F
MAY 26	52 F
OCT 2	53 F

WOODWARD COLLIERY
HILLMAN VEIN
SCALE, 1 INCH = 400 FEET.