


POSTED.
 In Service June 30
 Apr. 18, '40 F.
 Nov. 6, '43 F.
 May 1, '45 F.

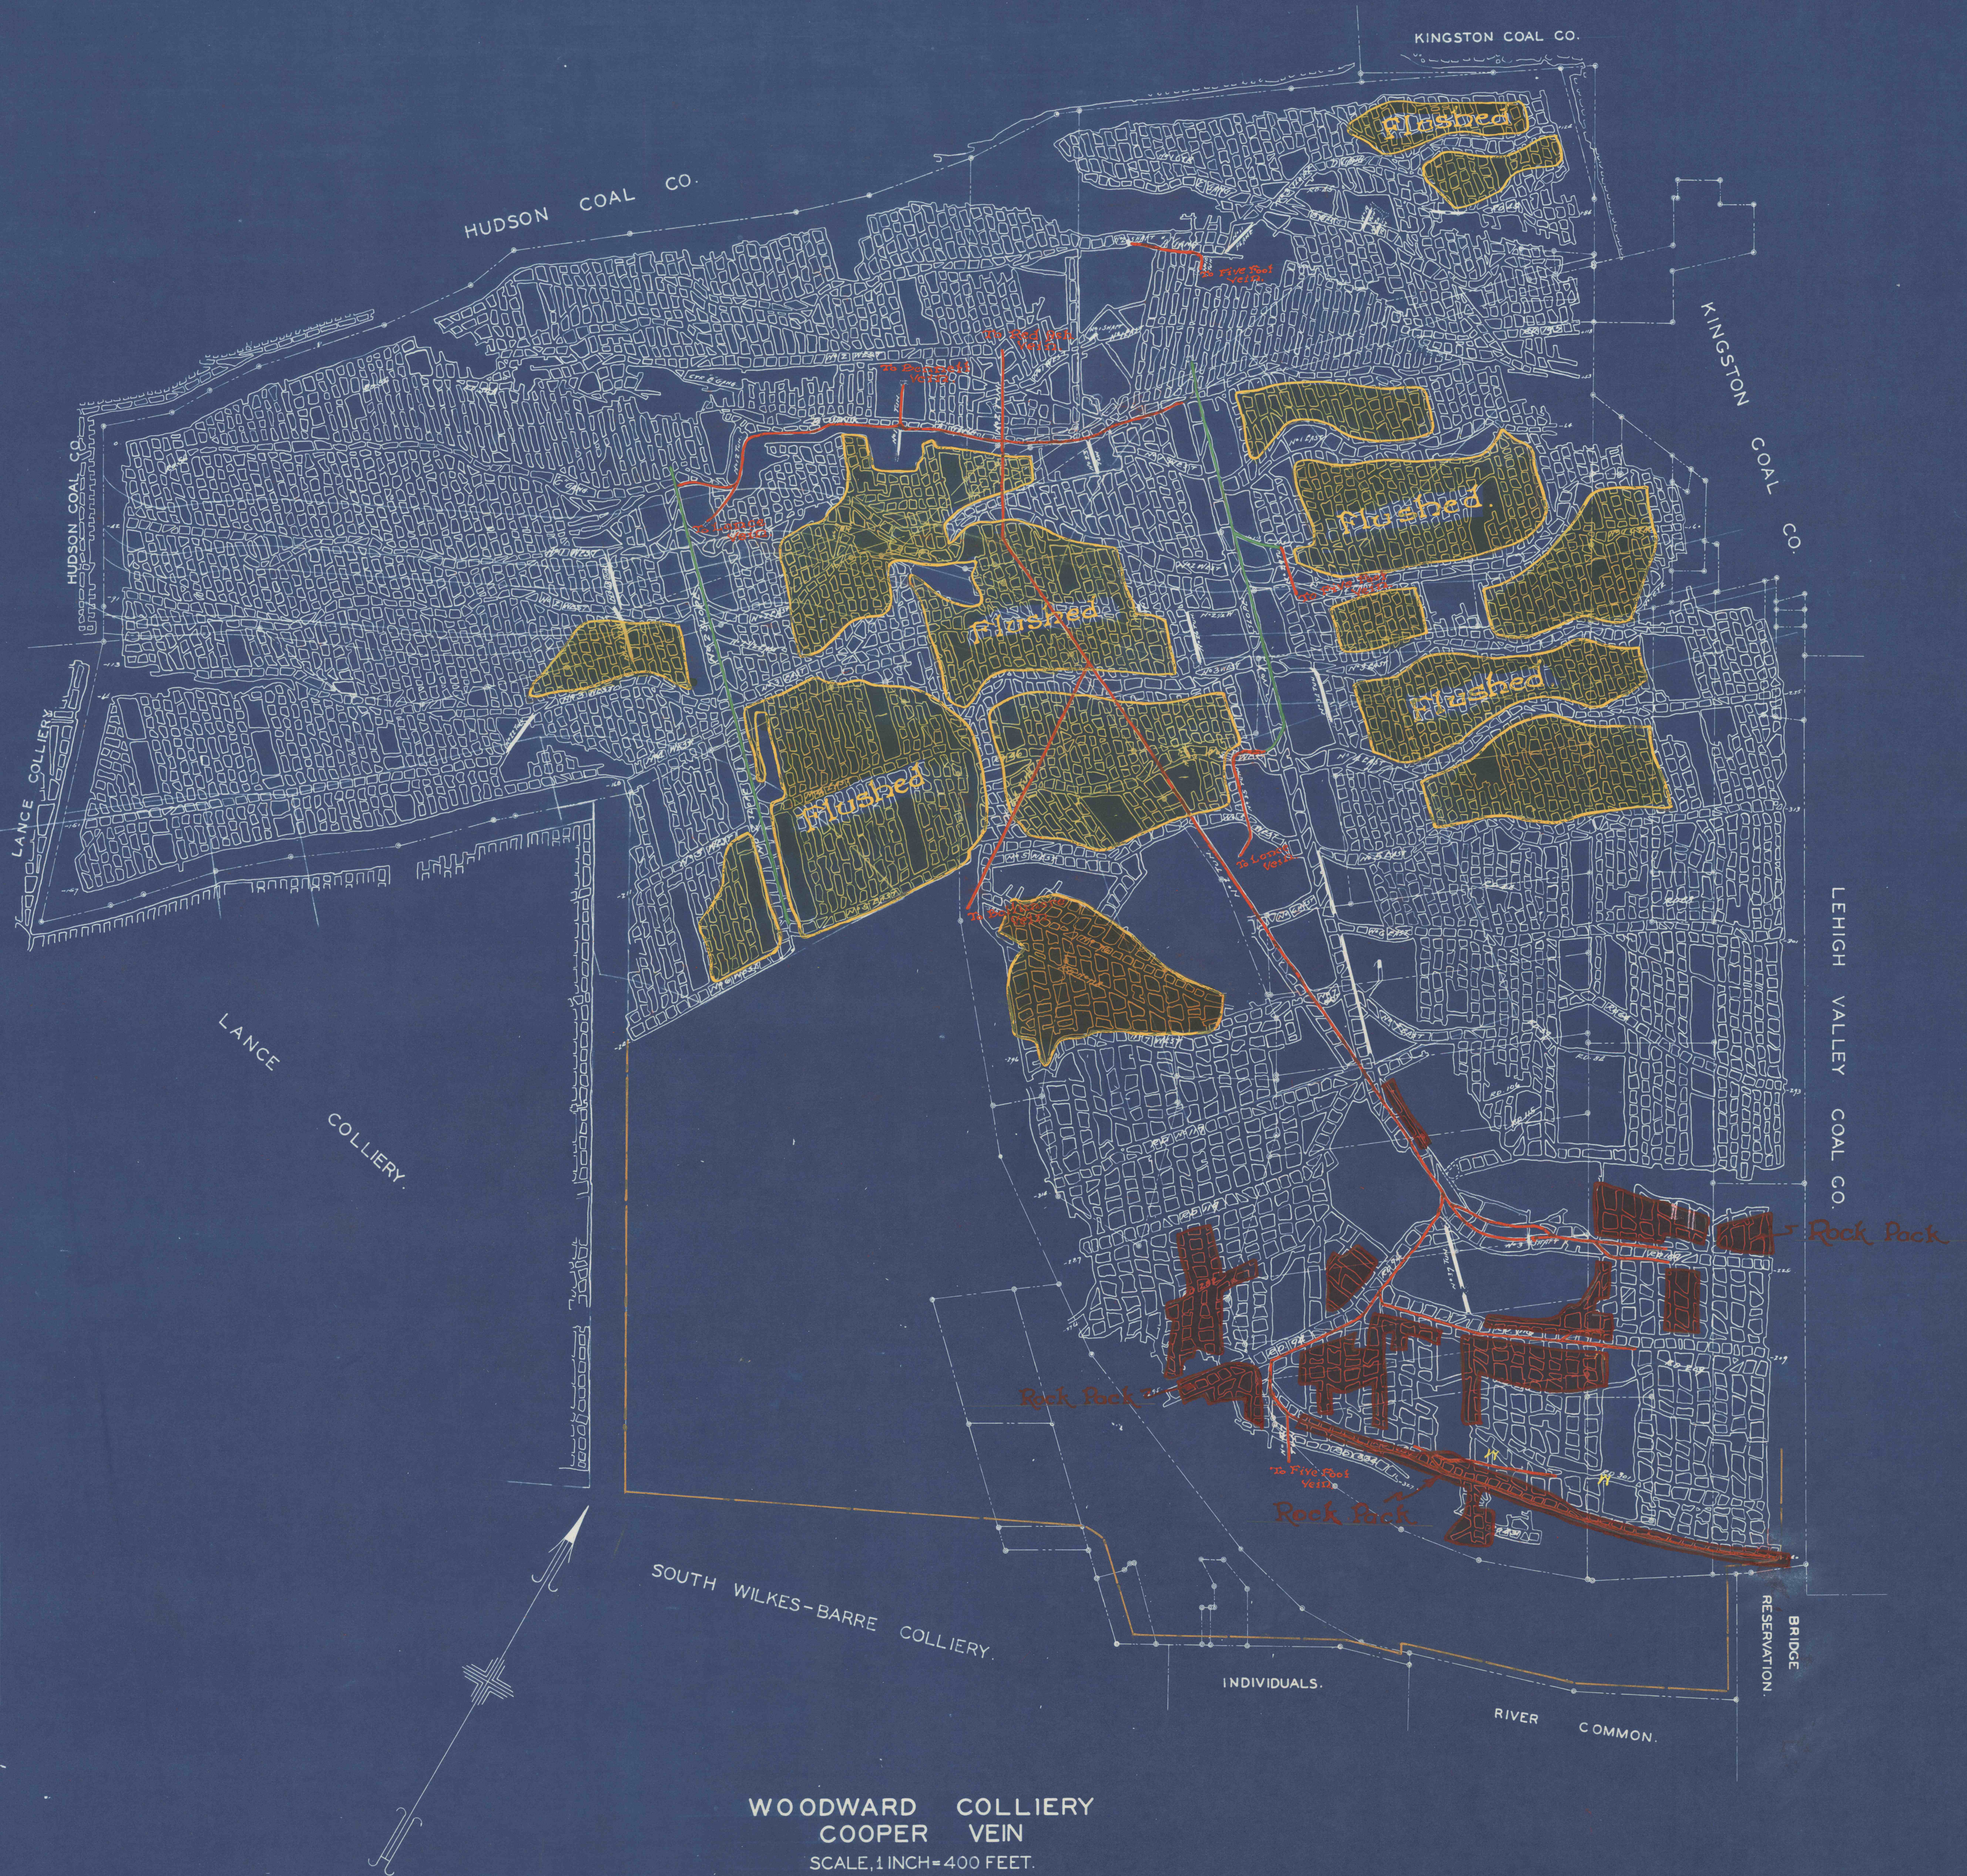

WOODWARD COLLIERY
 COOPER VEIN
 SCALE, 1 INCH = 400 FEET.