


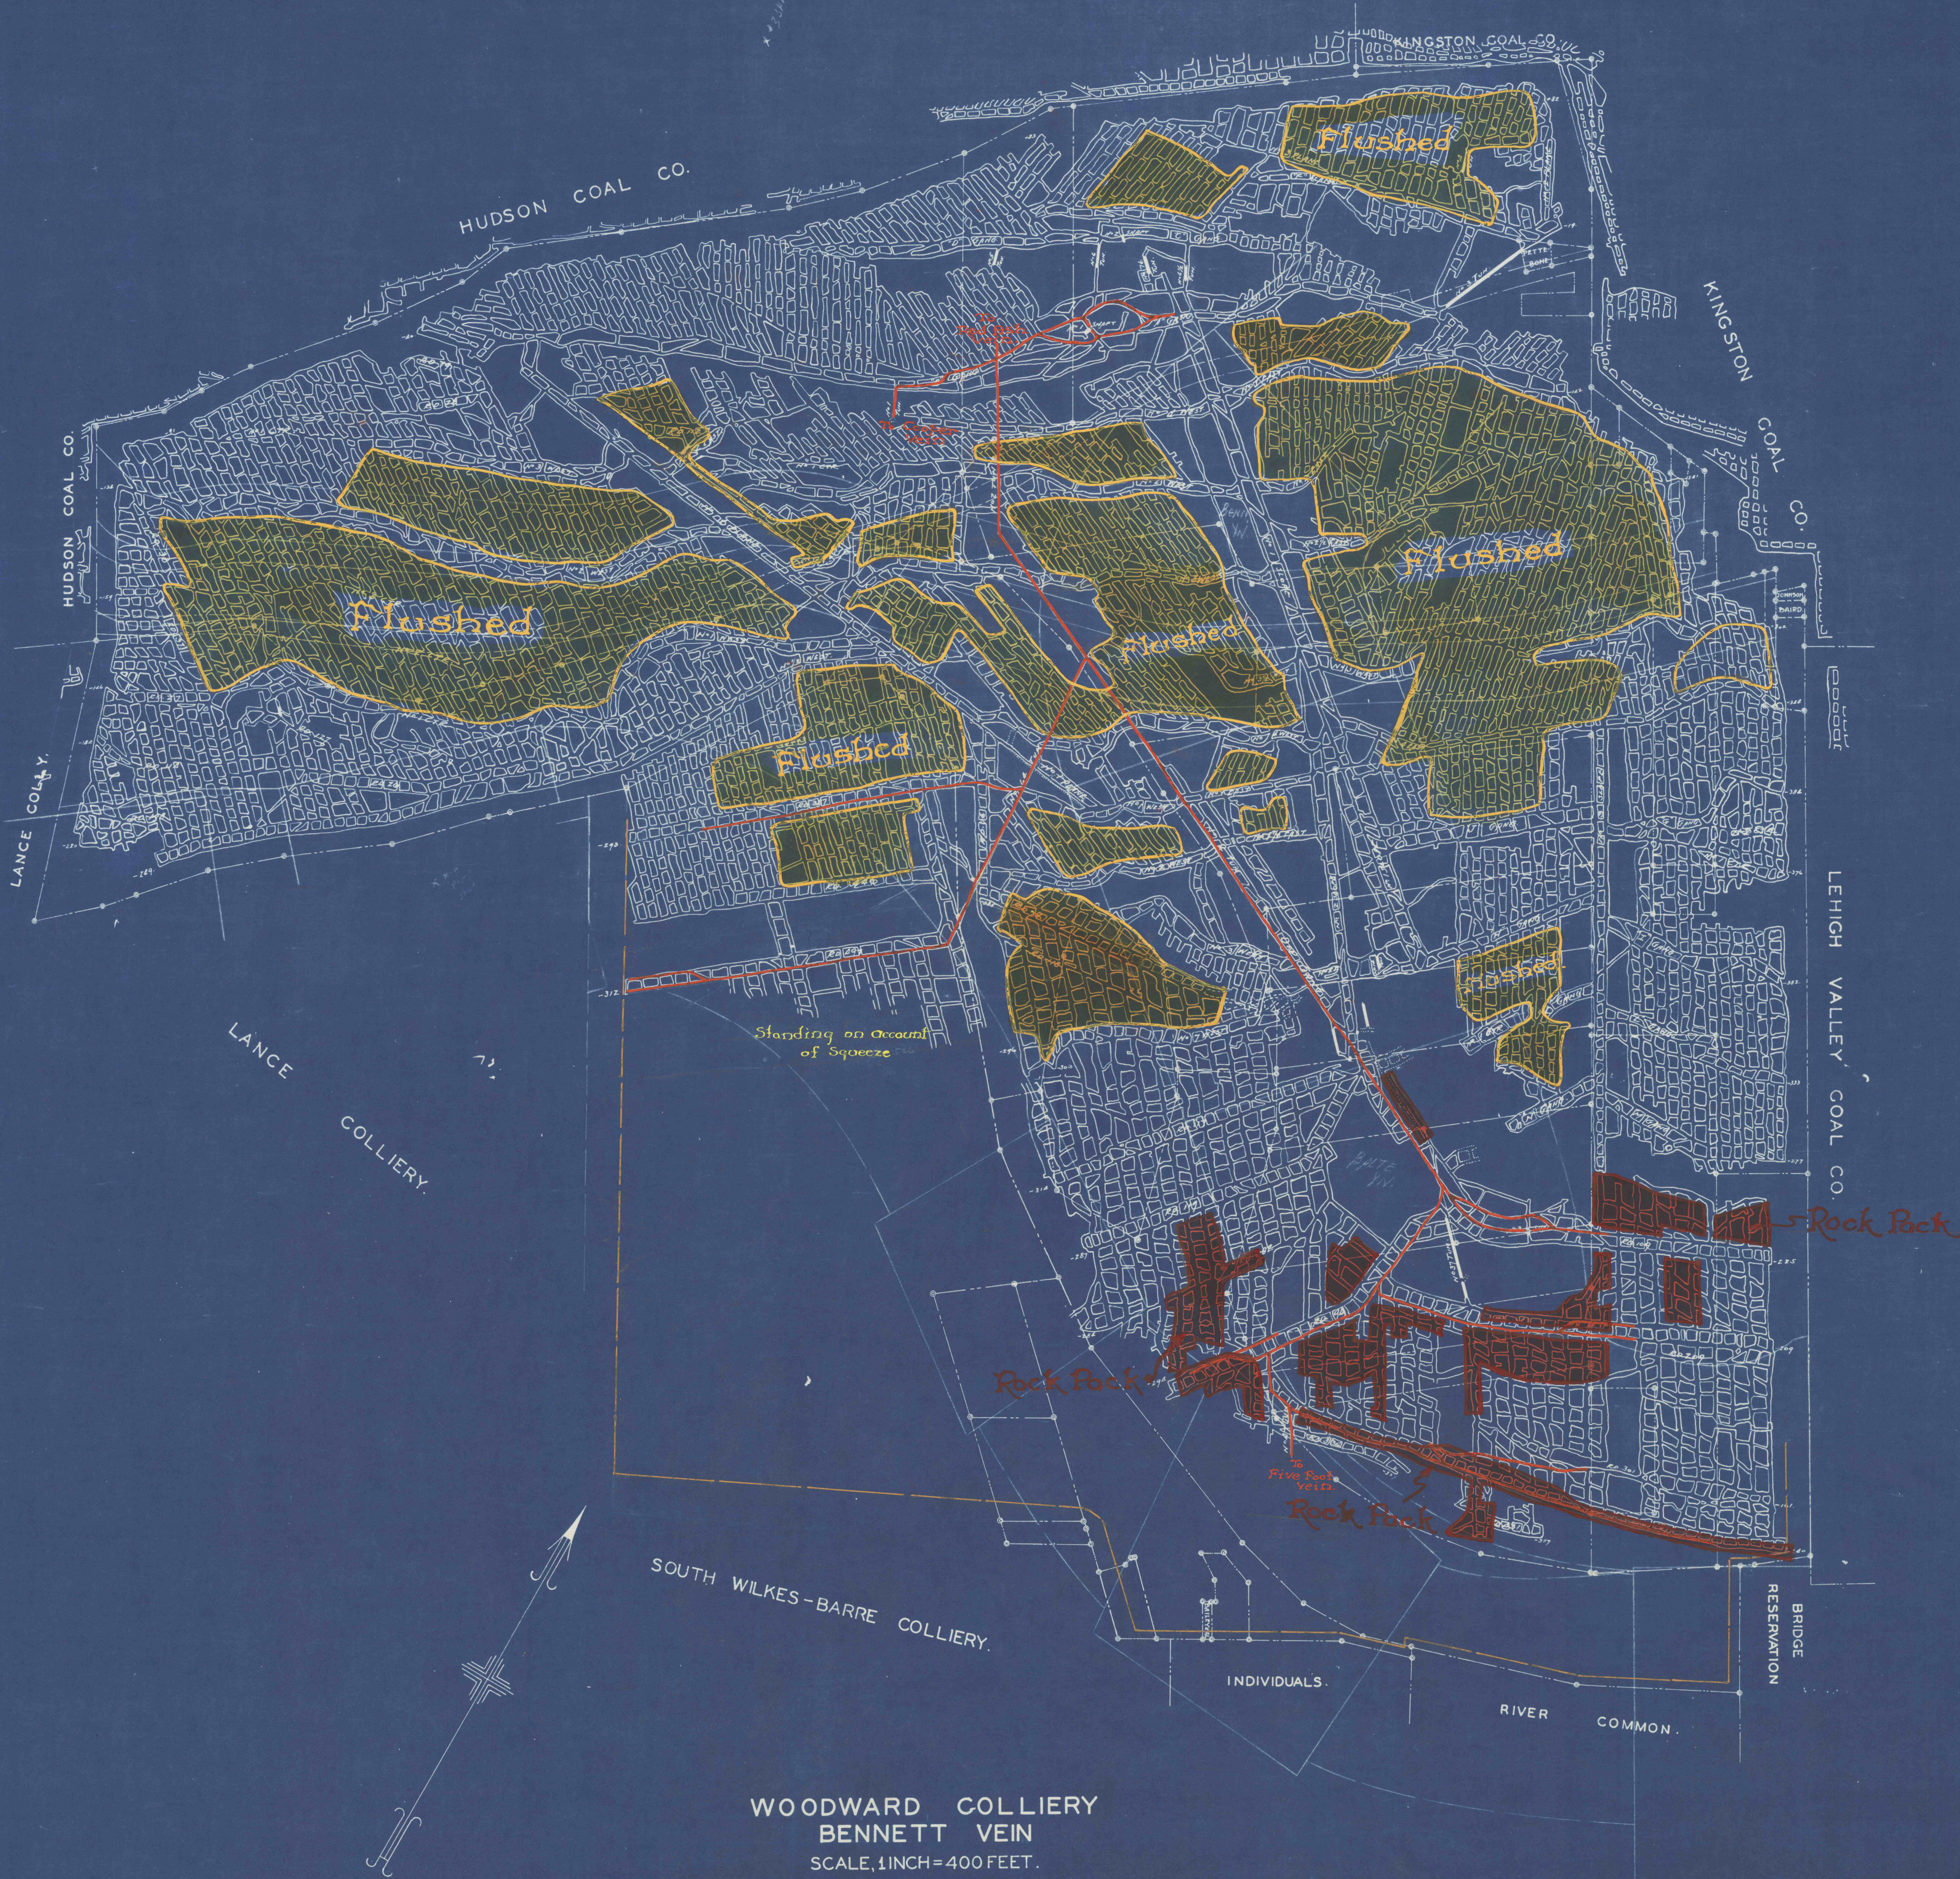

POSTED
In Service June 30
Apr. 12, 40
Nov. 8, 43
May 1, 45

WOODWARD COLLIERY
BENNETT VEIN
SCALE, 1 INCH = 400 FEET.