


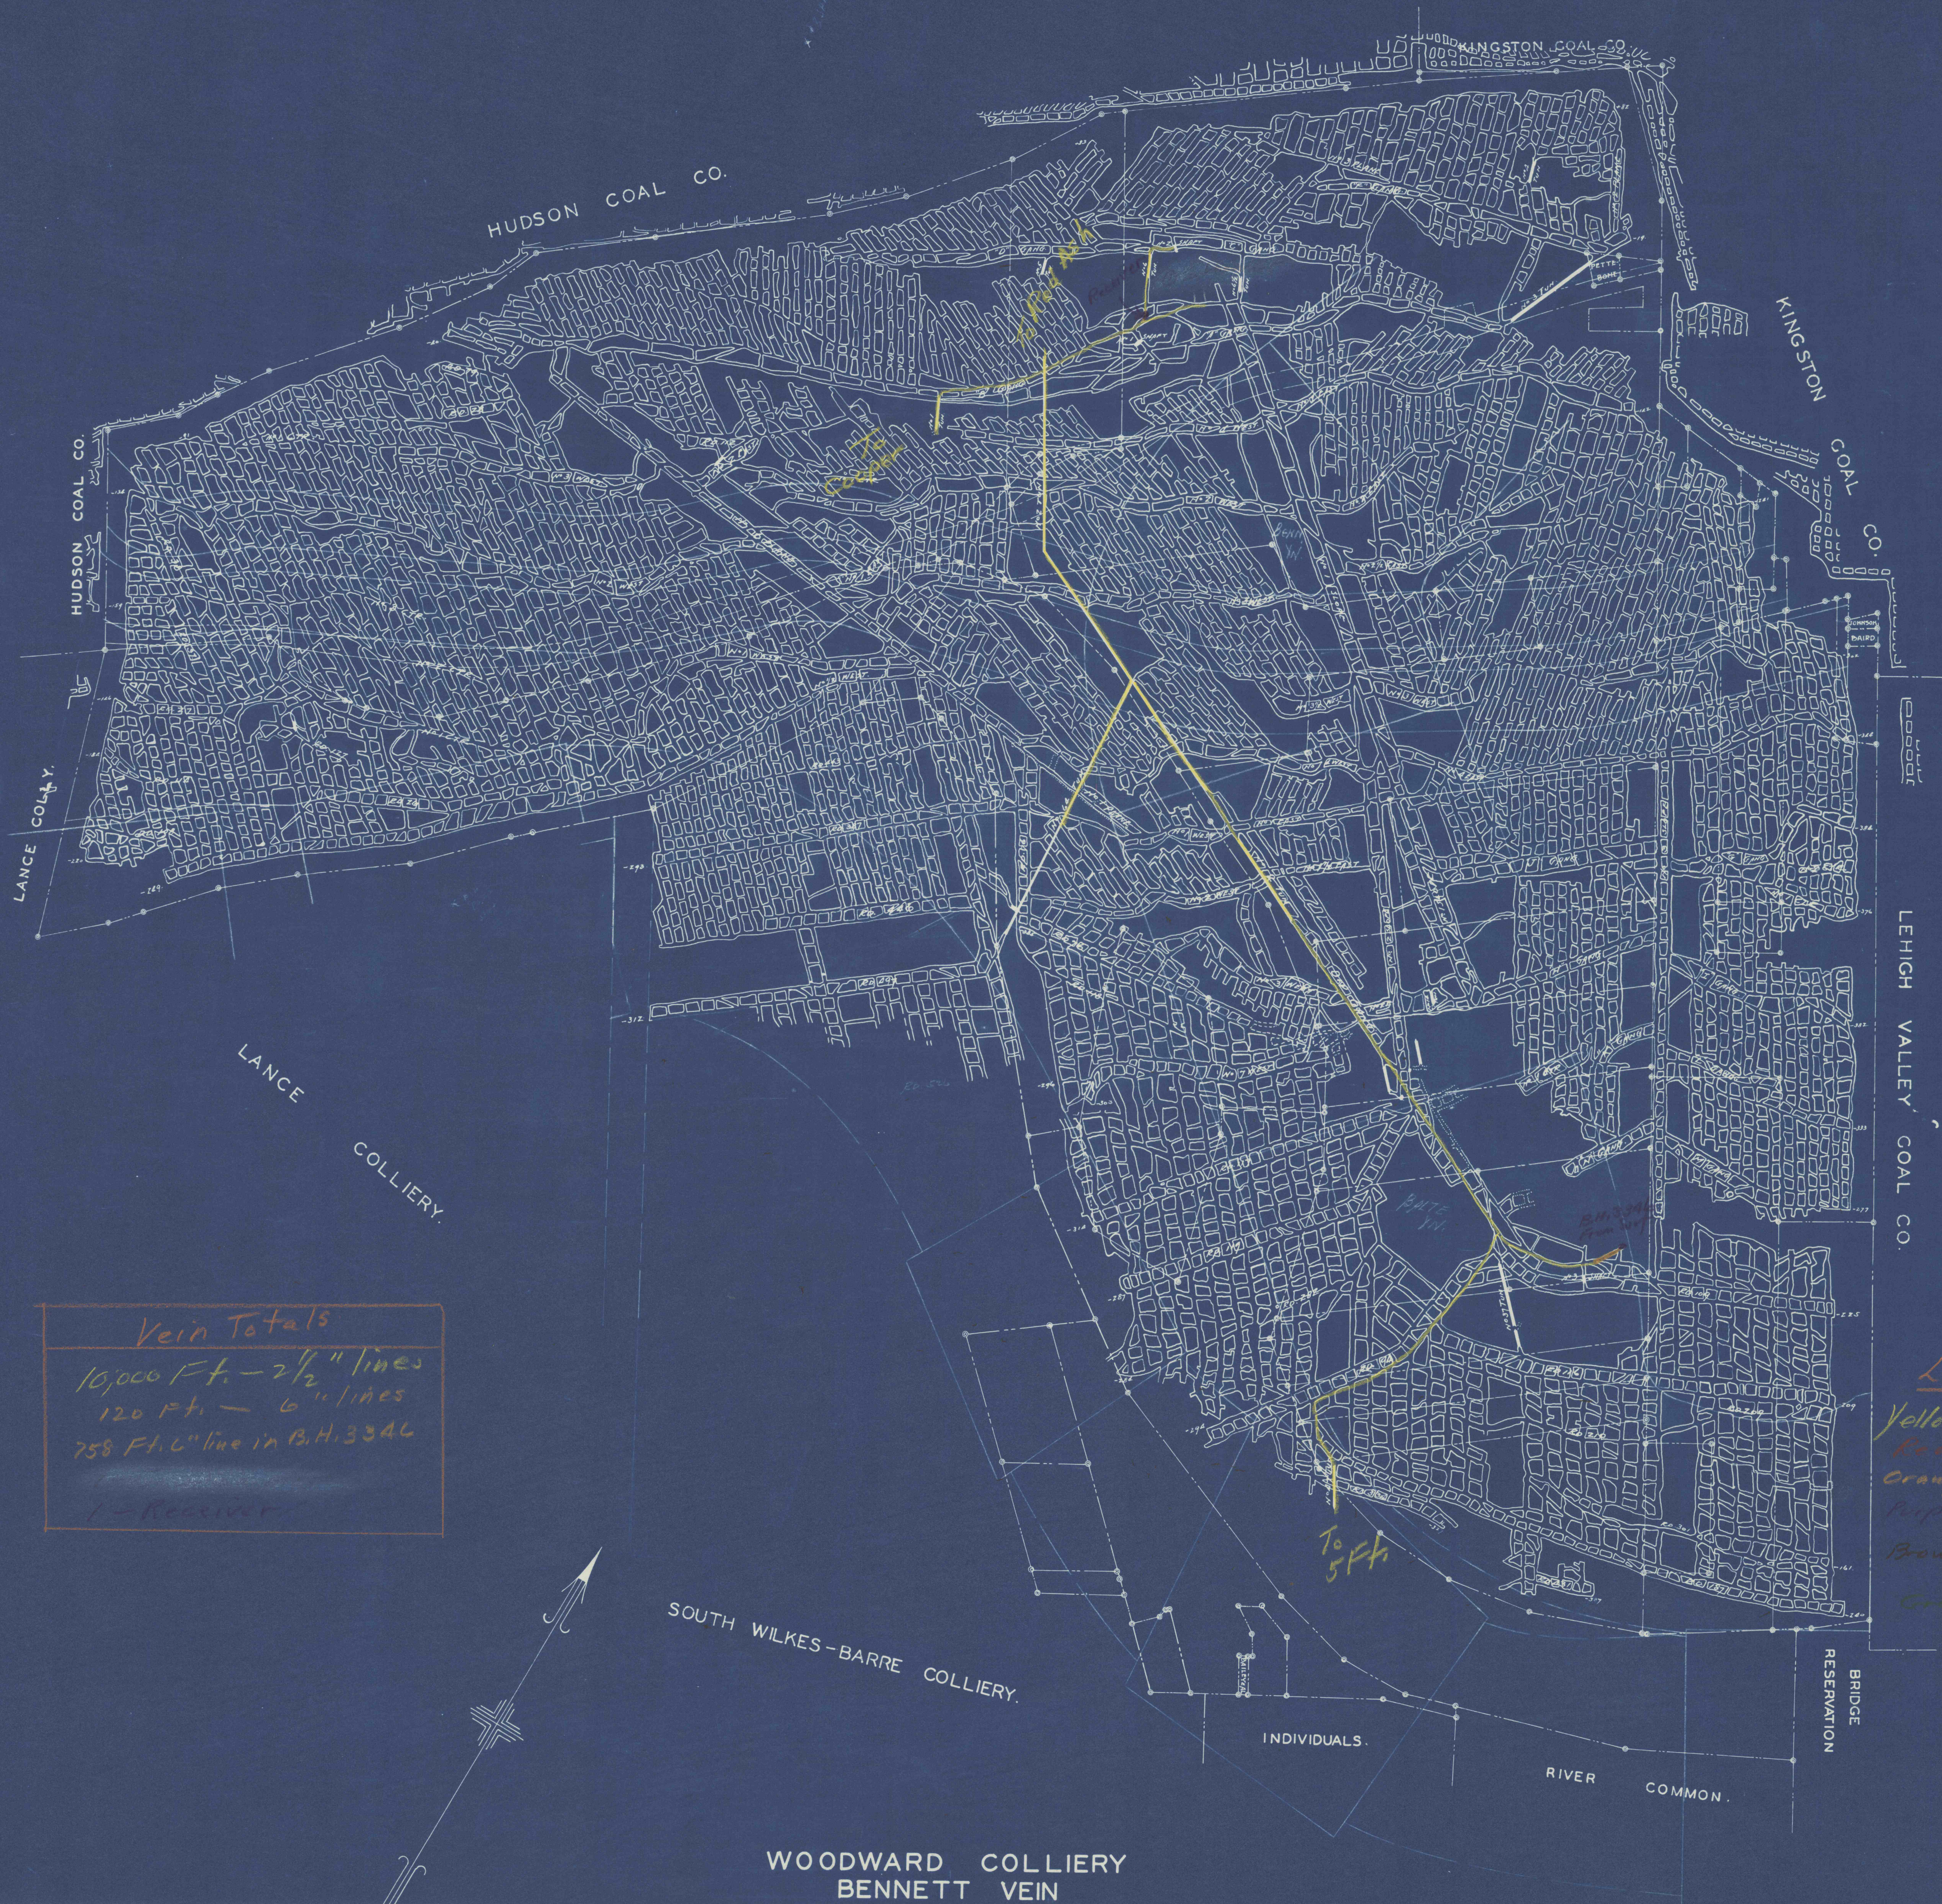

POSTED.

IN SERVICE	JUNE 38
APR. 18, 40	F
NOV. 8, 43	F