


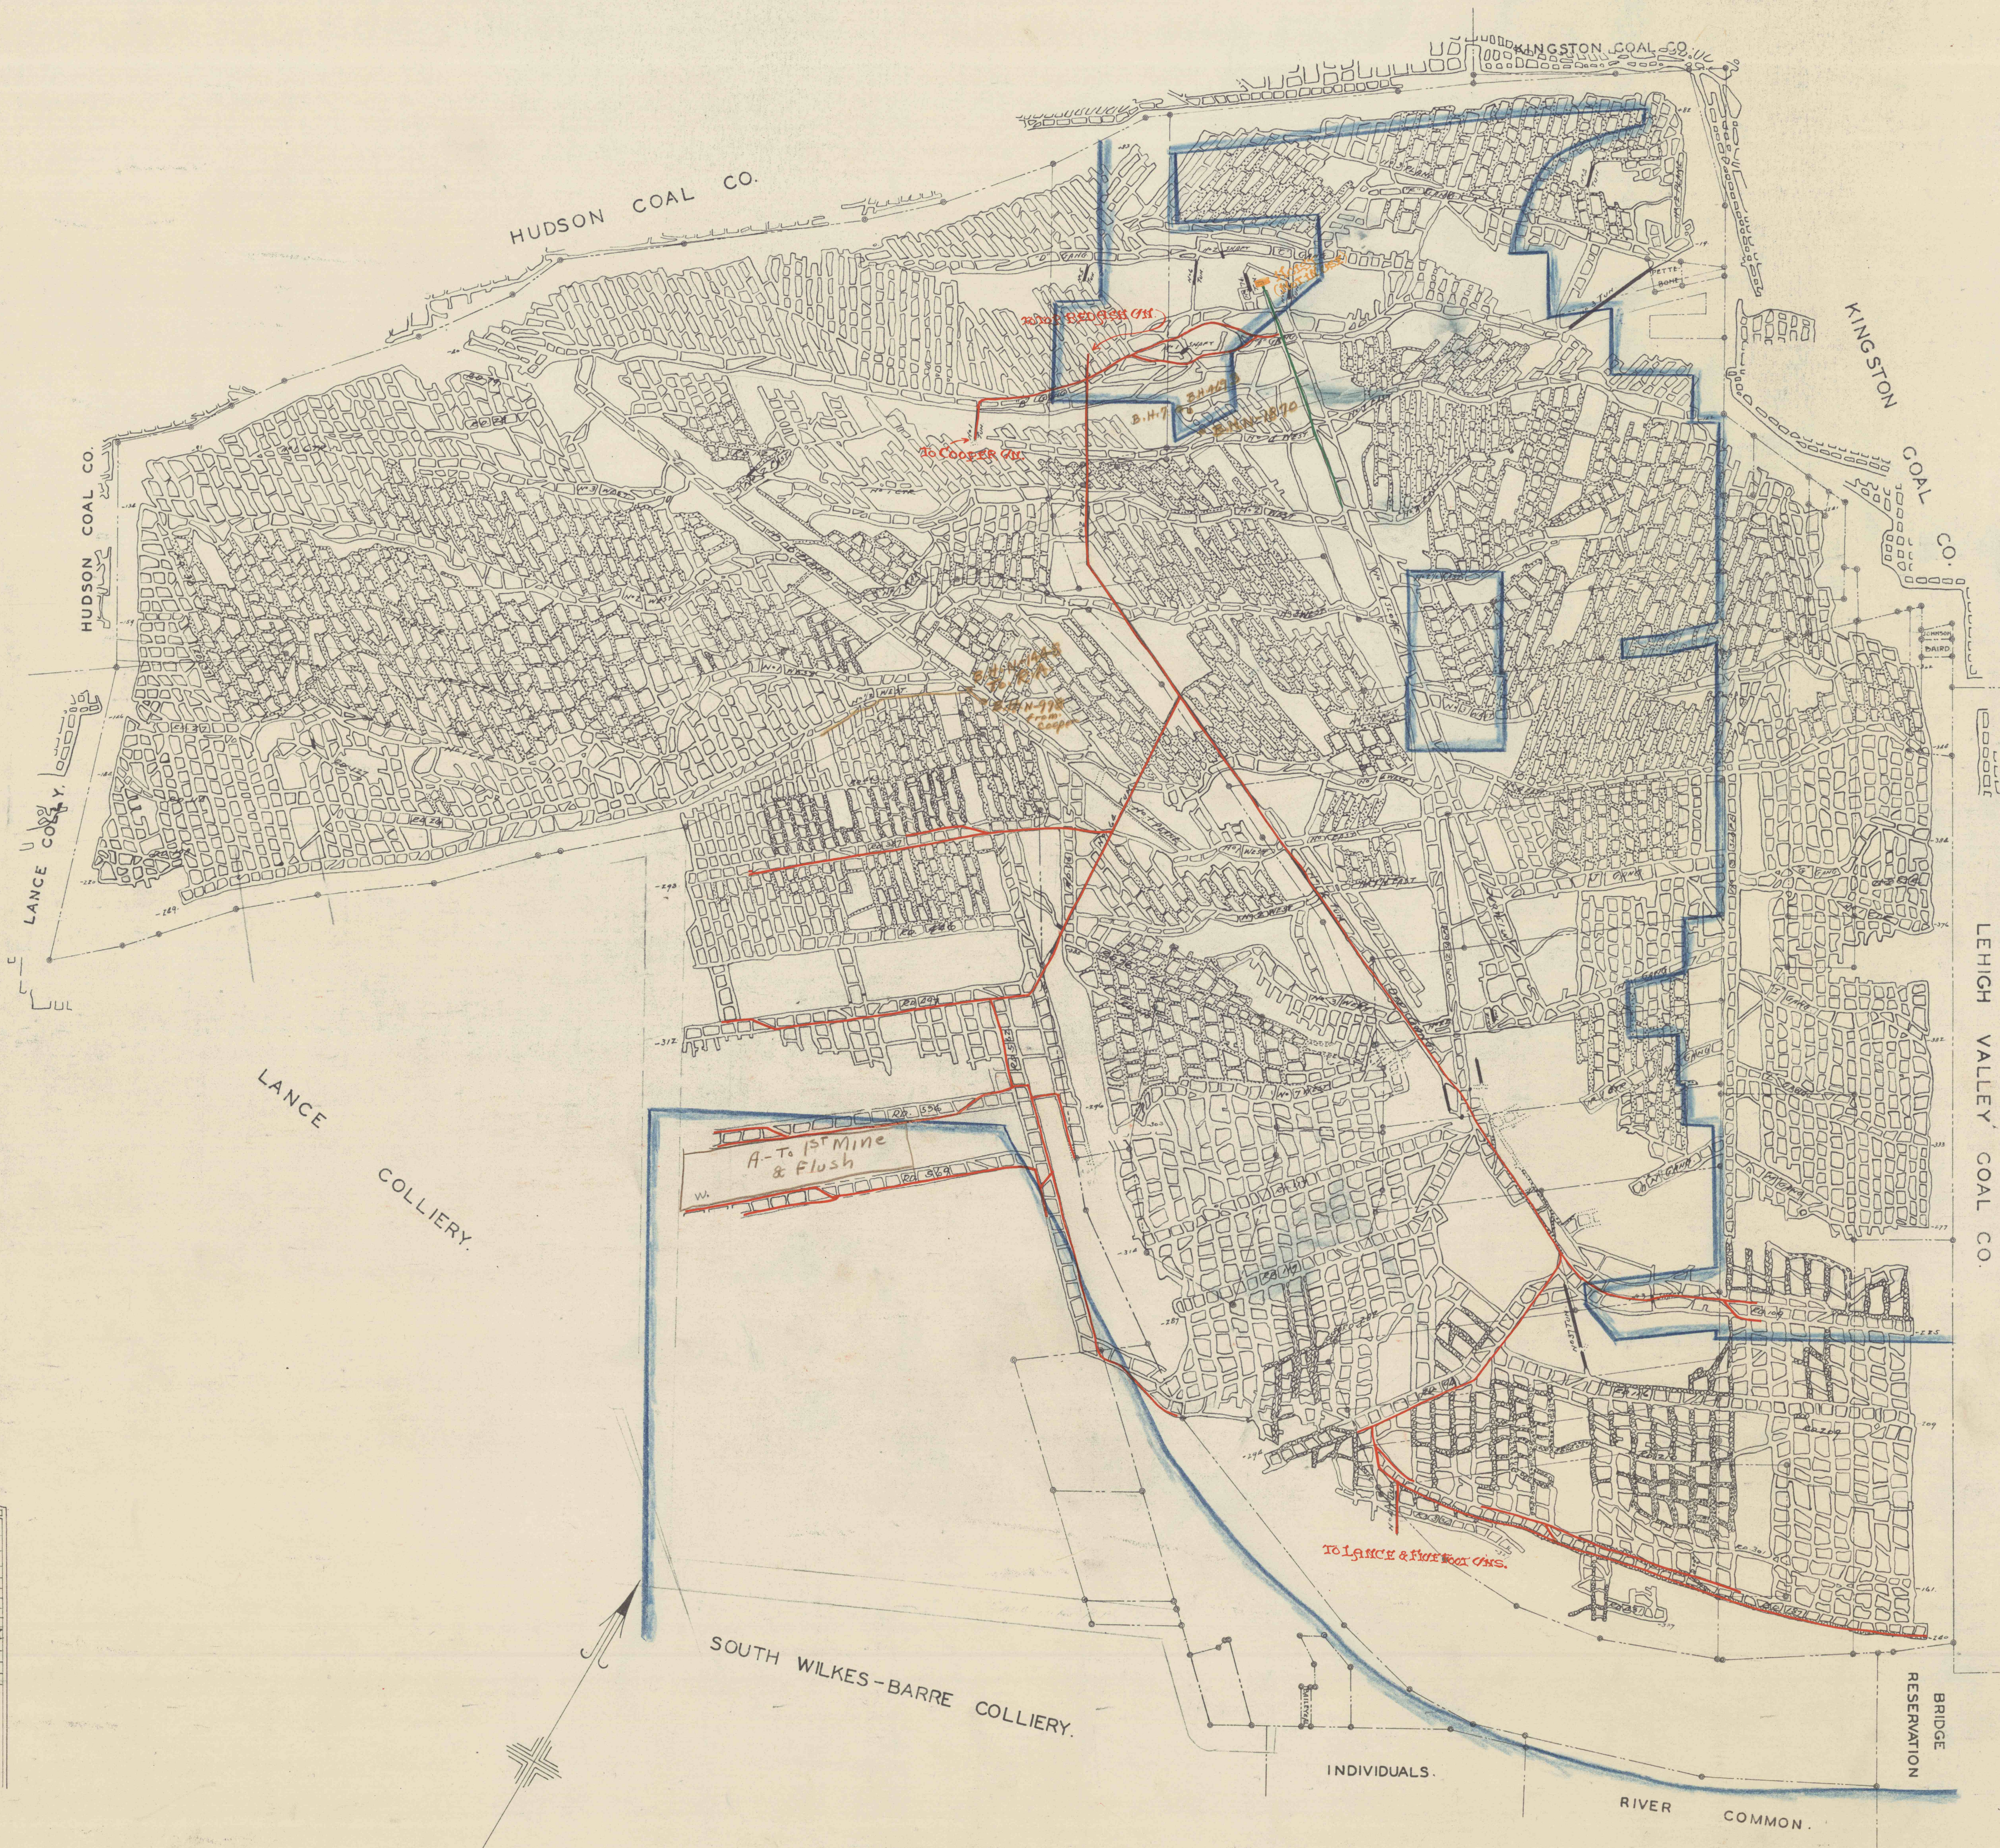

POSTED.	
In Service	June 58
Apr. 10, 40	F
Nov. 8, 43	F
May 1, 45	F
Nov. 21, 47	F
Aug. 2, 48	F
Apr. 25, 49	F
Feb. 9, 50	F
Dec. 3, 50	F
June 9, 52	AM

WOODWARD COLLIERY
BENNETT VEIN
SCALE, 1 INCH = 400 FEET.