


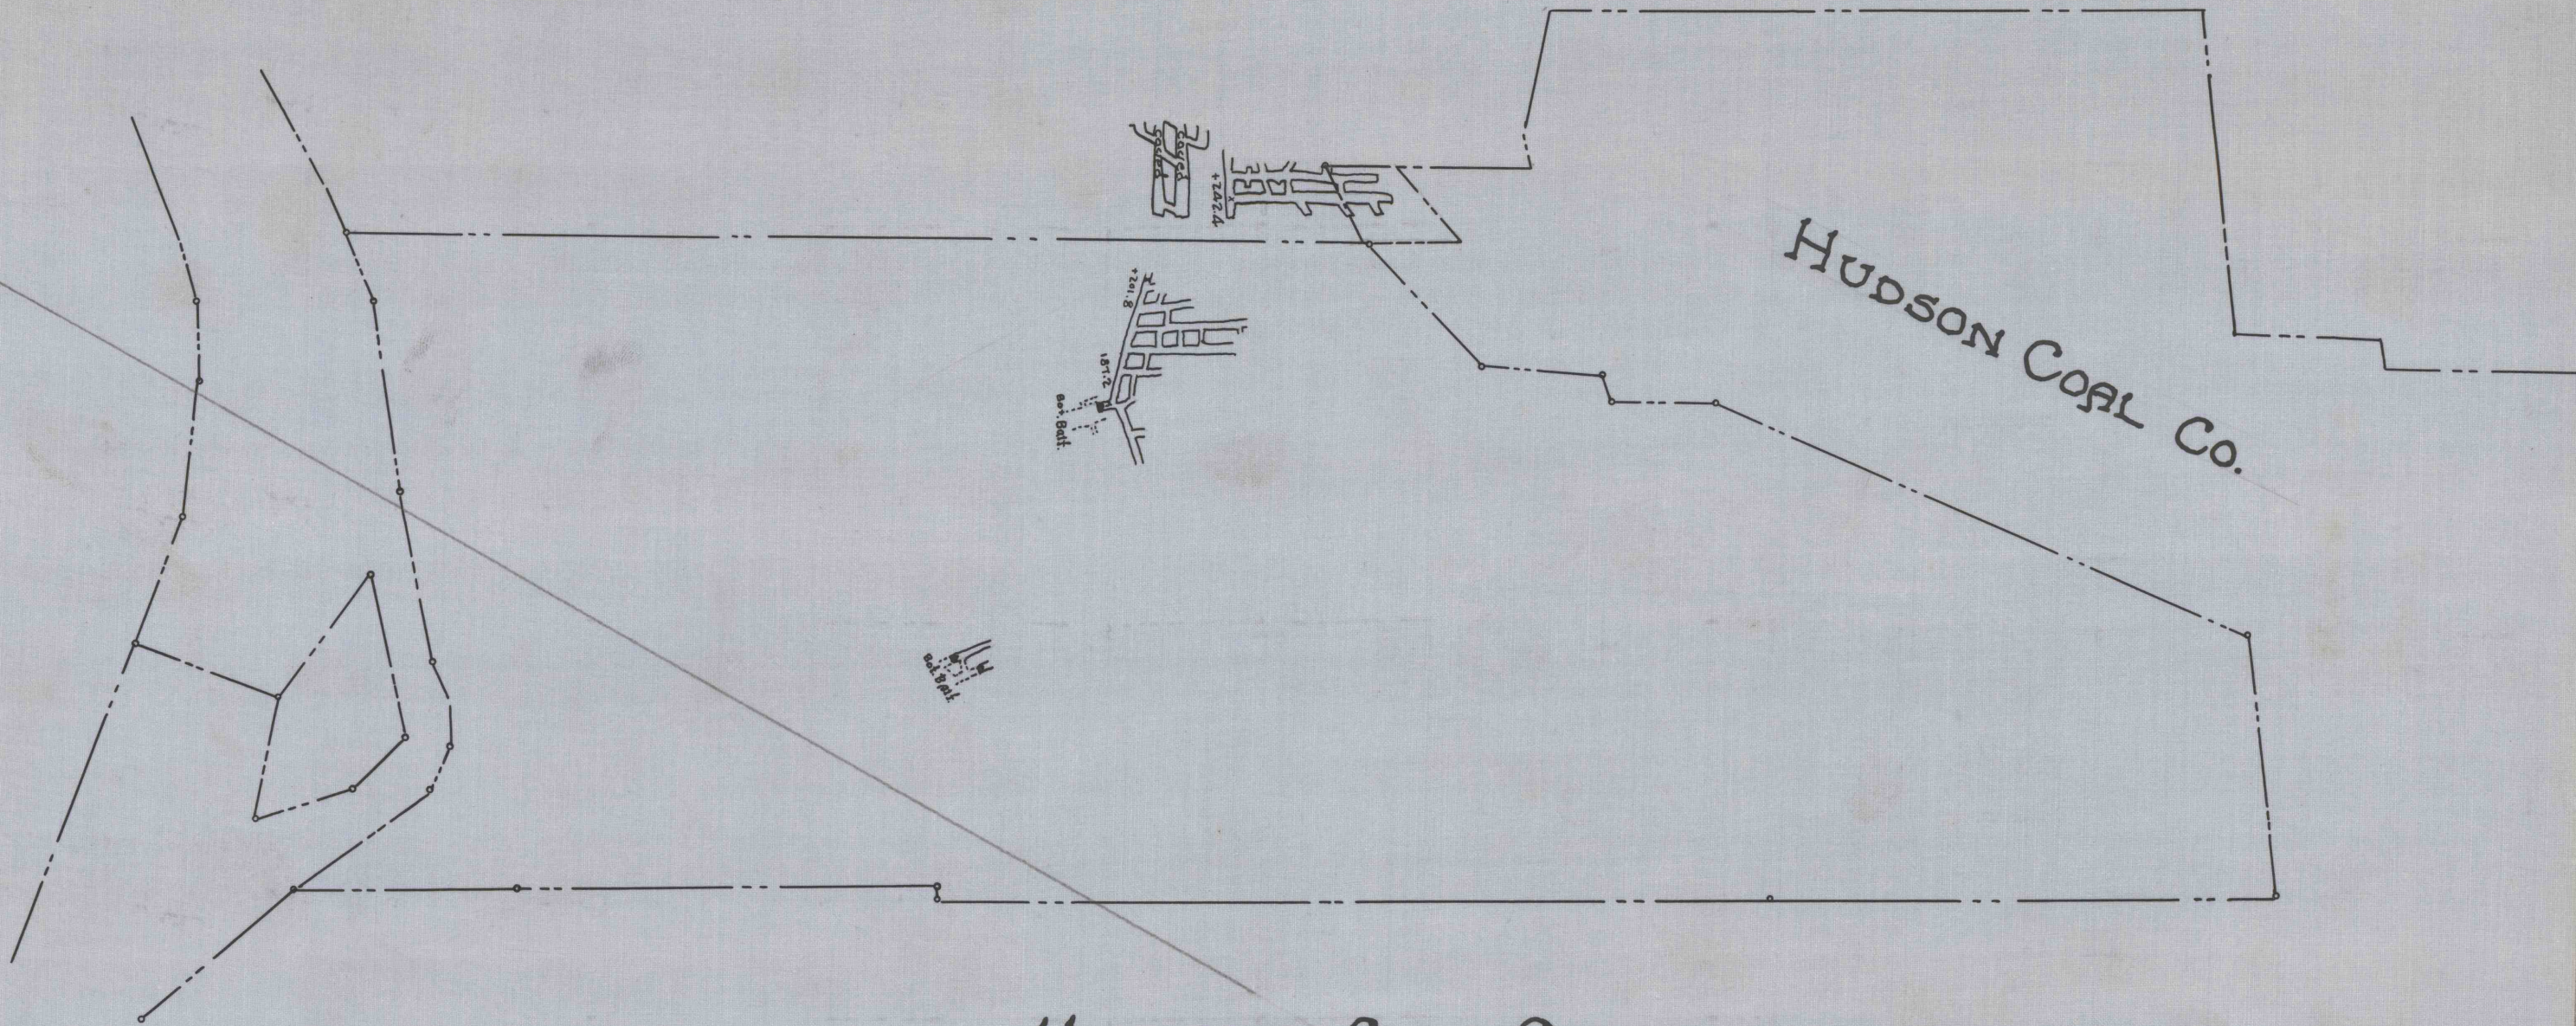

HUDSON COAL CO.