

WOODWARD COLLEBY
CHECKER VERM
SCALE 1"=100'

M R S . J

SECTION LINE "F"
R-5-A-6

J. MITCHELL
RIVER WARRANT

L E A S E

SECTION LINE "G"
R-5-A-7

J. MITCHELL
FISH ISLAND
WILKES-BARRE CITY
EDWARDSVILLE BORO.

SECTION LINE "H"
R-5-A-8

SAFETY ZONE

SECTION LINE "I"
R-6-A-1


POINT N 1644
LANCE TO DULT VR
BENNETT VA 28-264

SECTION LINE "J"
R-6-A-2

J. S. LAW 104

SAFETY ZONE

SECTION LINE "K"
R-6-A-3

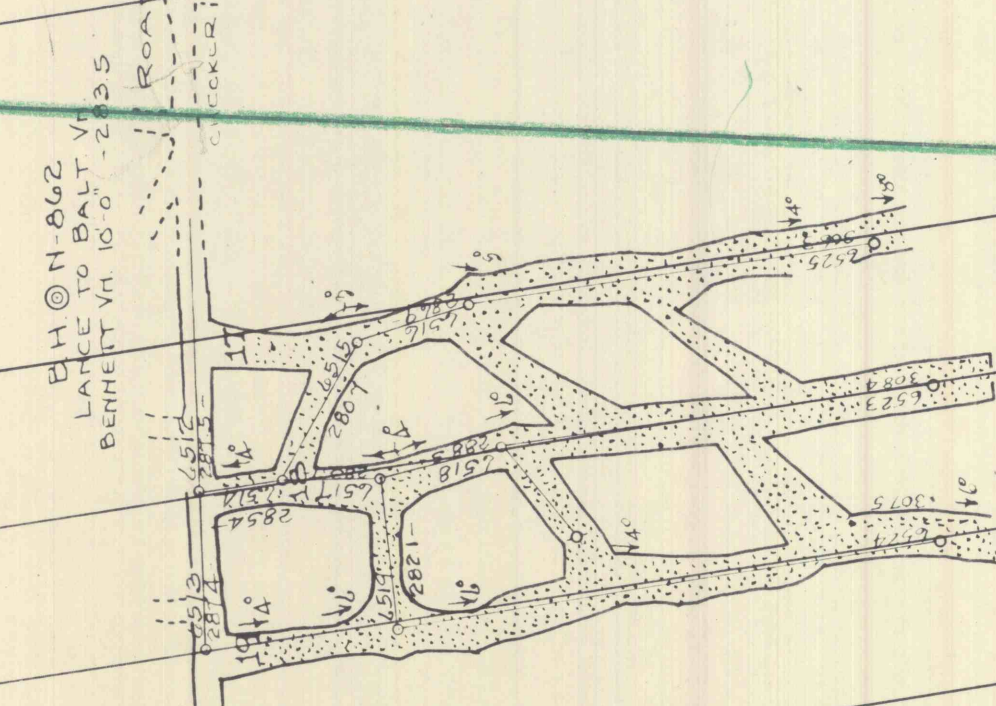



