


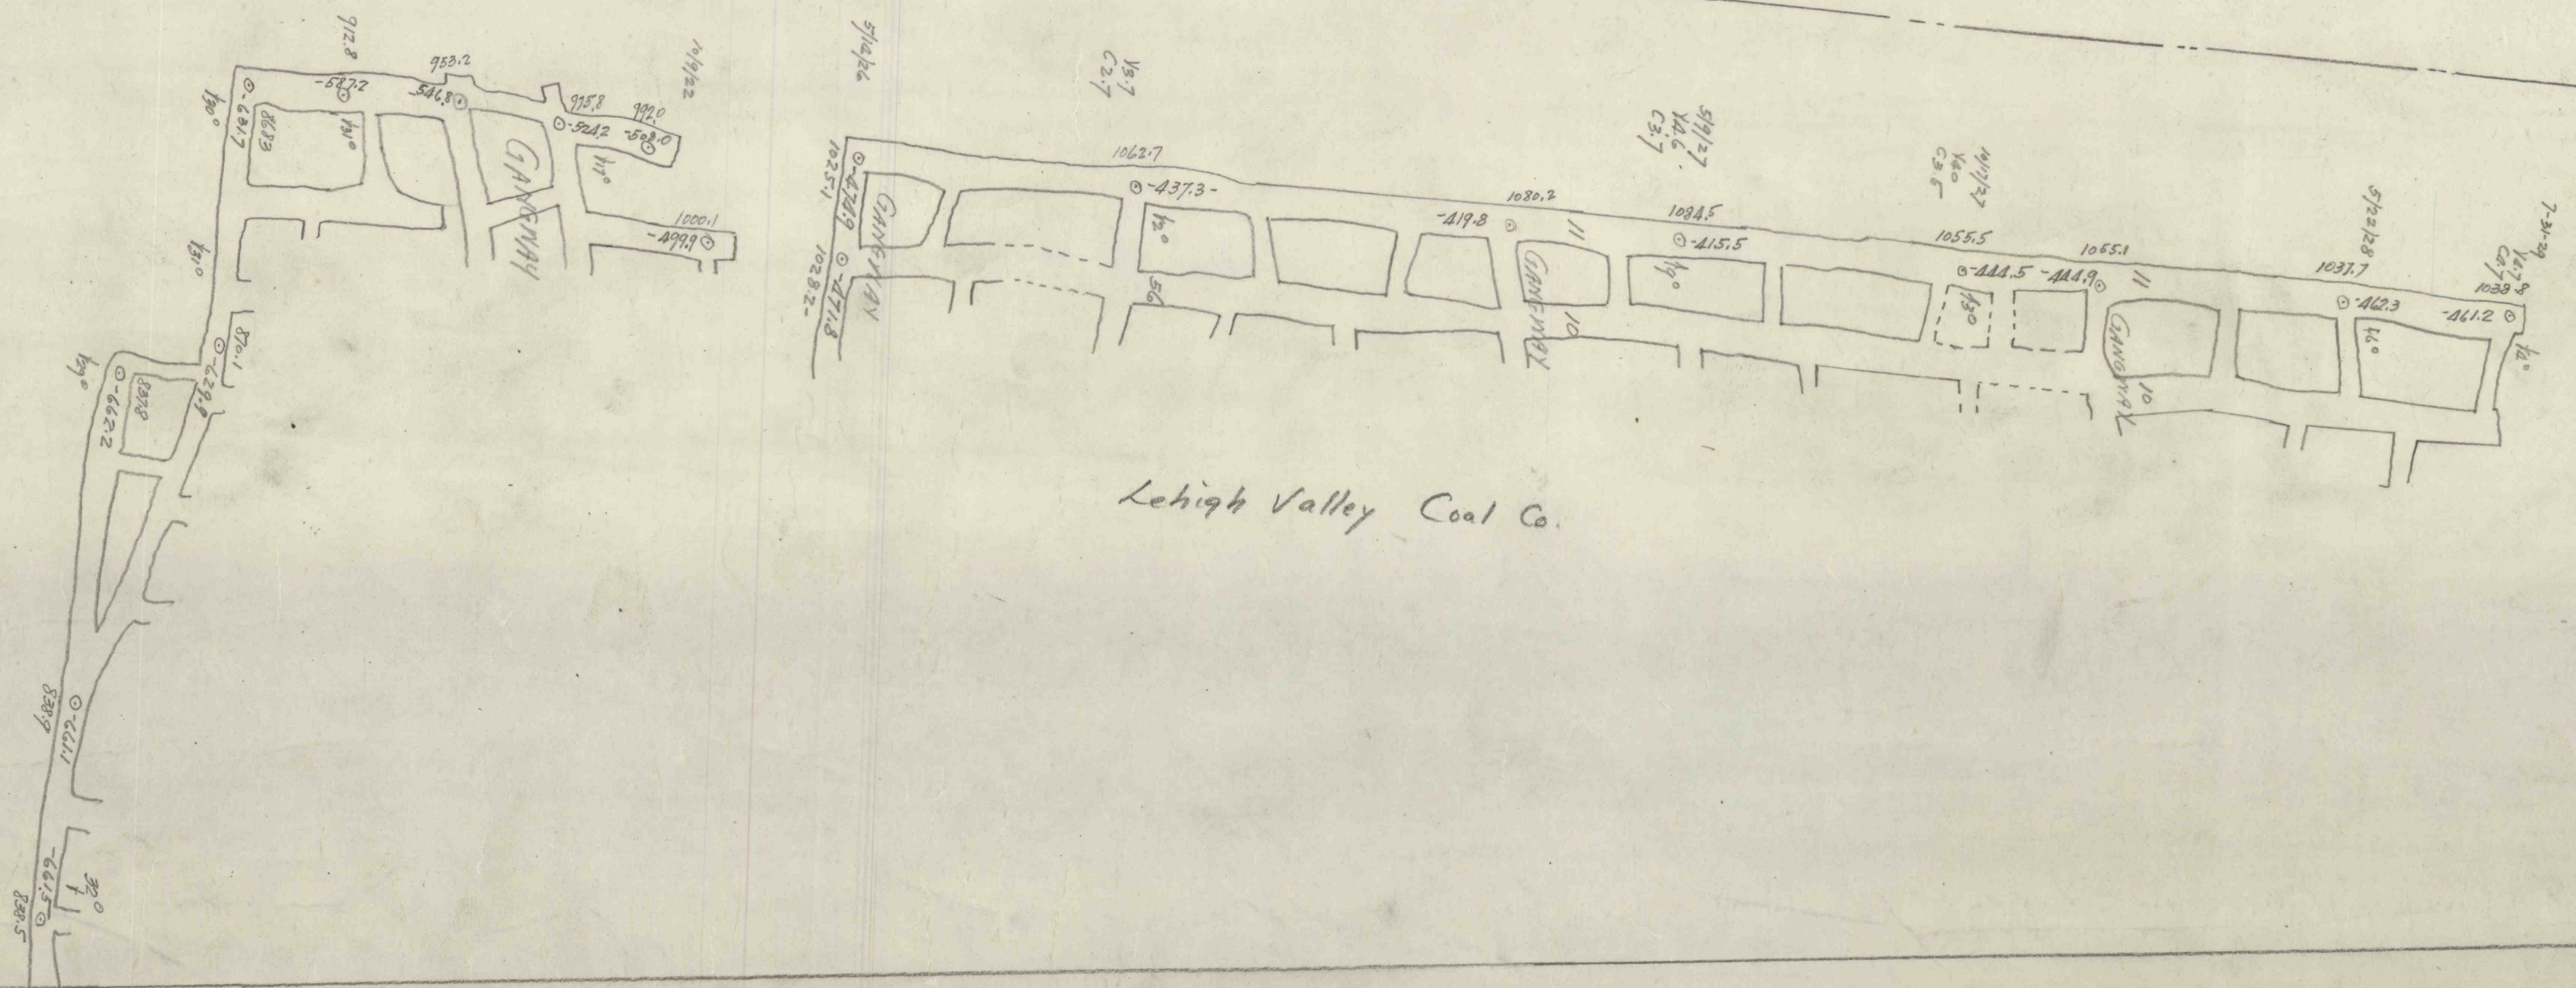

WOODWARD Top Red Ash
South Tracing