


POSTED.	
In Service June 28	
APR. 18 40	F
MAY 8 40	F
MAY 1 45	F
MAY 6 46	F
NOV. 24 47	F
AUG. 3 48	F
DEC. 15 49	F
FEB. 9 50	F
DEC. 2 50	F
JULY 29 52	P.M.
MAY 20 54	P.M.
OCT. 25 54	P.M.
MARCH 24 54	P.M.
MARCH 17 55	P.M.

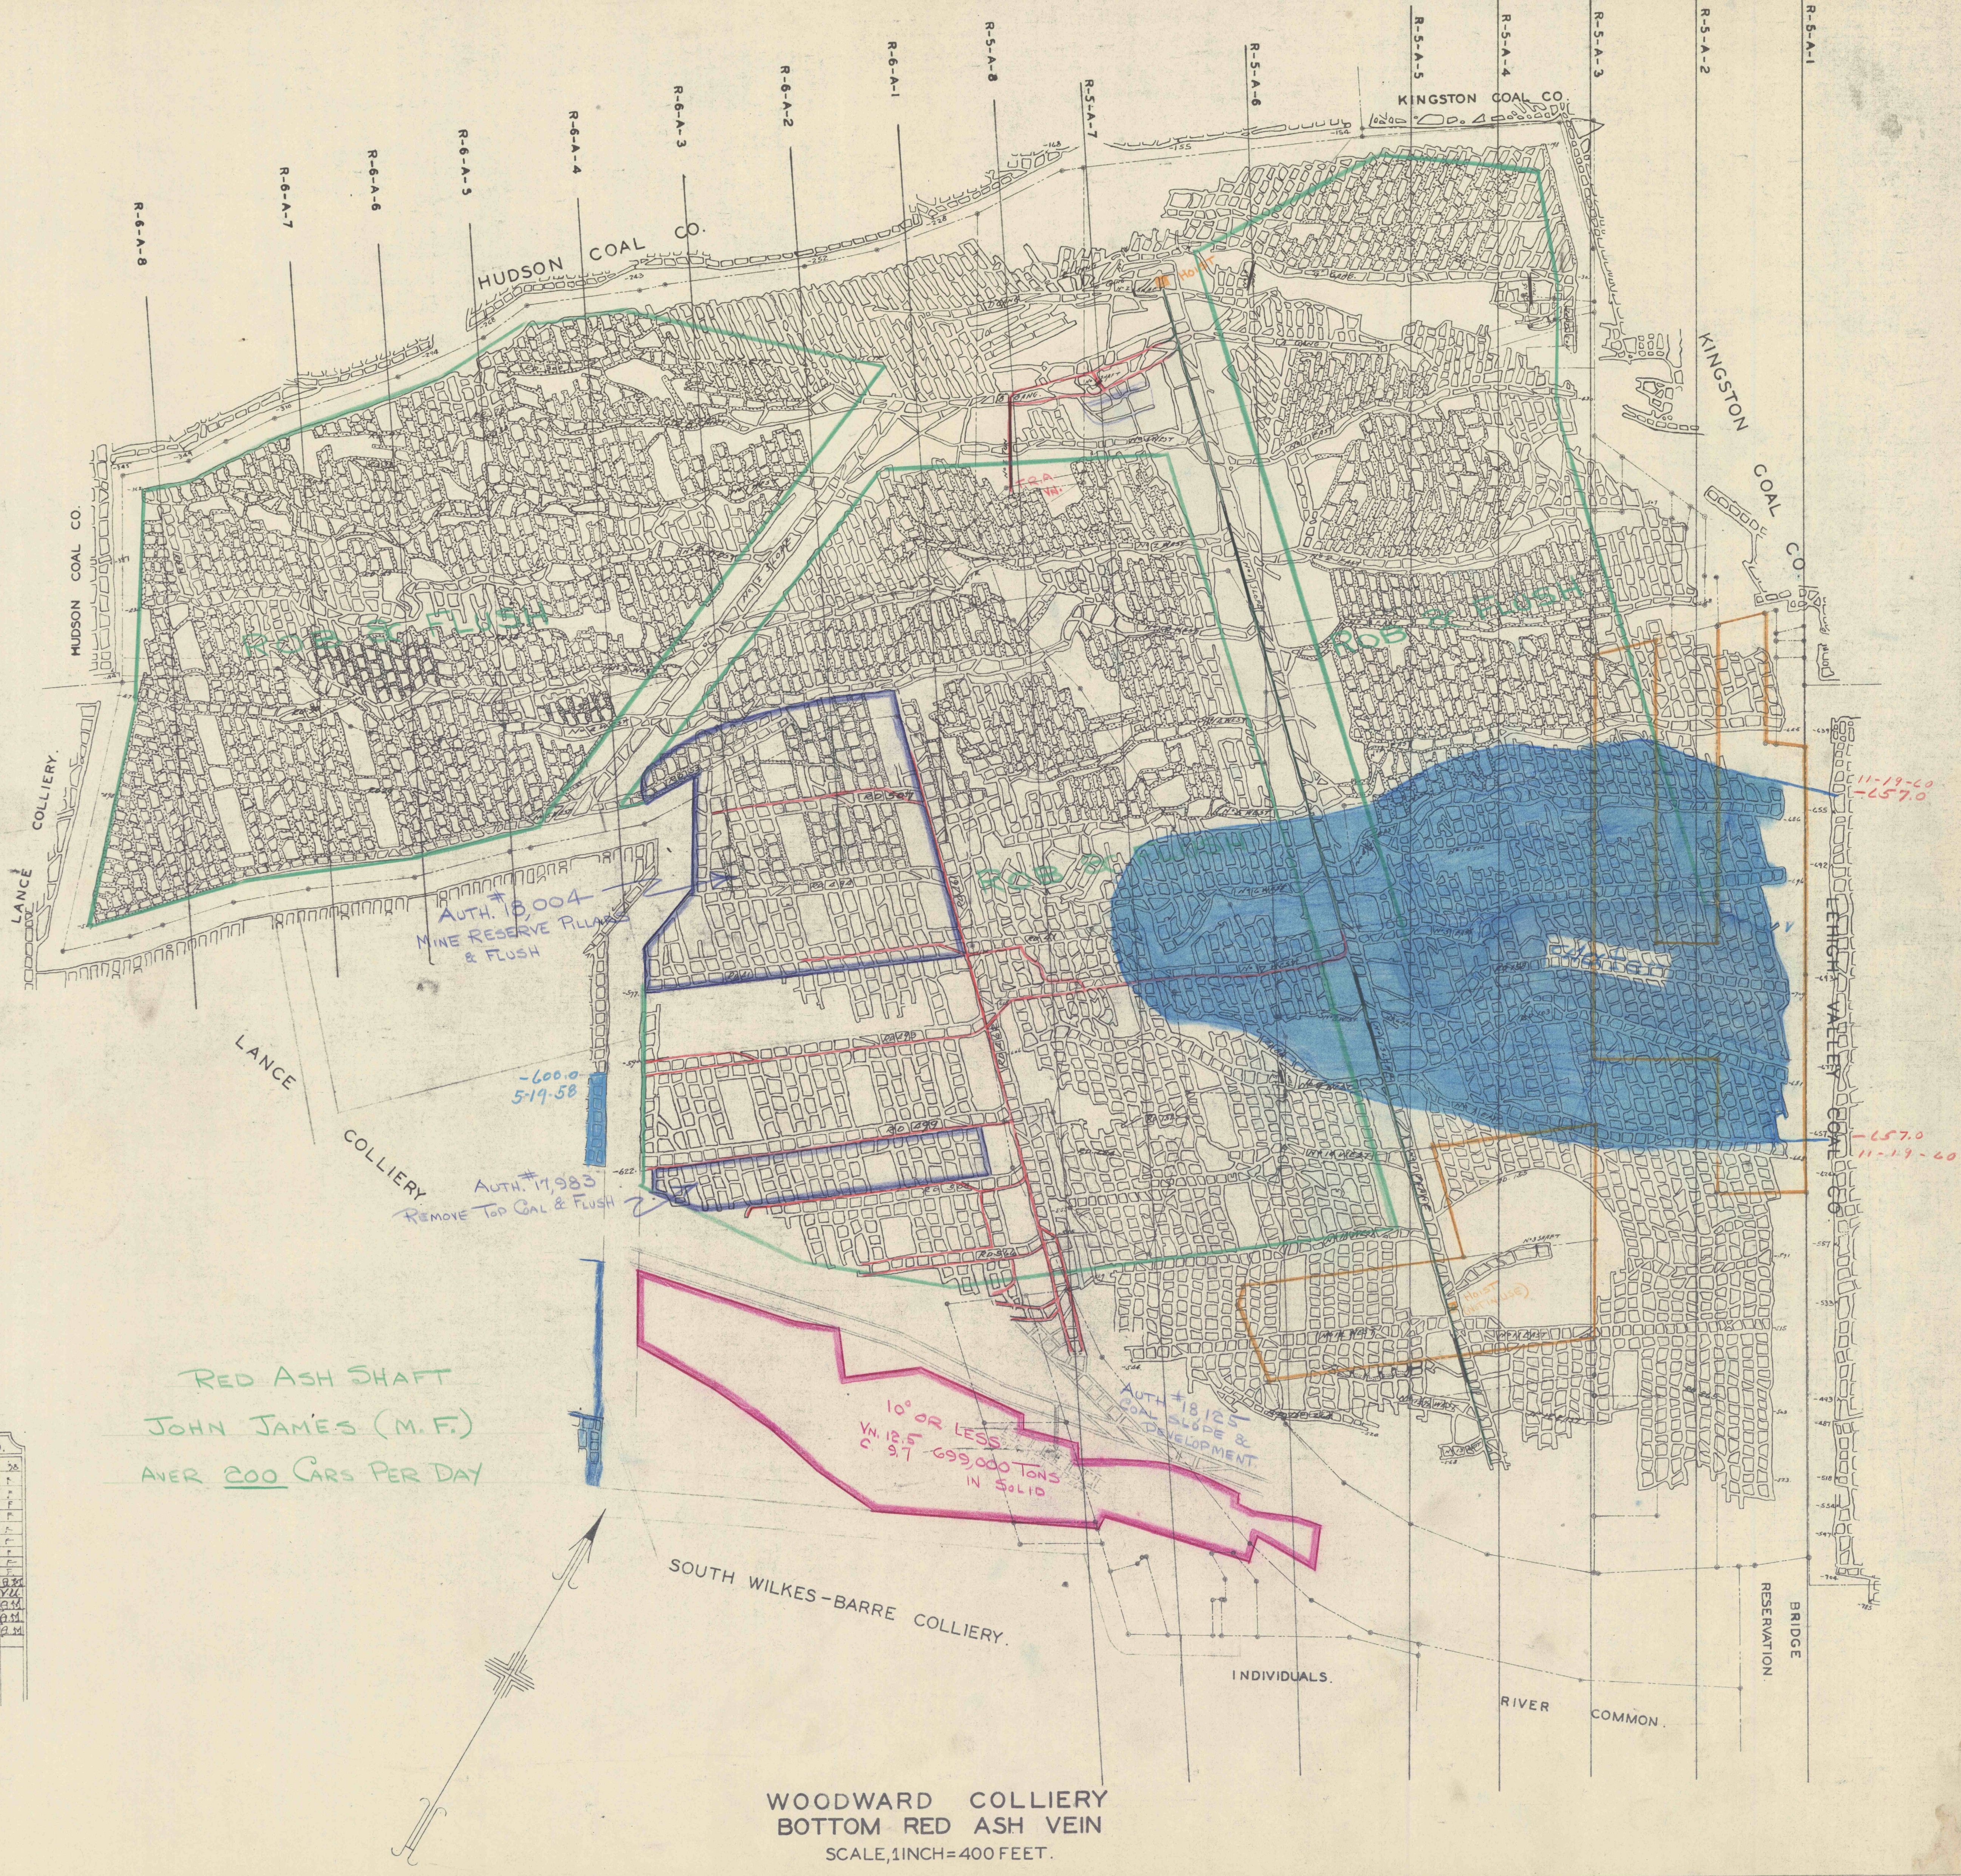

WOODWARD COLLIERY
BOTTOM RED ASH VEIN
SCALE, 1 INCH = 400 FEET.