


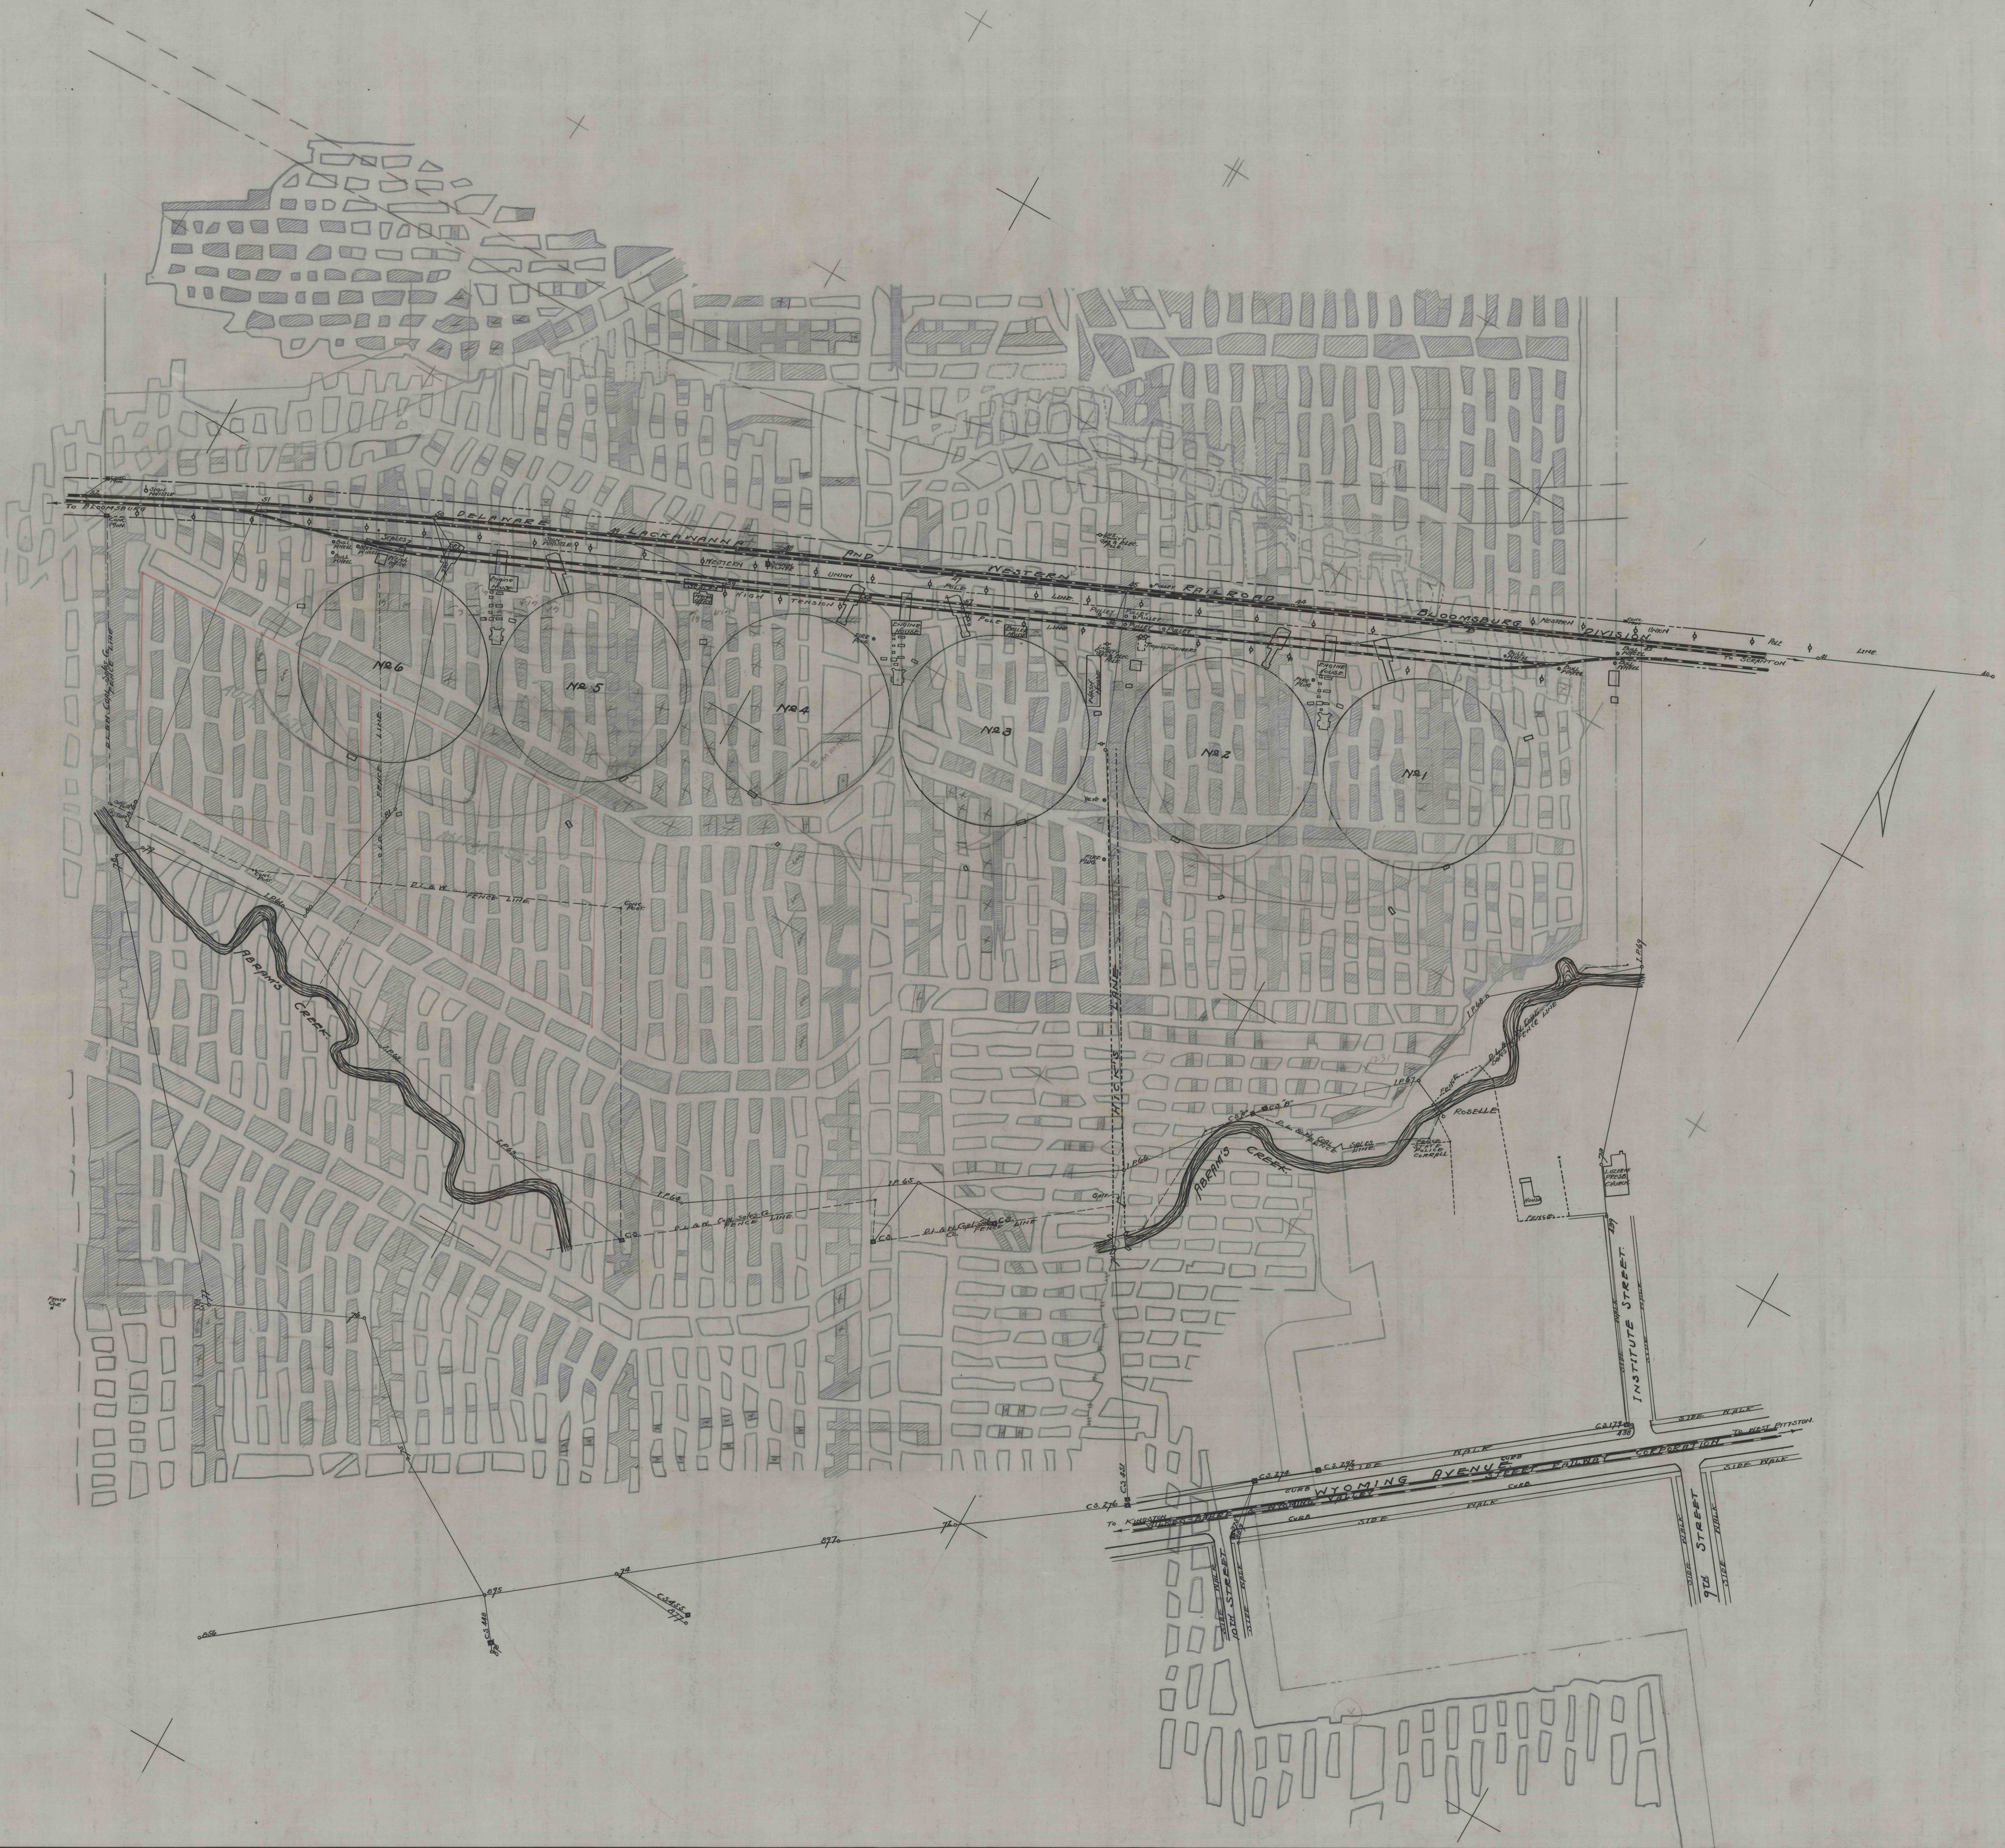

POSTED
1-3-40
2-10-40
3-10-40
4-10-40