


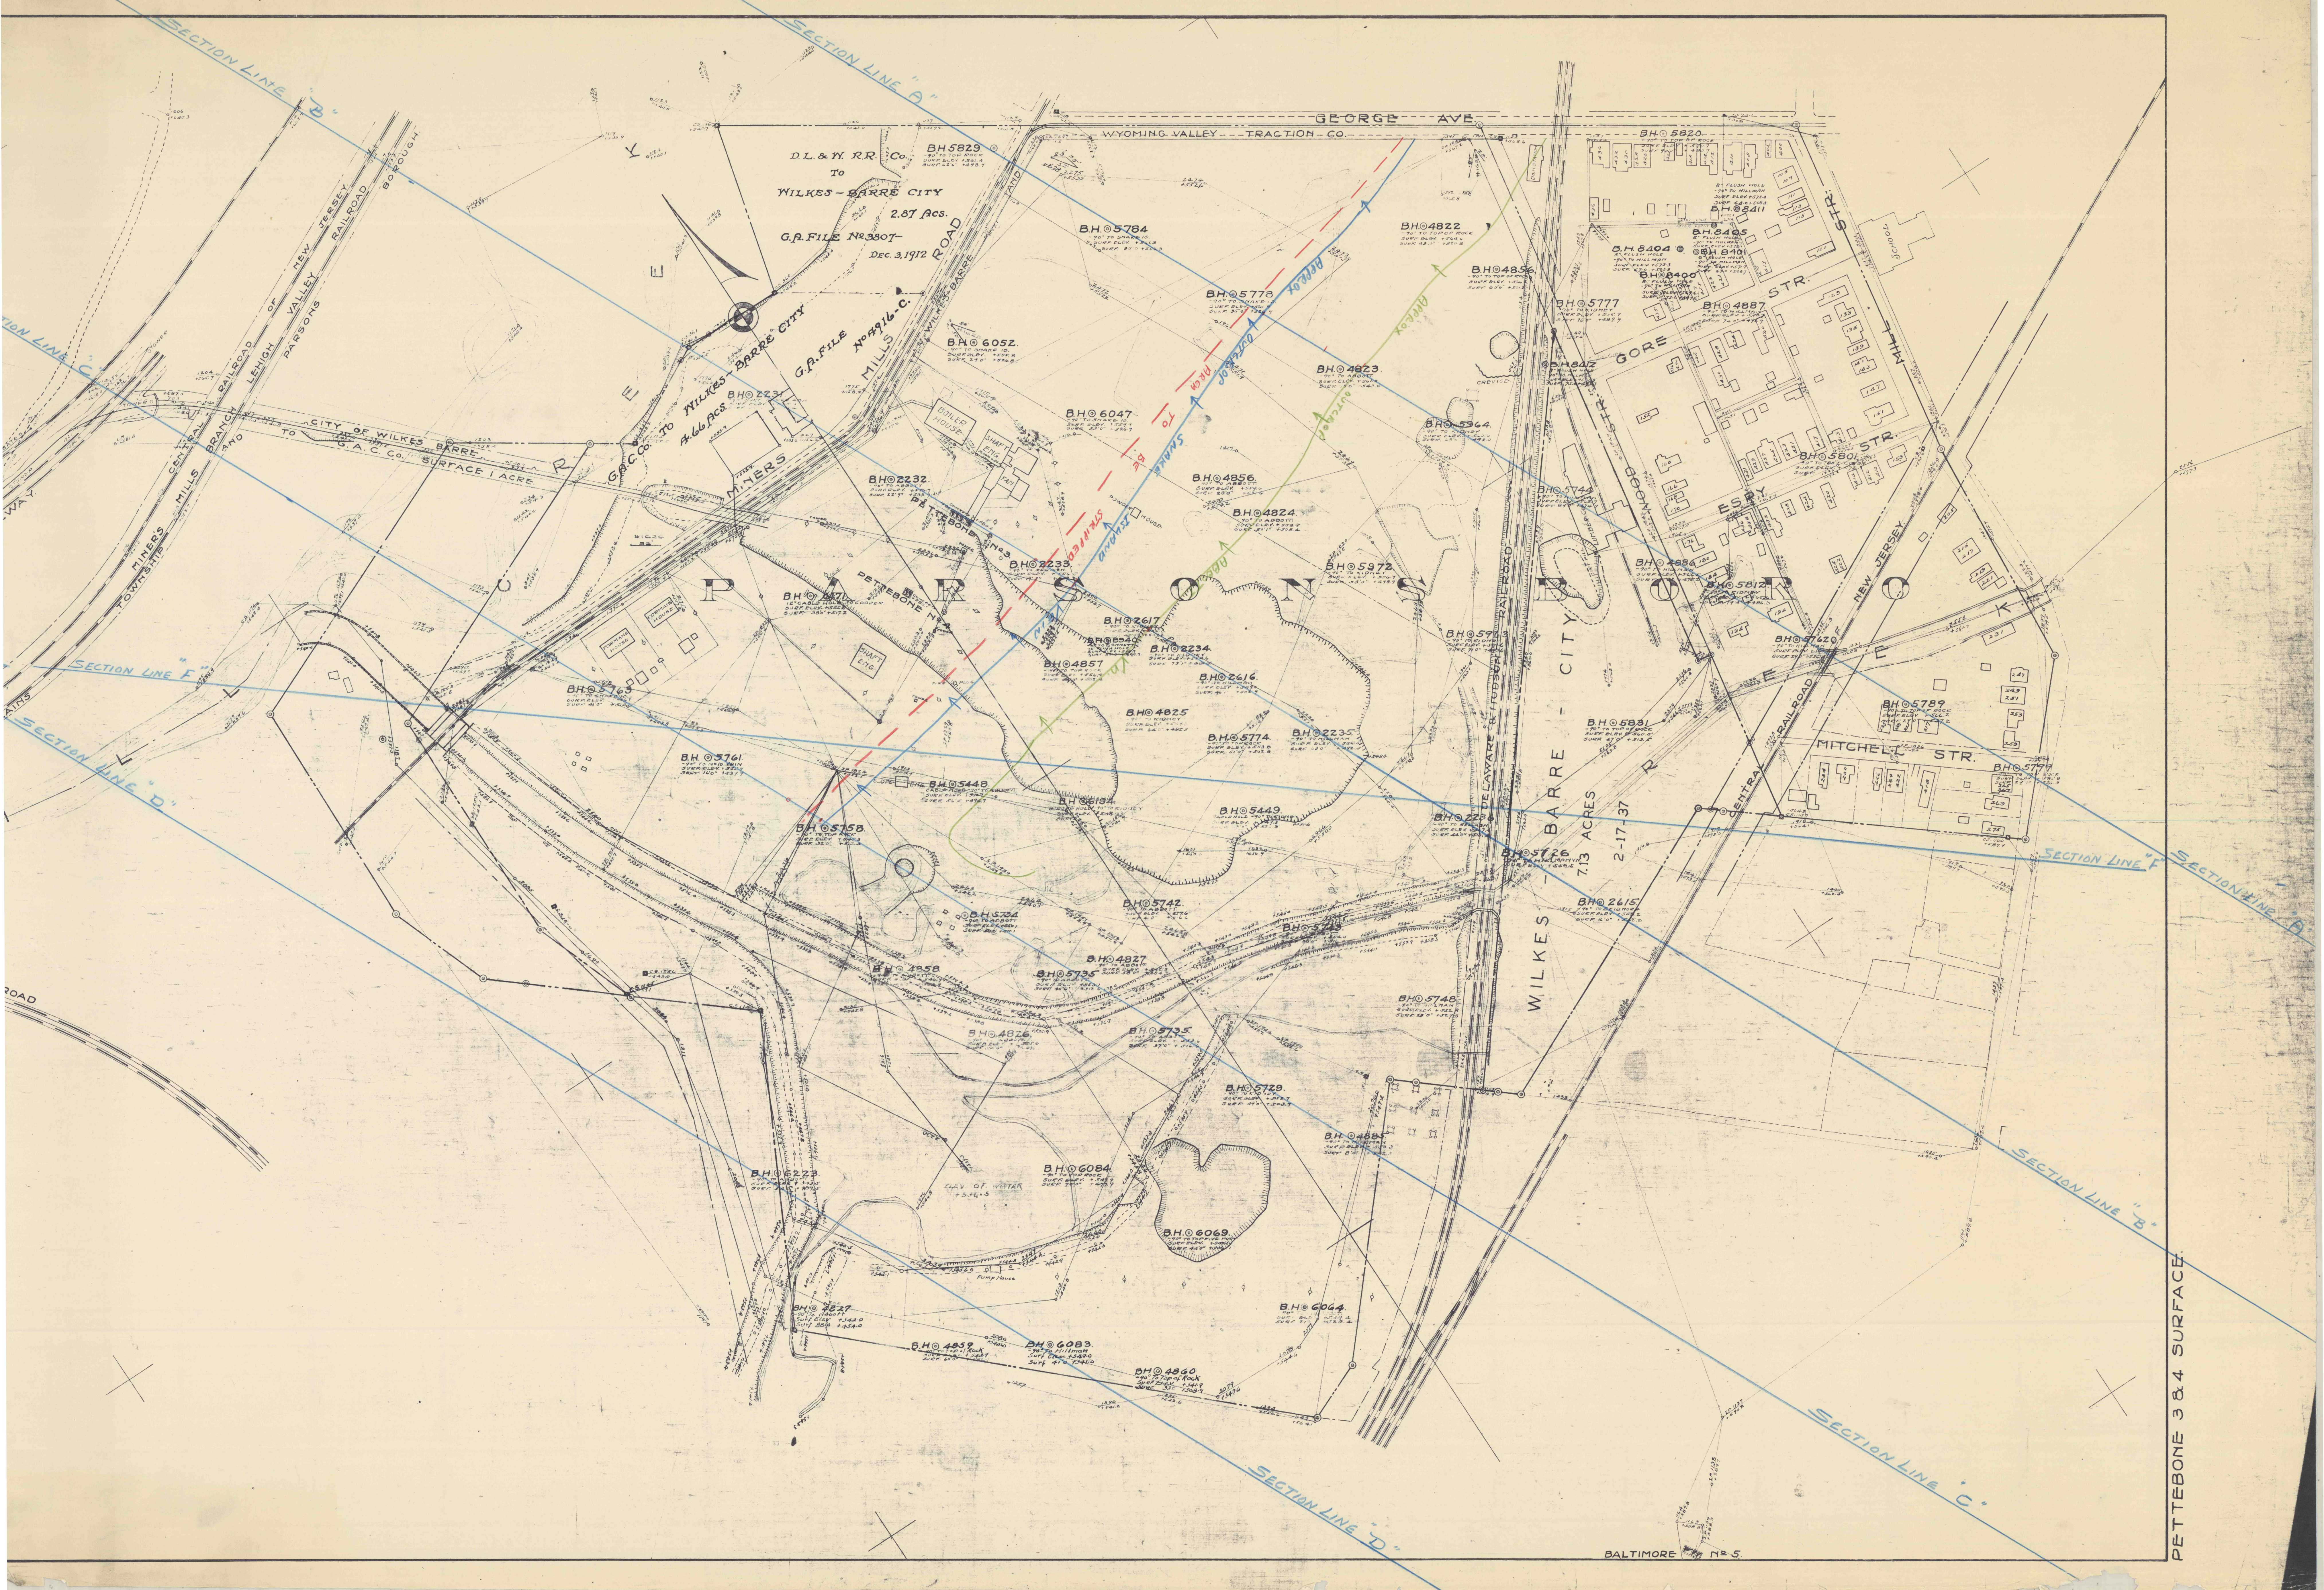

PETTEBONE 3 & 4 SURFACE.