


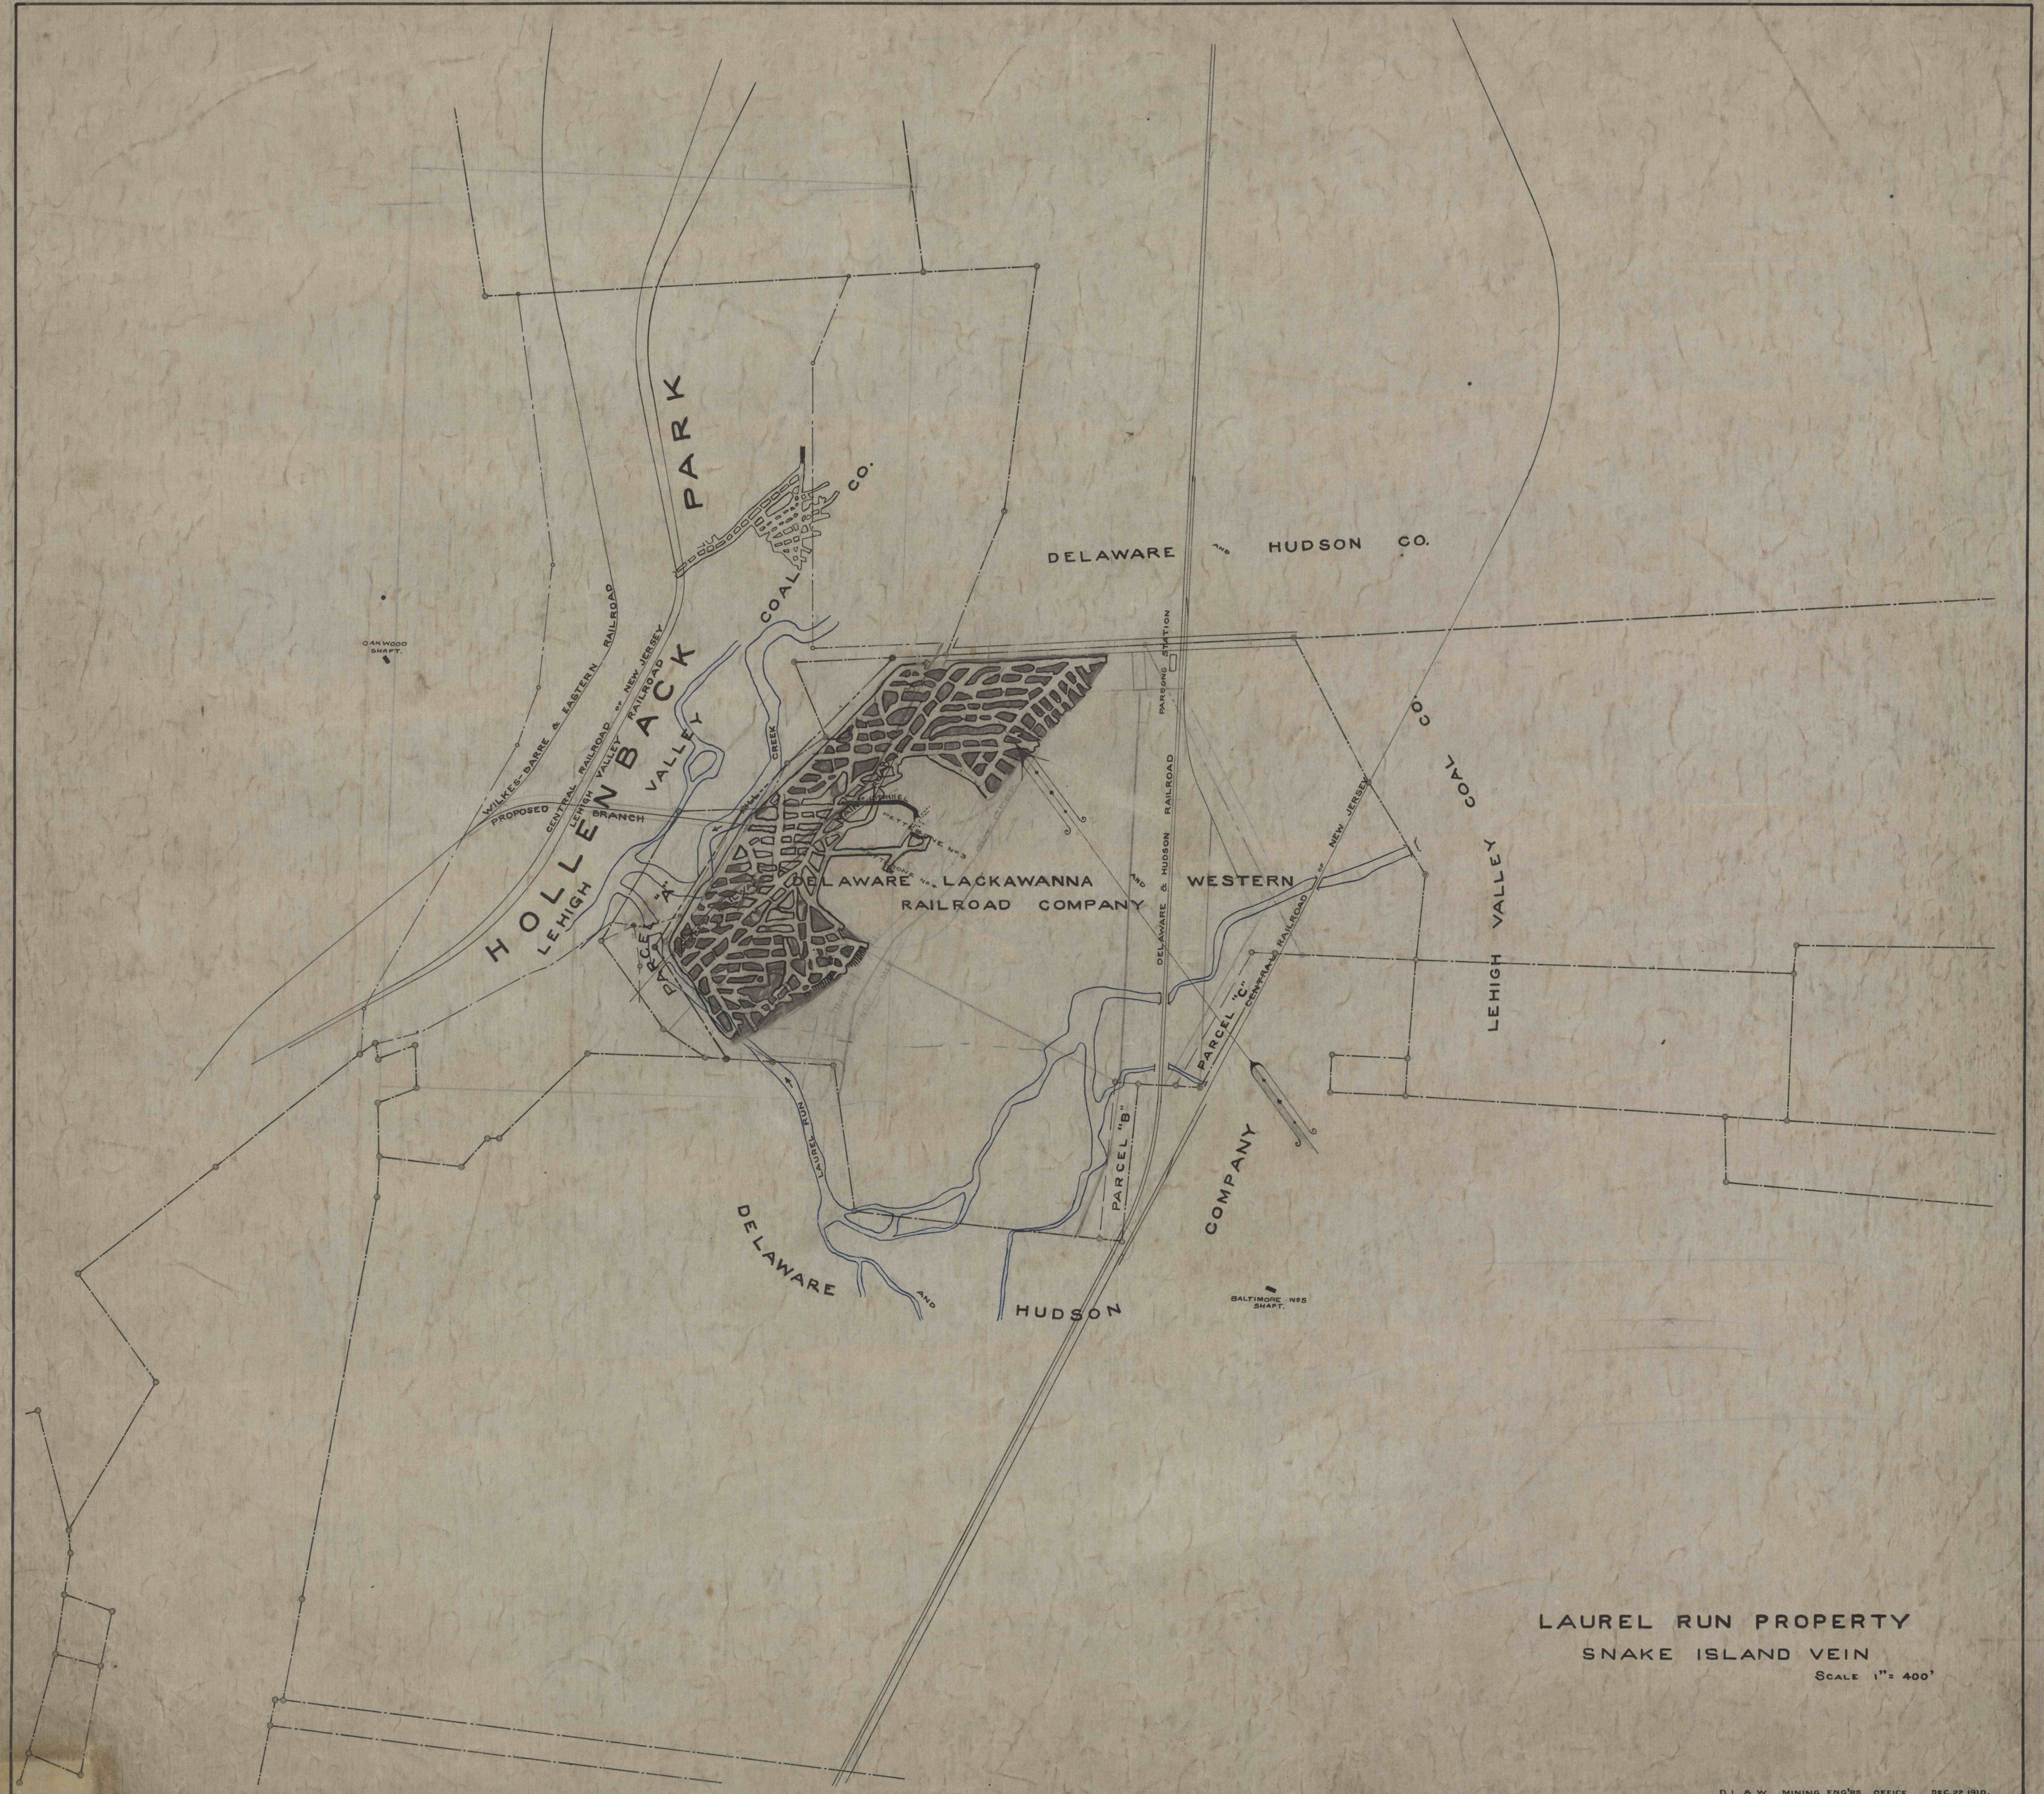

LAUREL RUN PROPERTY
SNAKE ISLAND VEIN
Scale 1" = 400'