


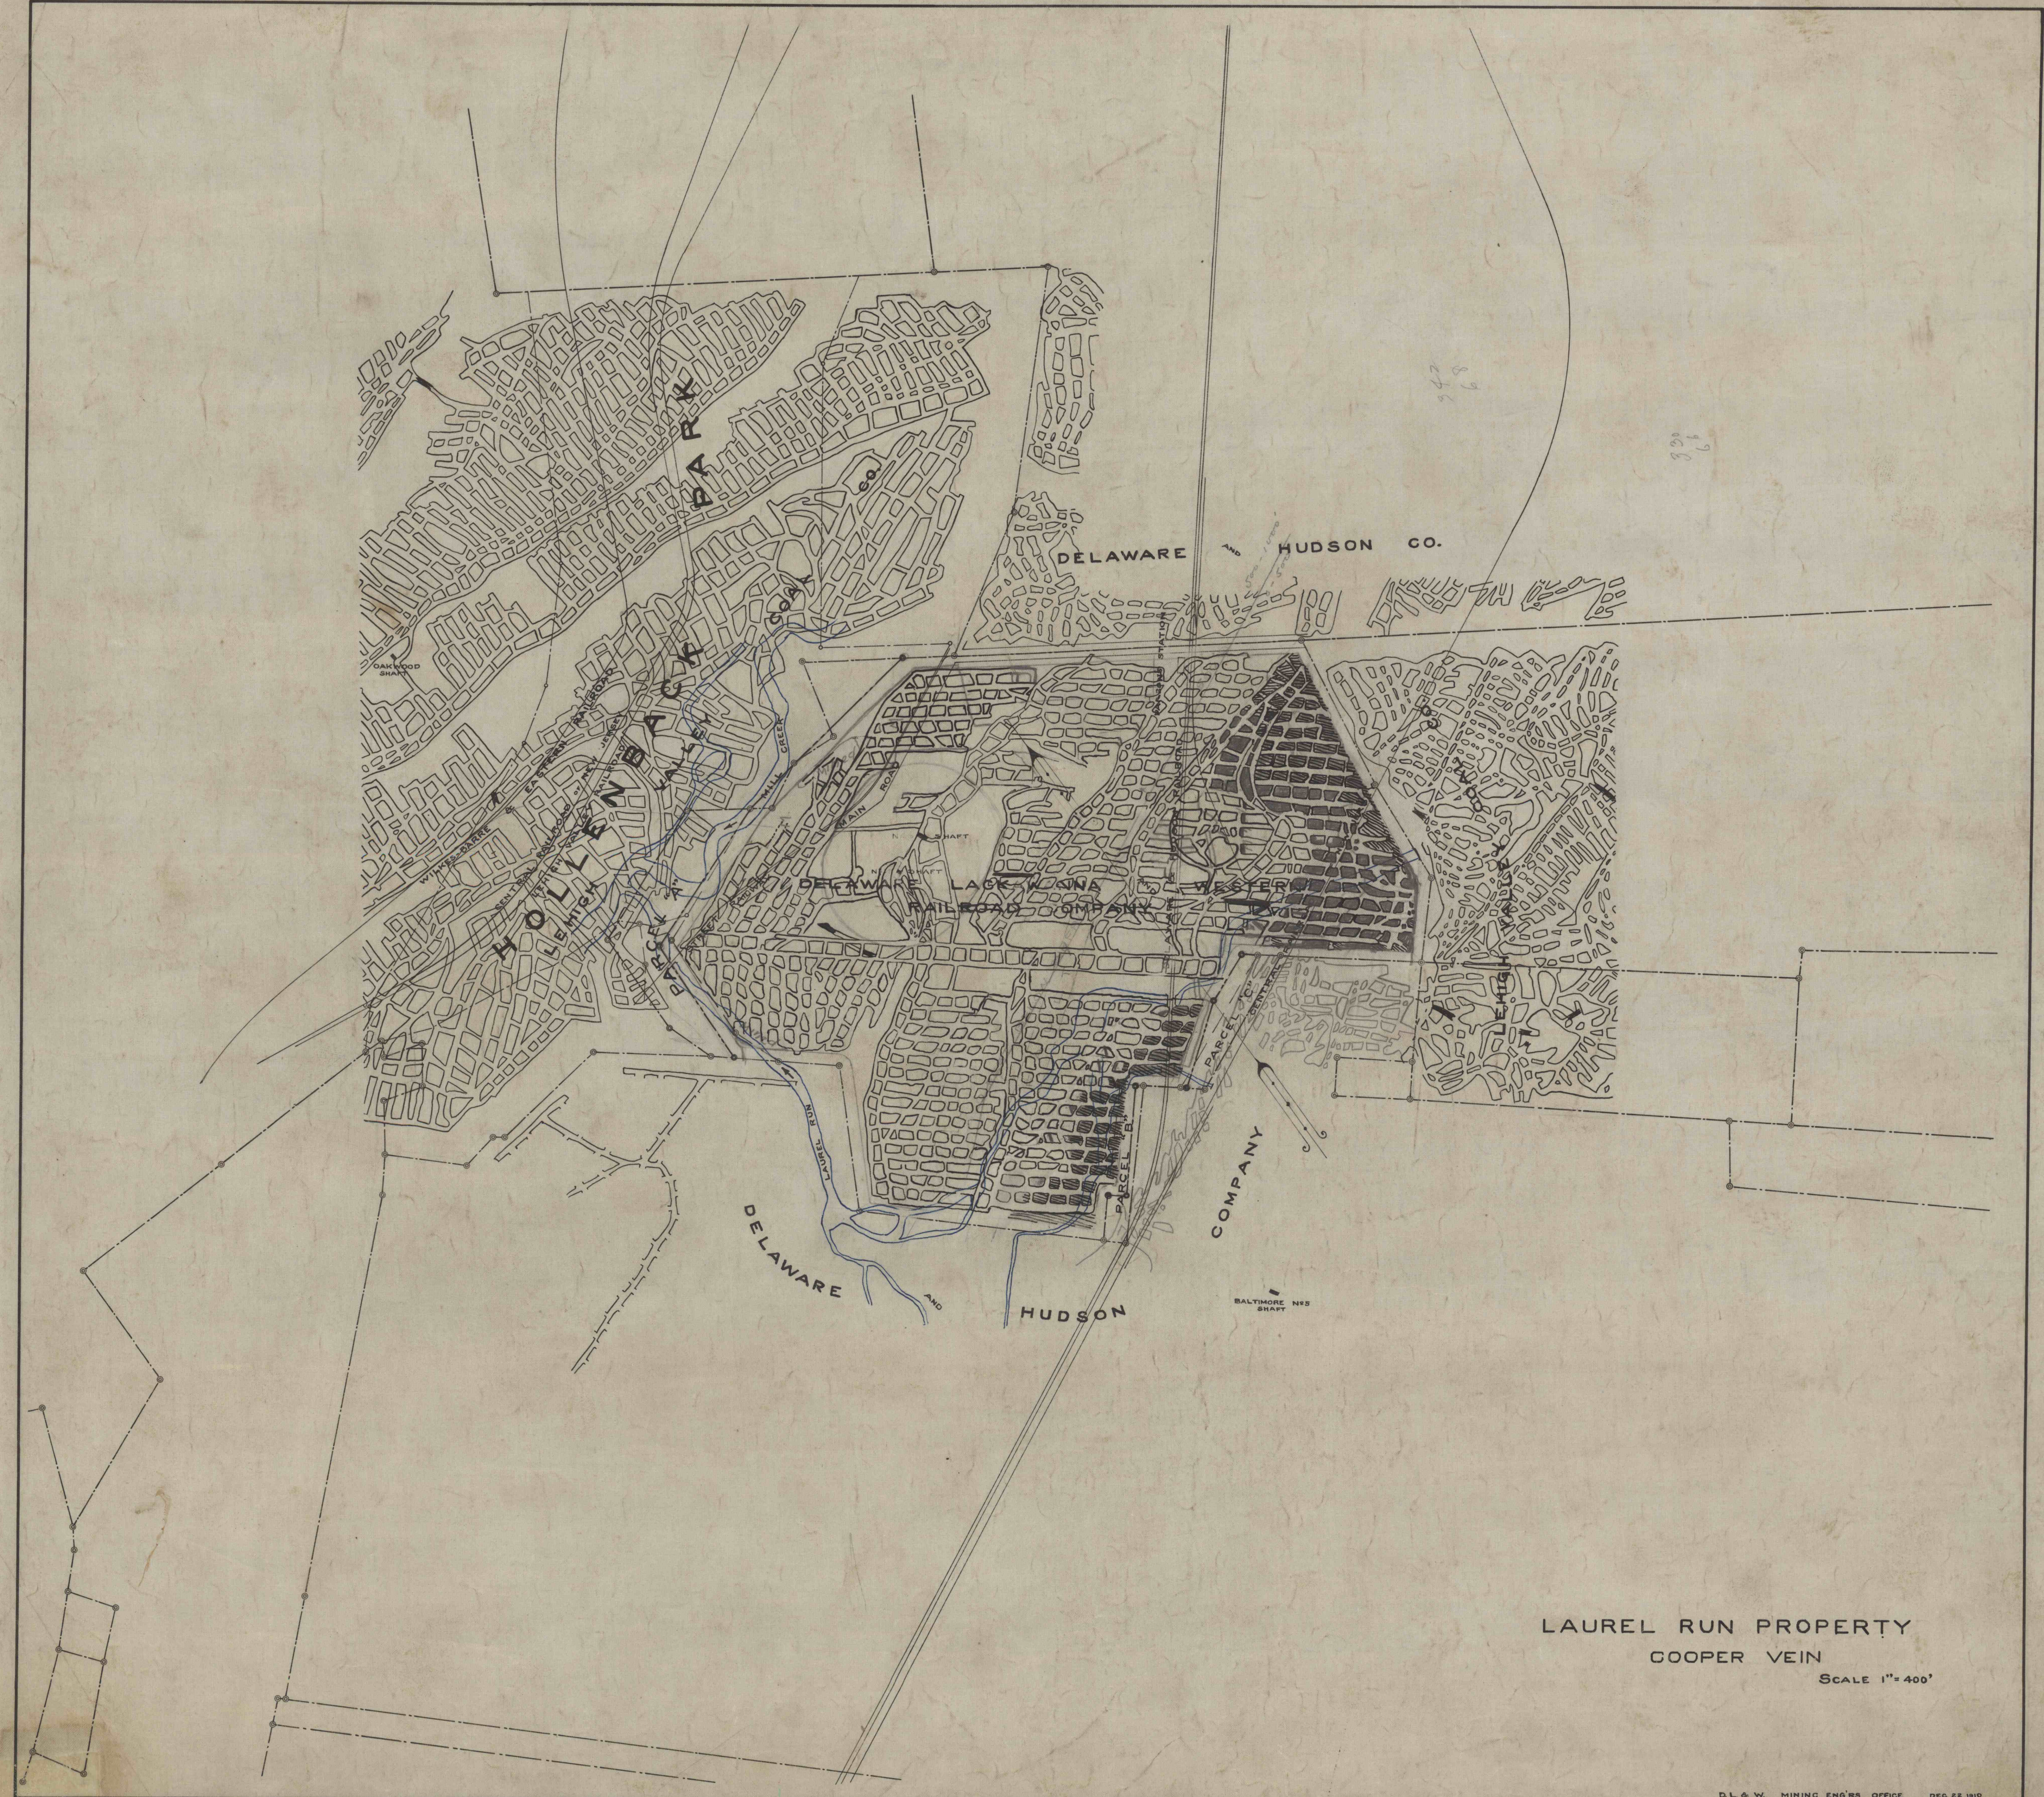

LAUREL RUN PROPERTY  
COOPER VEIN  
SCALE 1" = 400'