


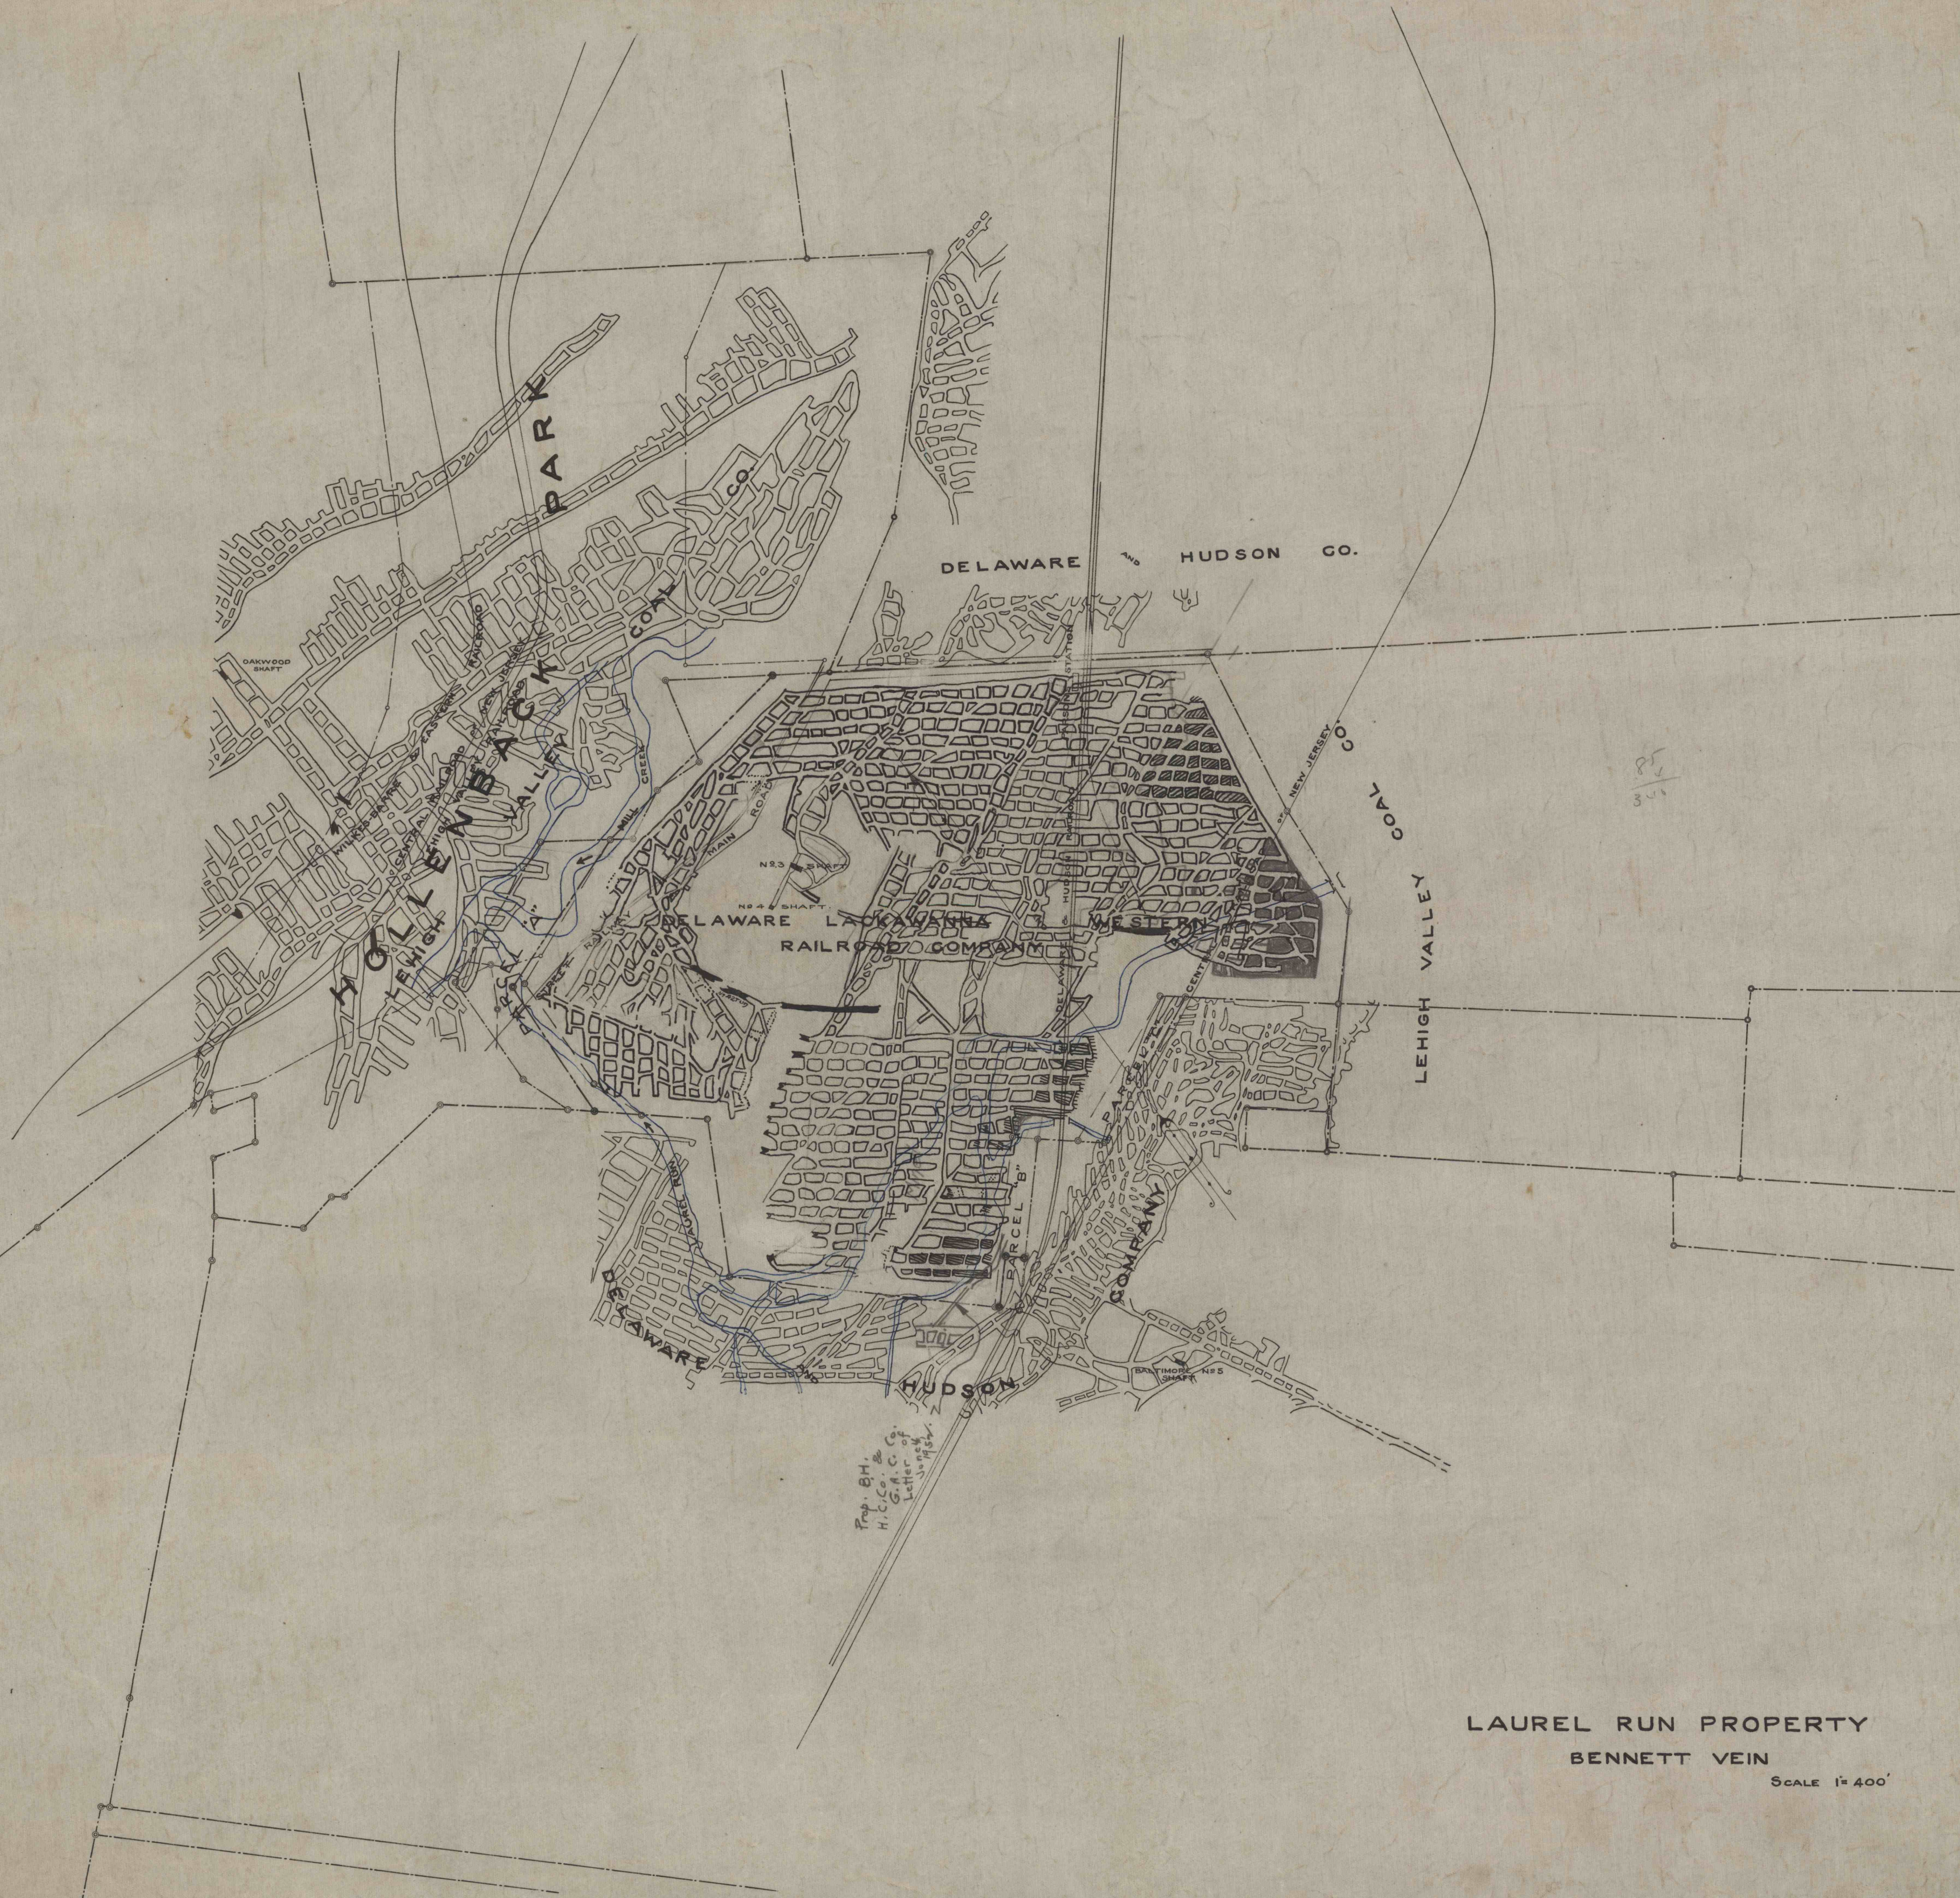

LAUREL RUN PROPERTY
BENNETT VEIN
Scale 1"=400'