


PETTEBONE 3 & 4 SKIDMORE VEIN.

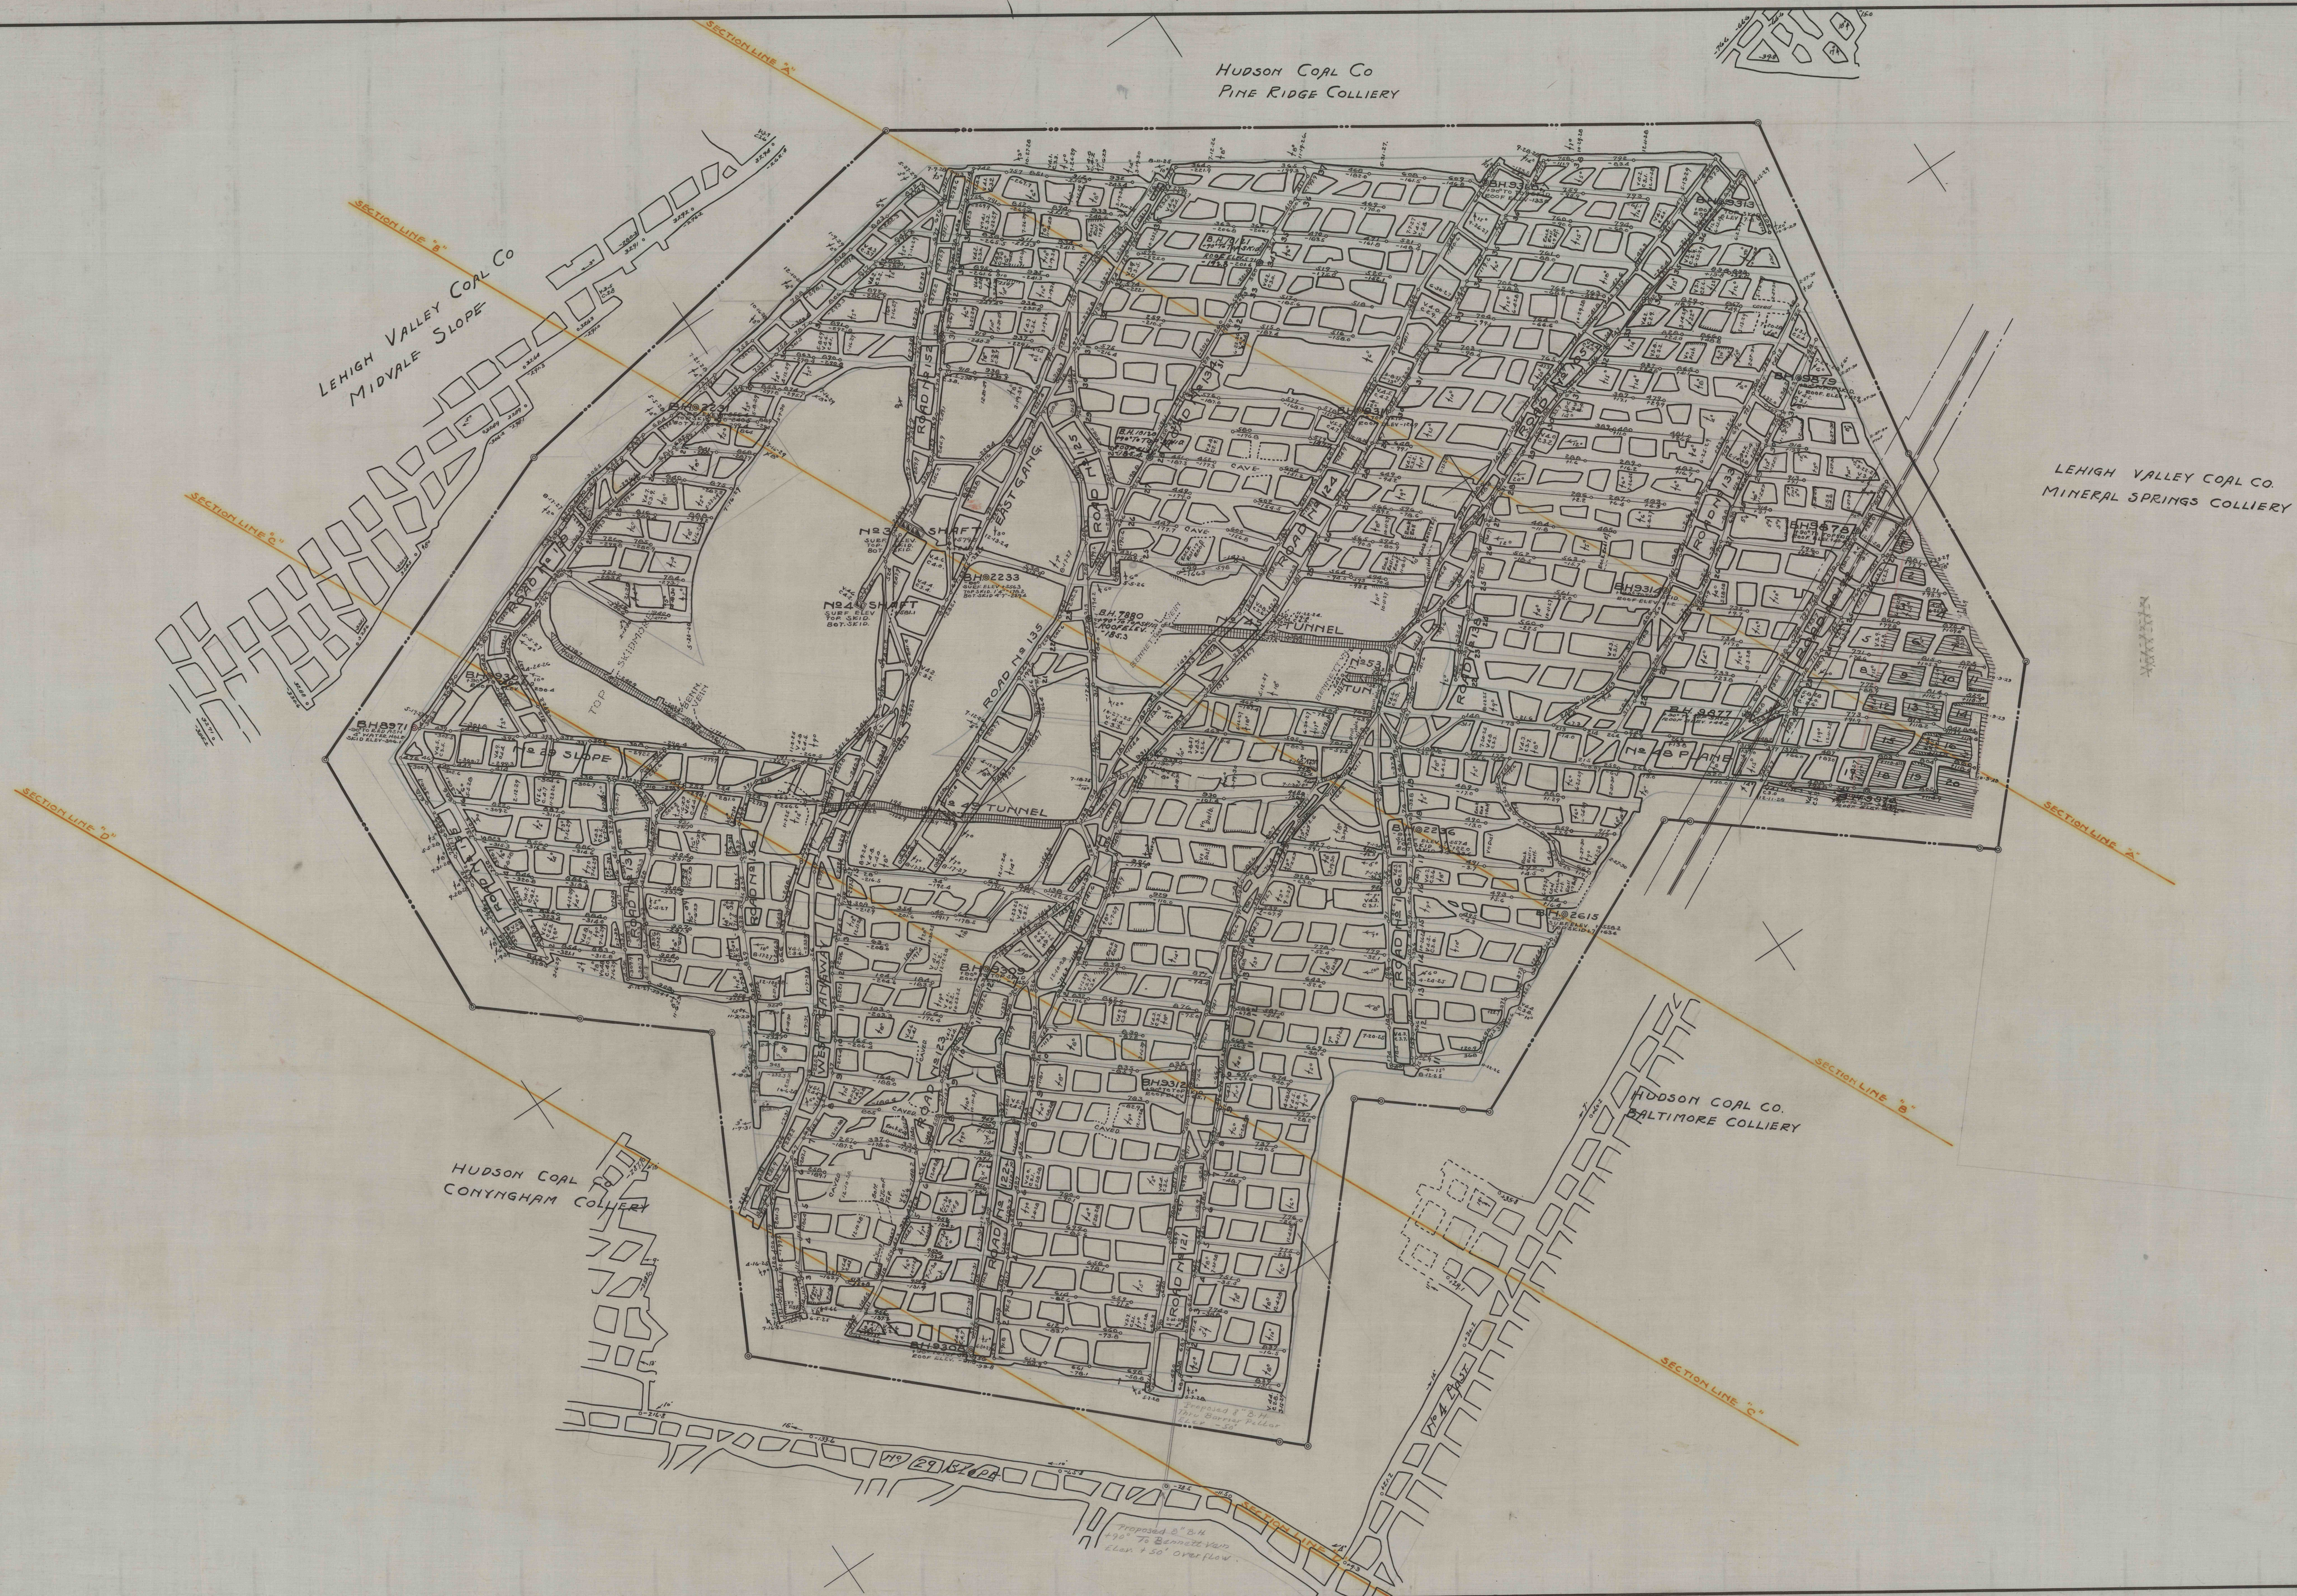

PETTEBONE 3 & 4 BOTT. SKIDMORE VEIN.