


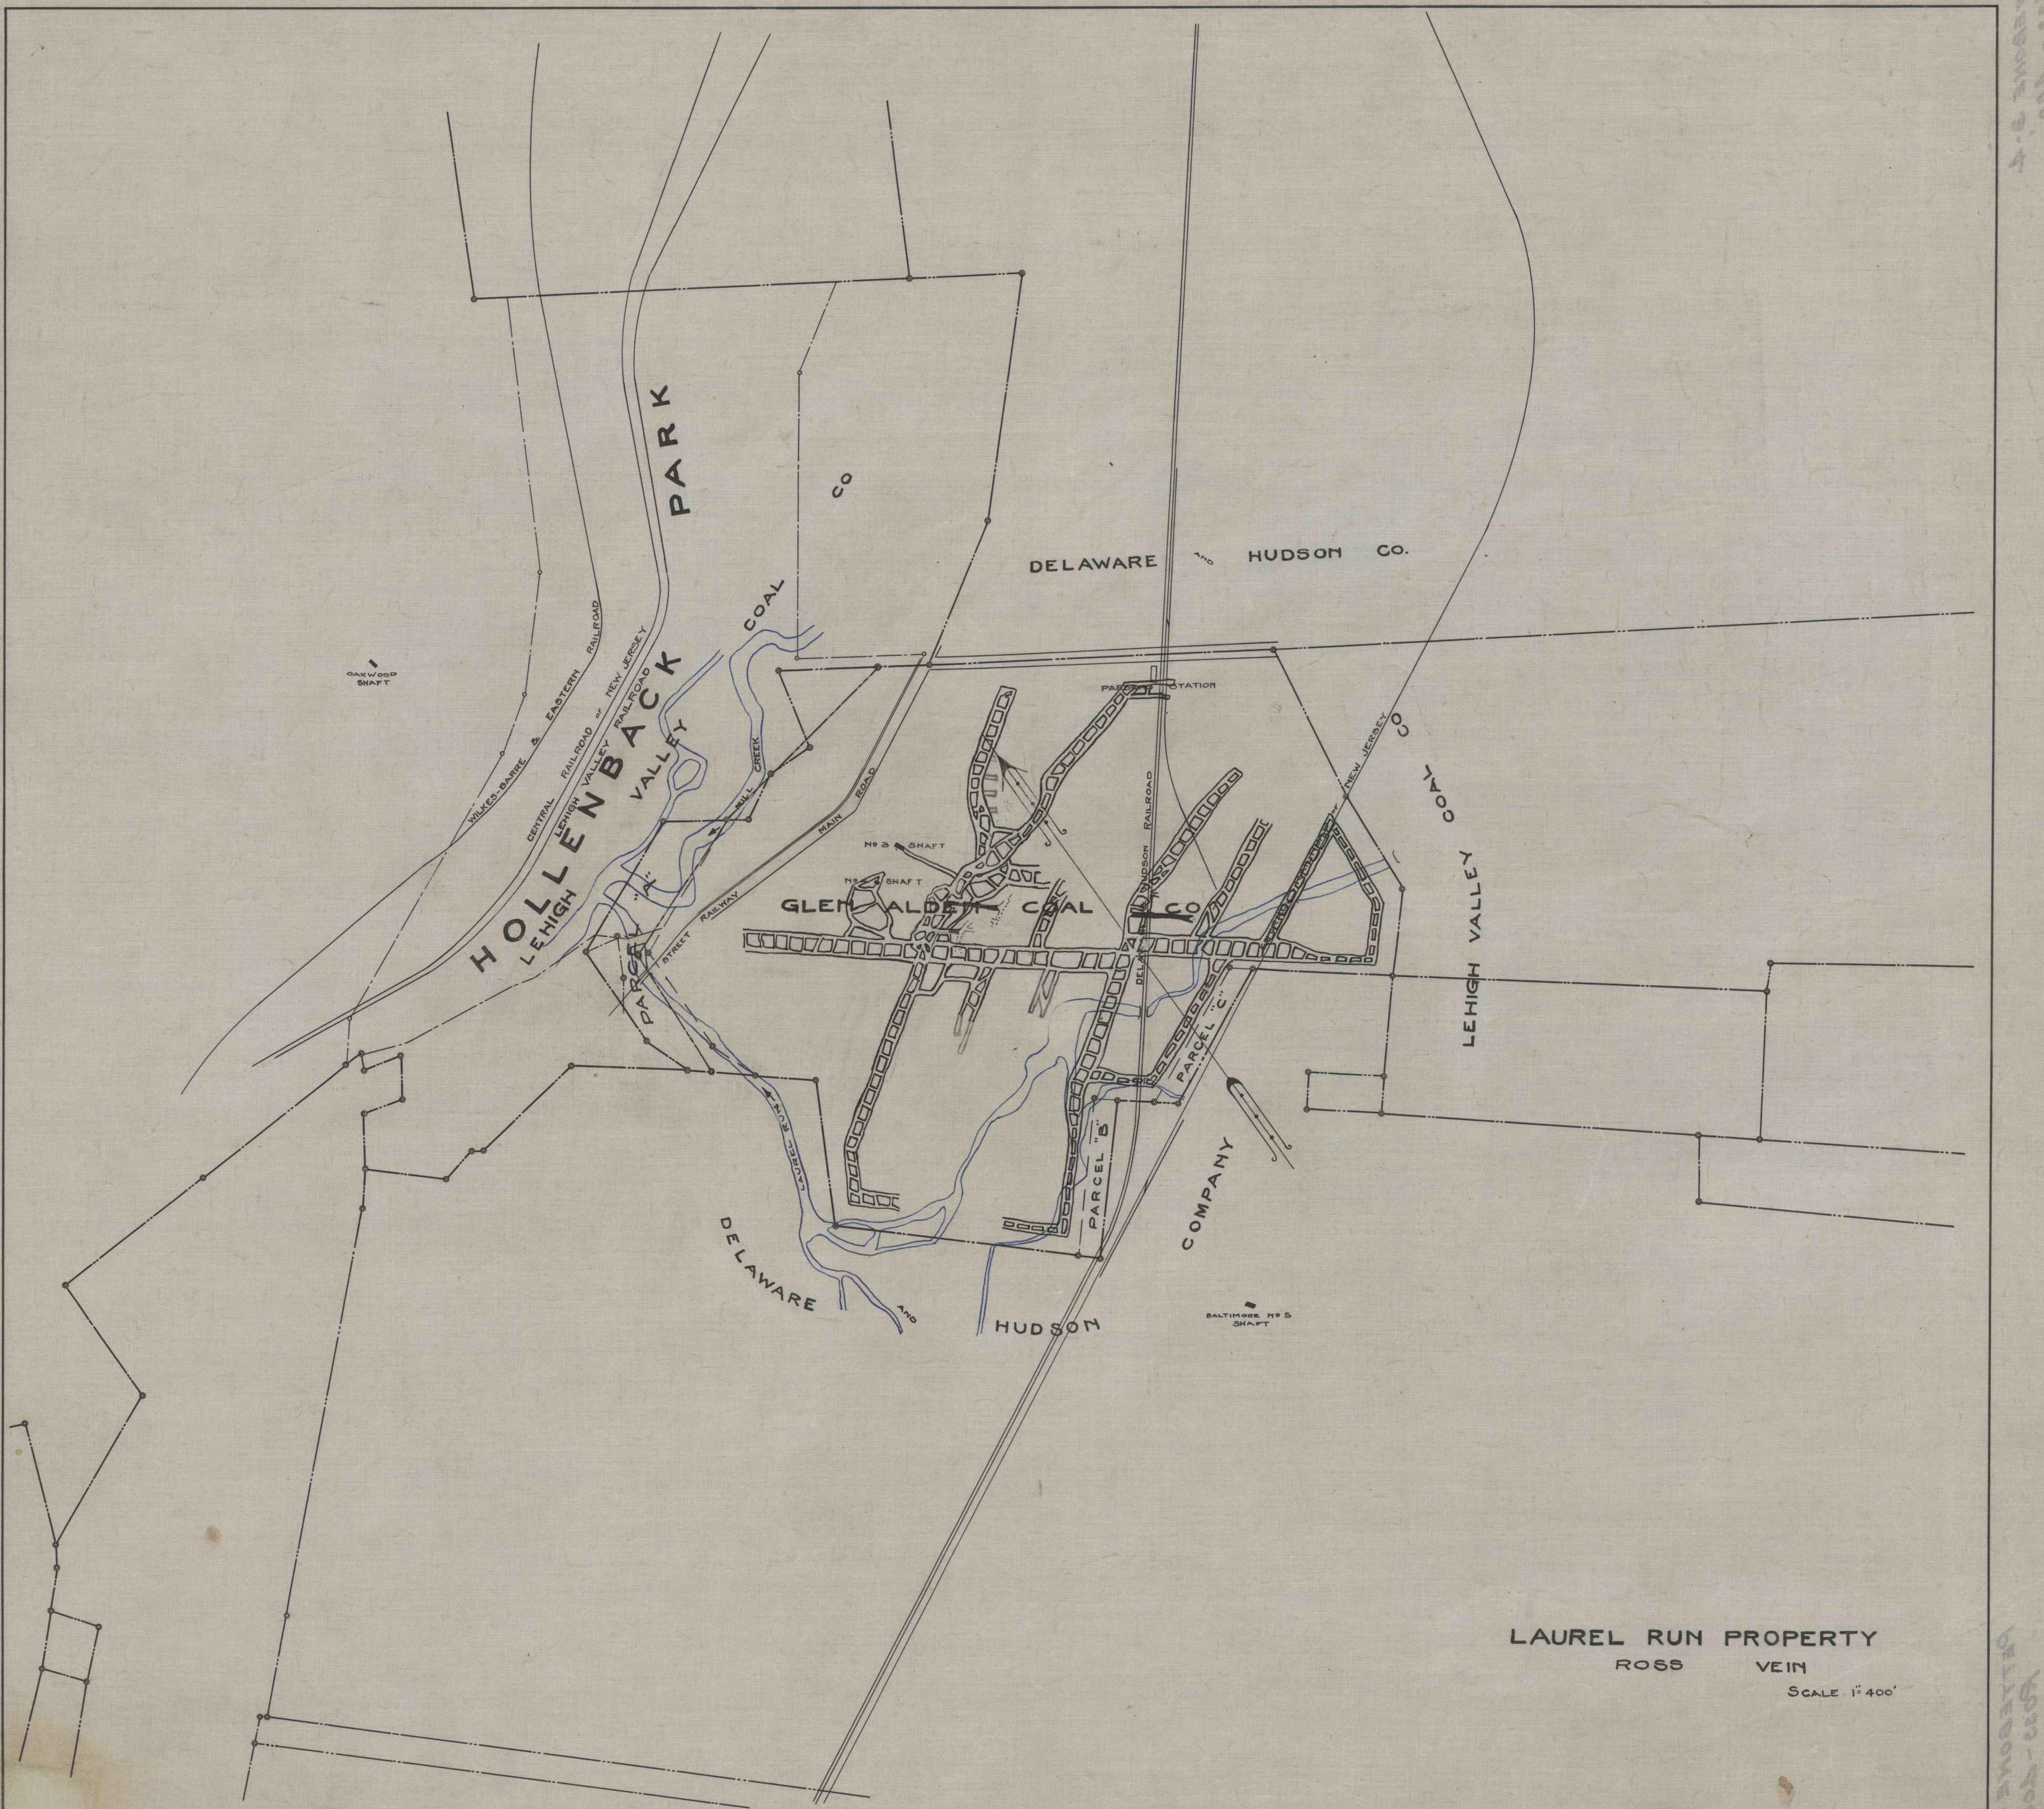

LAUREL RUN PROPERTY
ROSS VEIN
SCALE 1"=400'


