


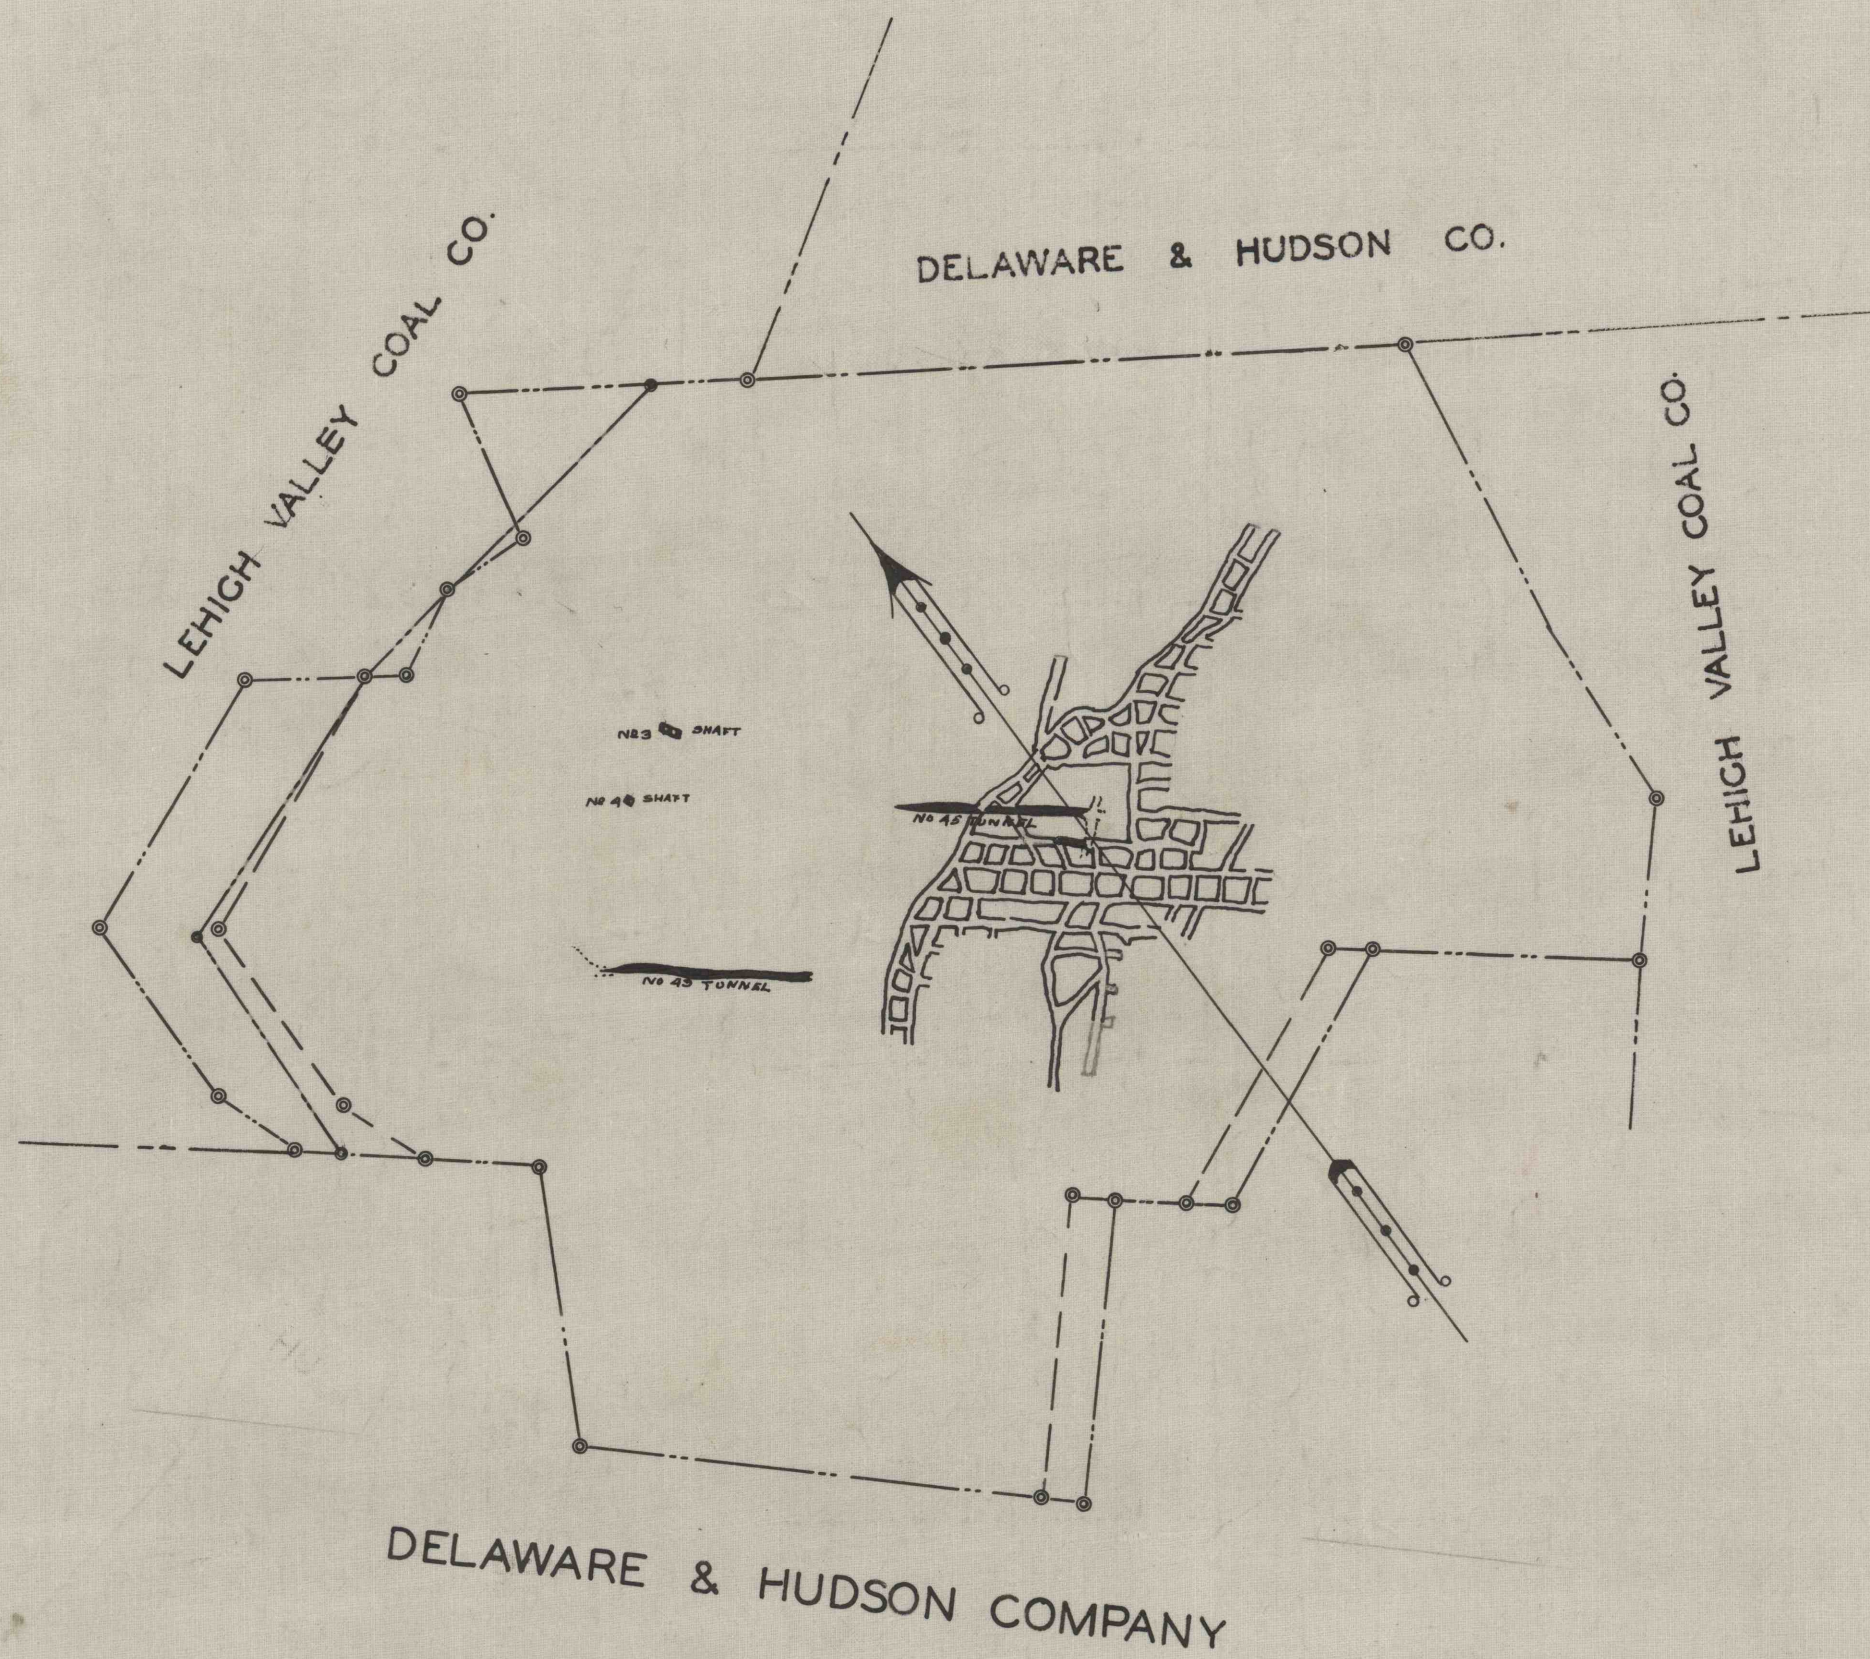

LAUREL RUN PROPERTY  
TOP SKIDMORE VEIN  
SCALE 1"=400'