


3015

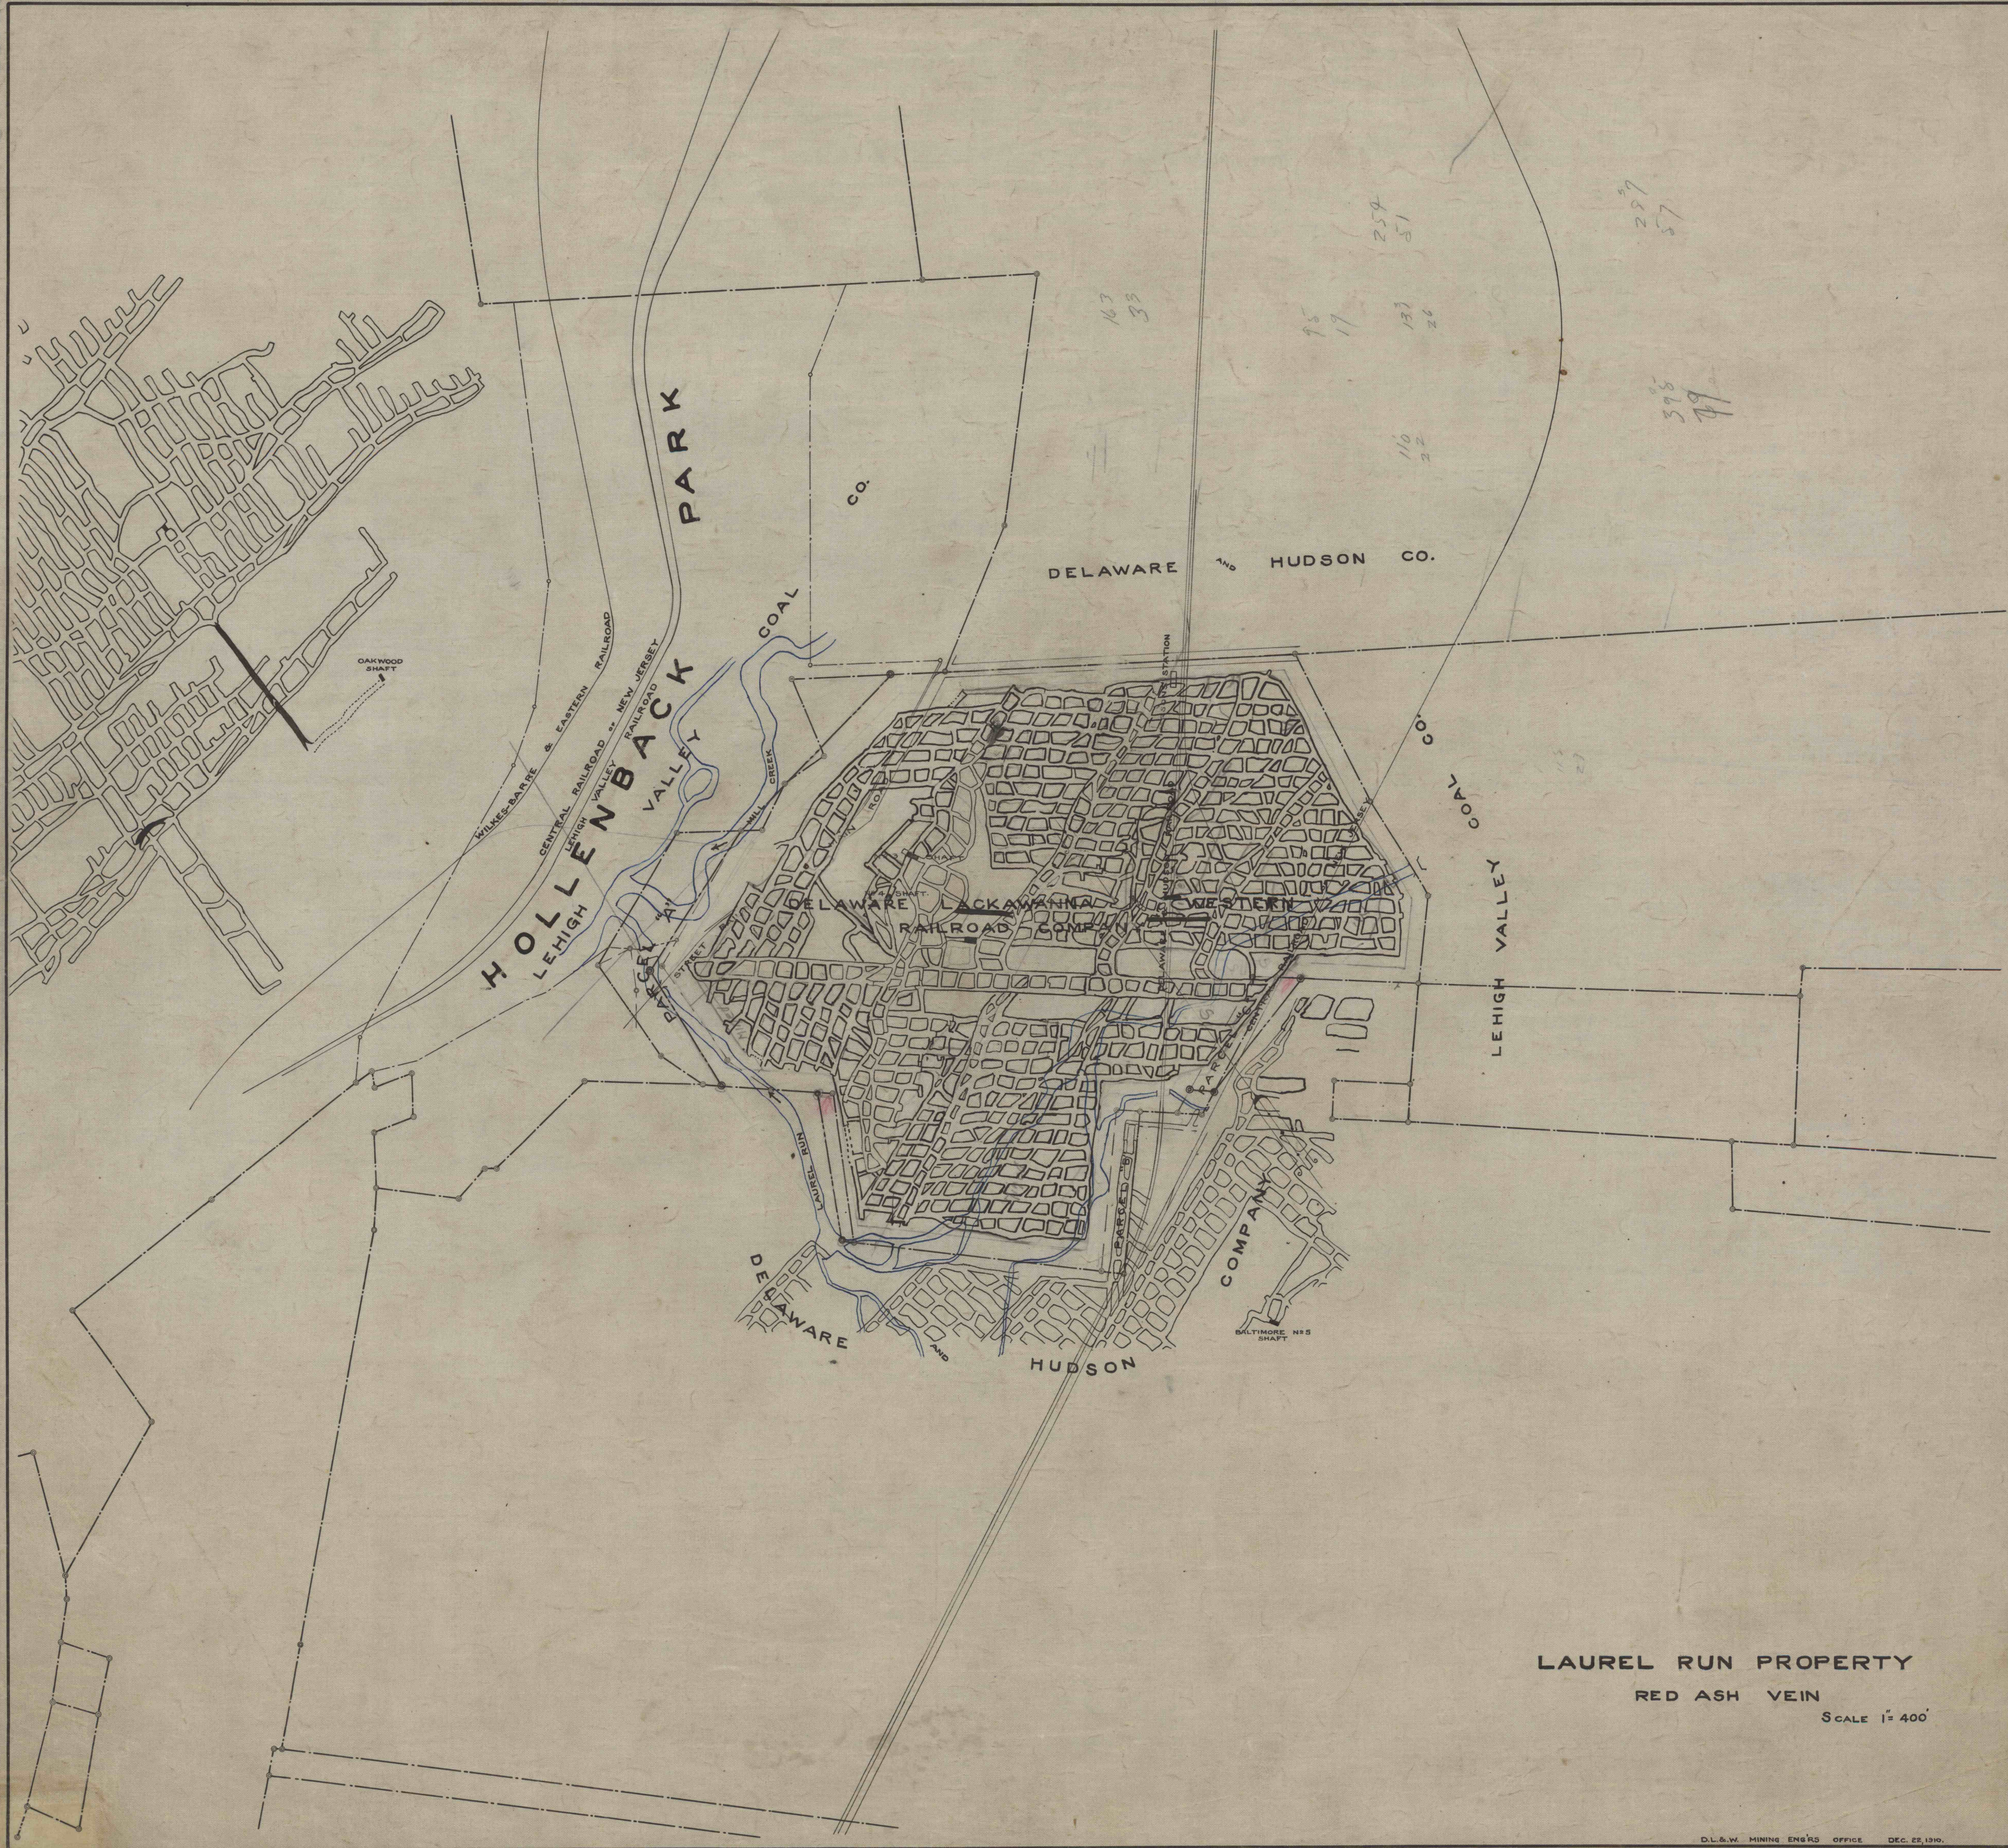

3015