


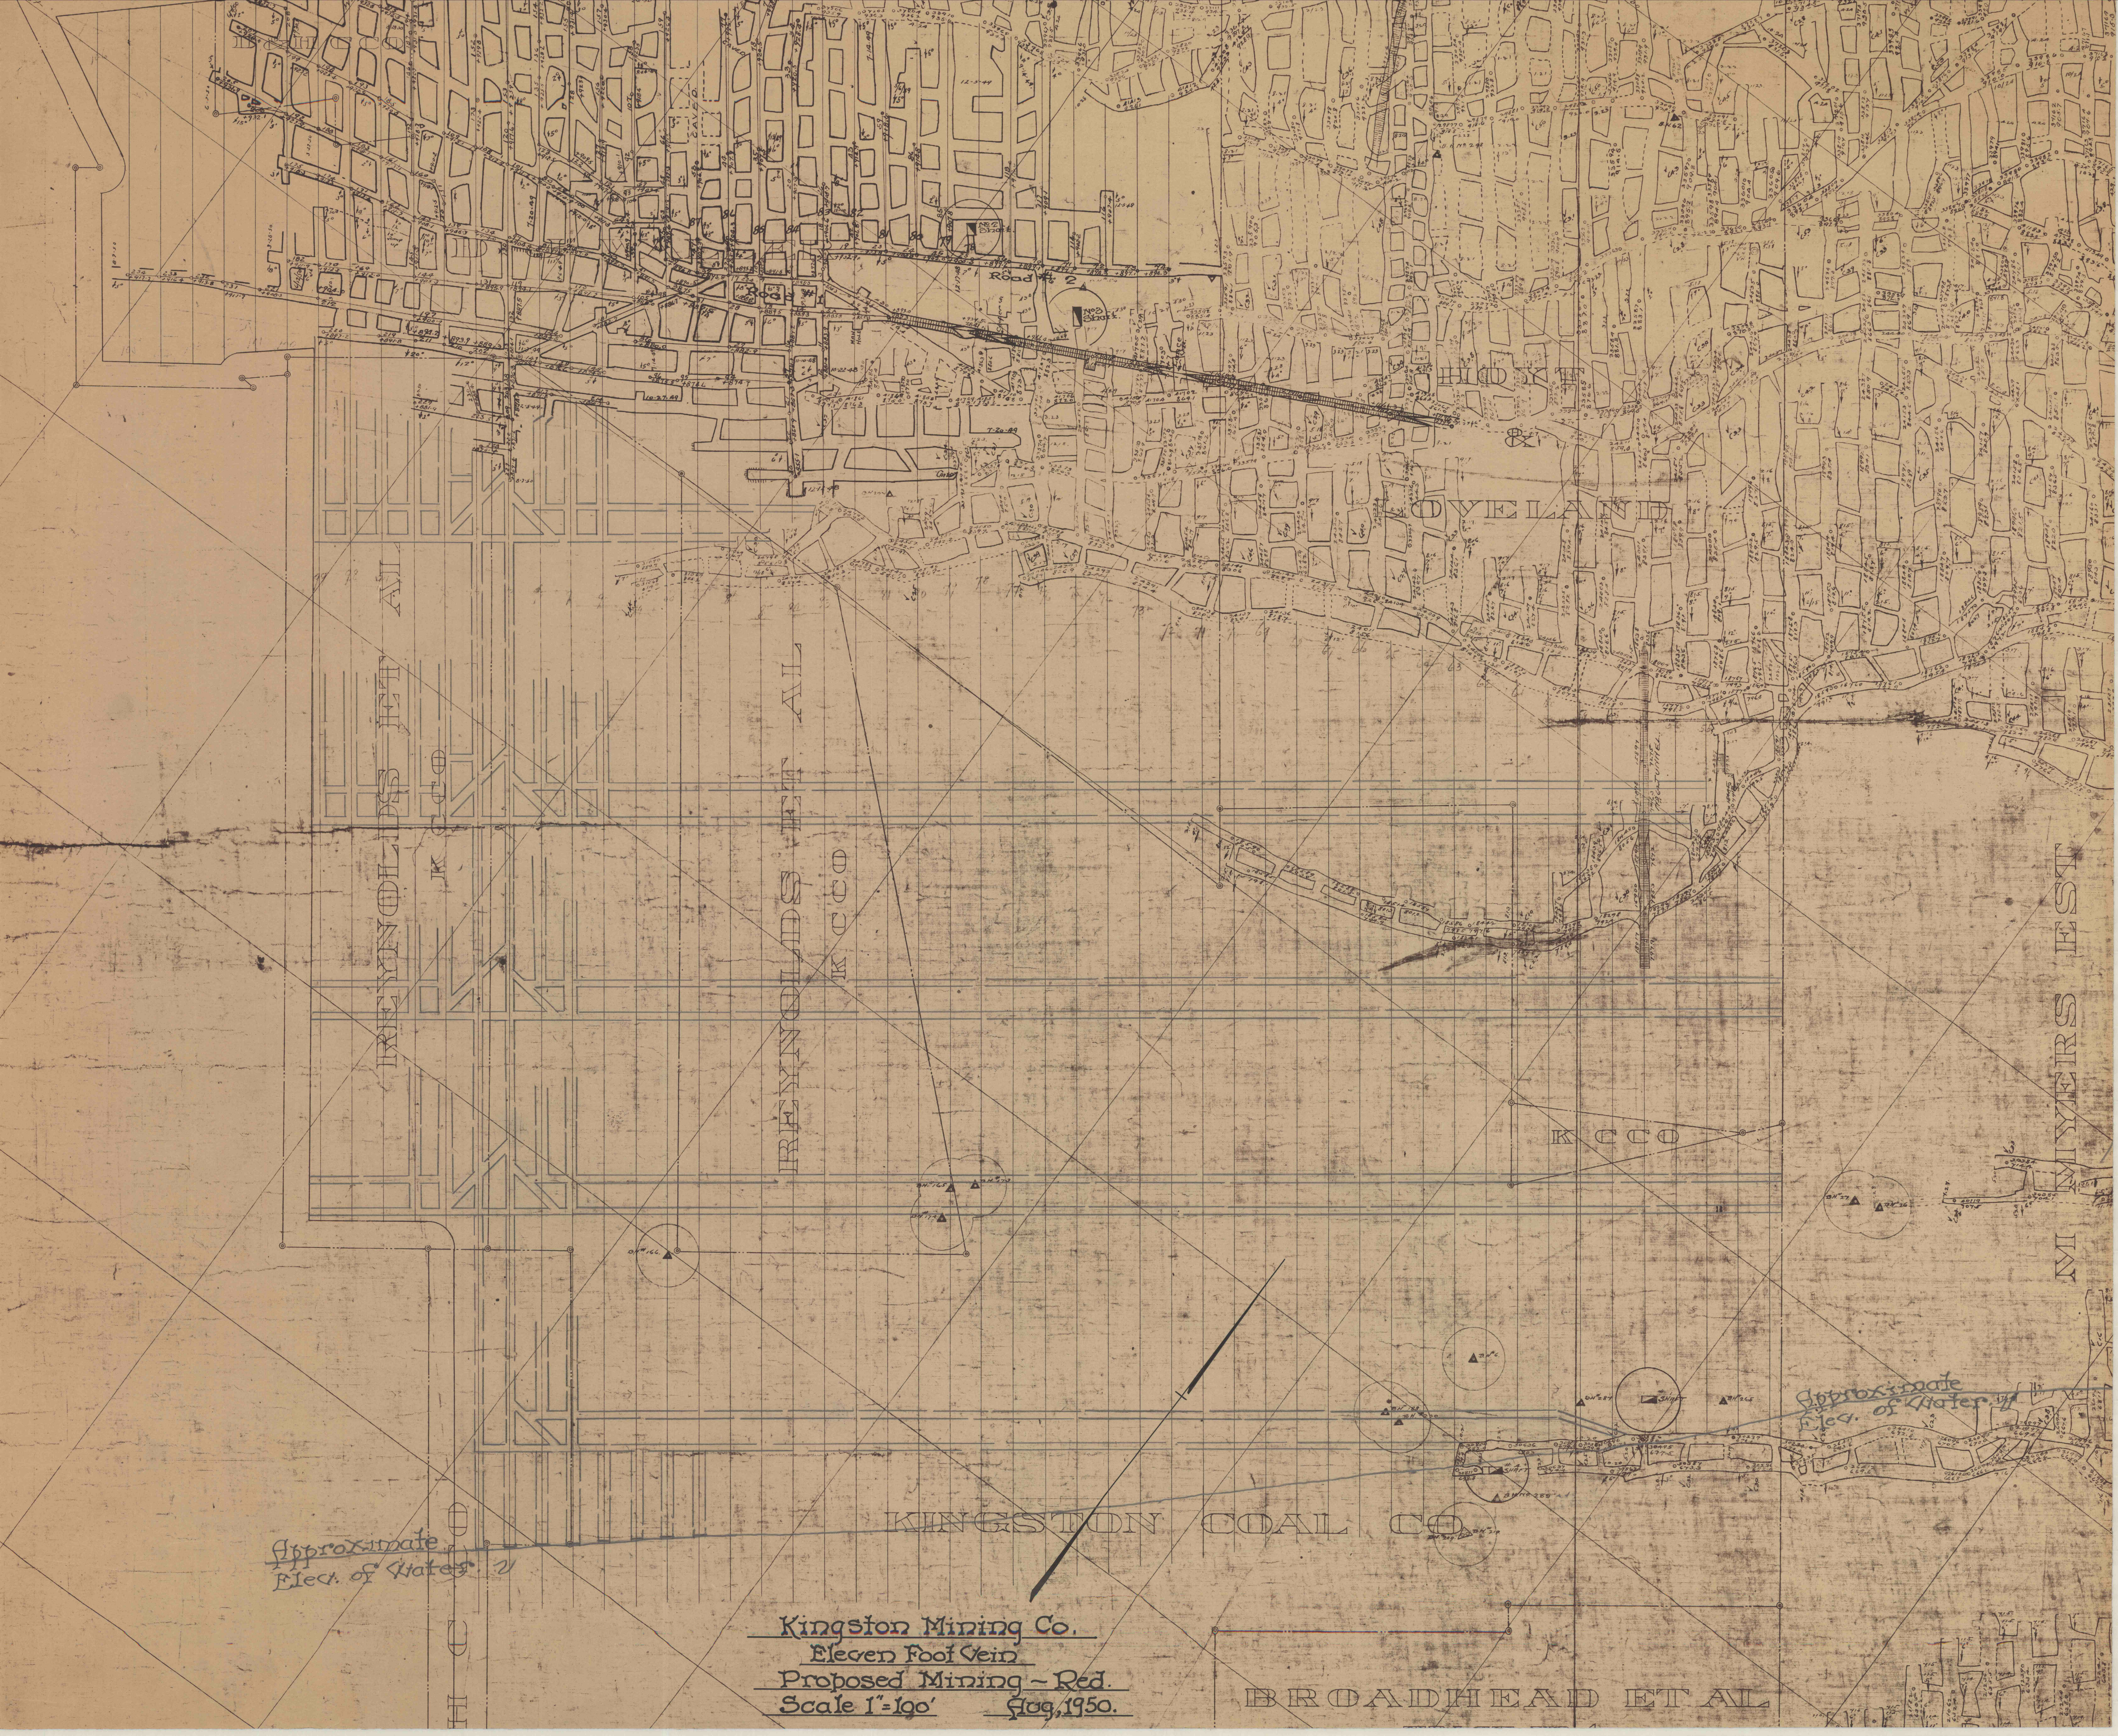

Approximate
Elev. of Water

Kingston Mining Co.
Eleven Foot Vein
Proposed Mining - Red.
Scale 1"=100' Aug, 1950.

BROADHEAD ET AL