


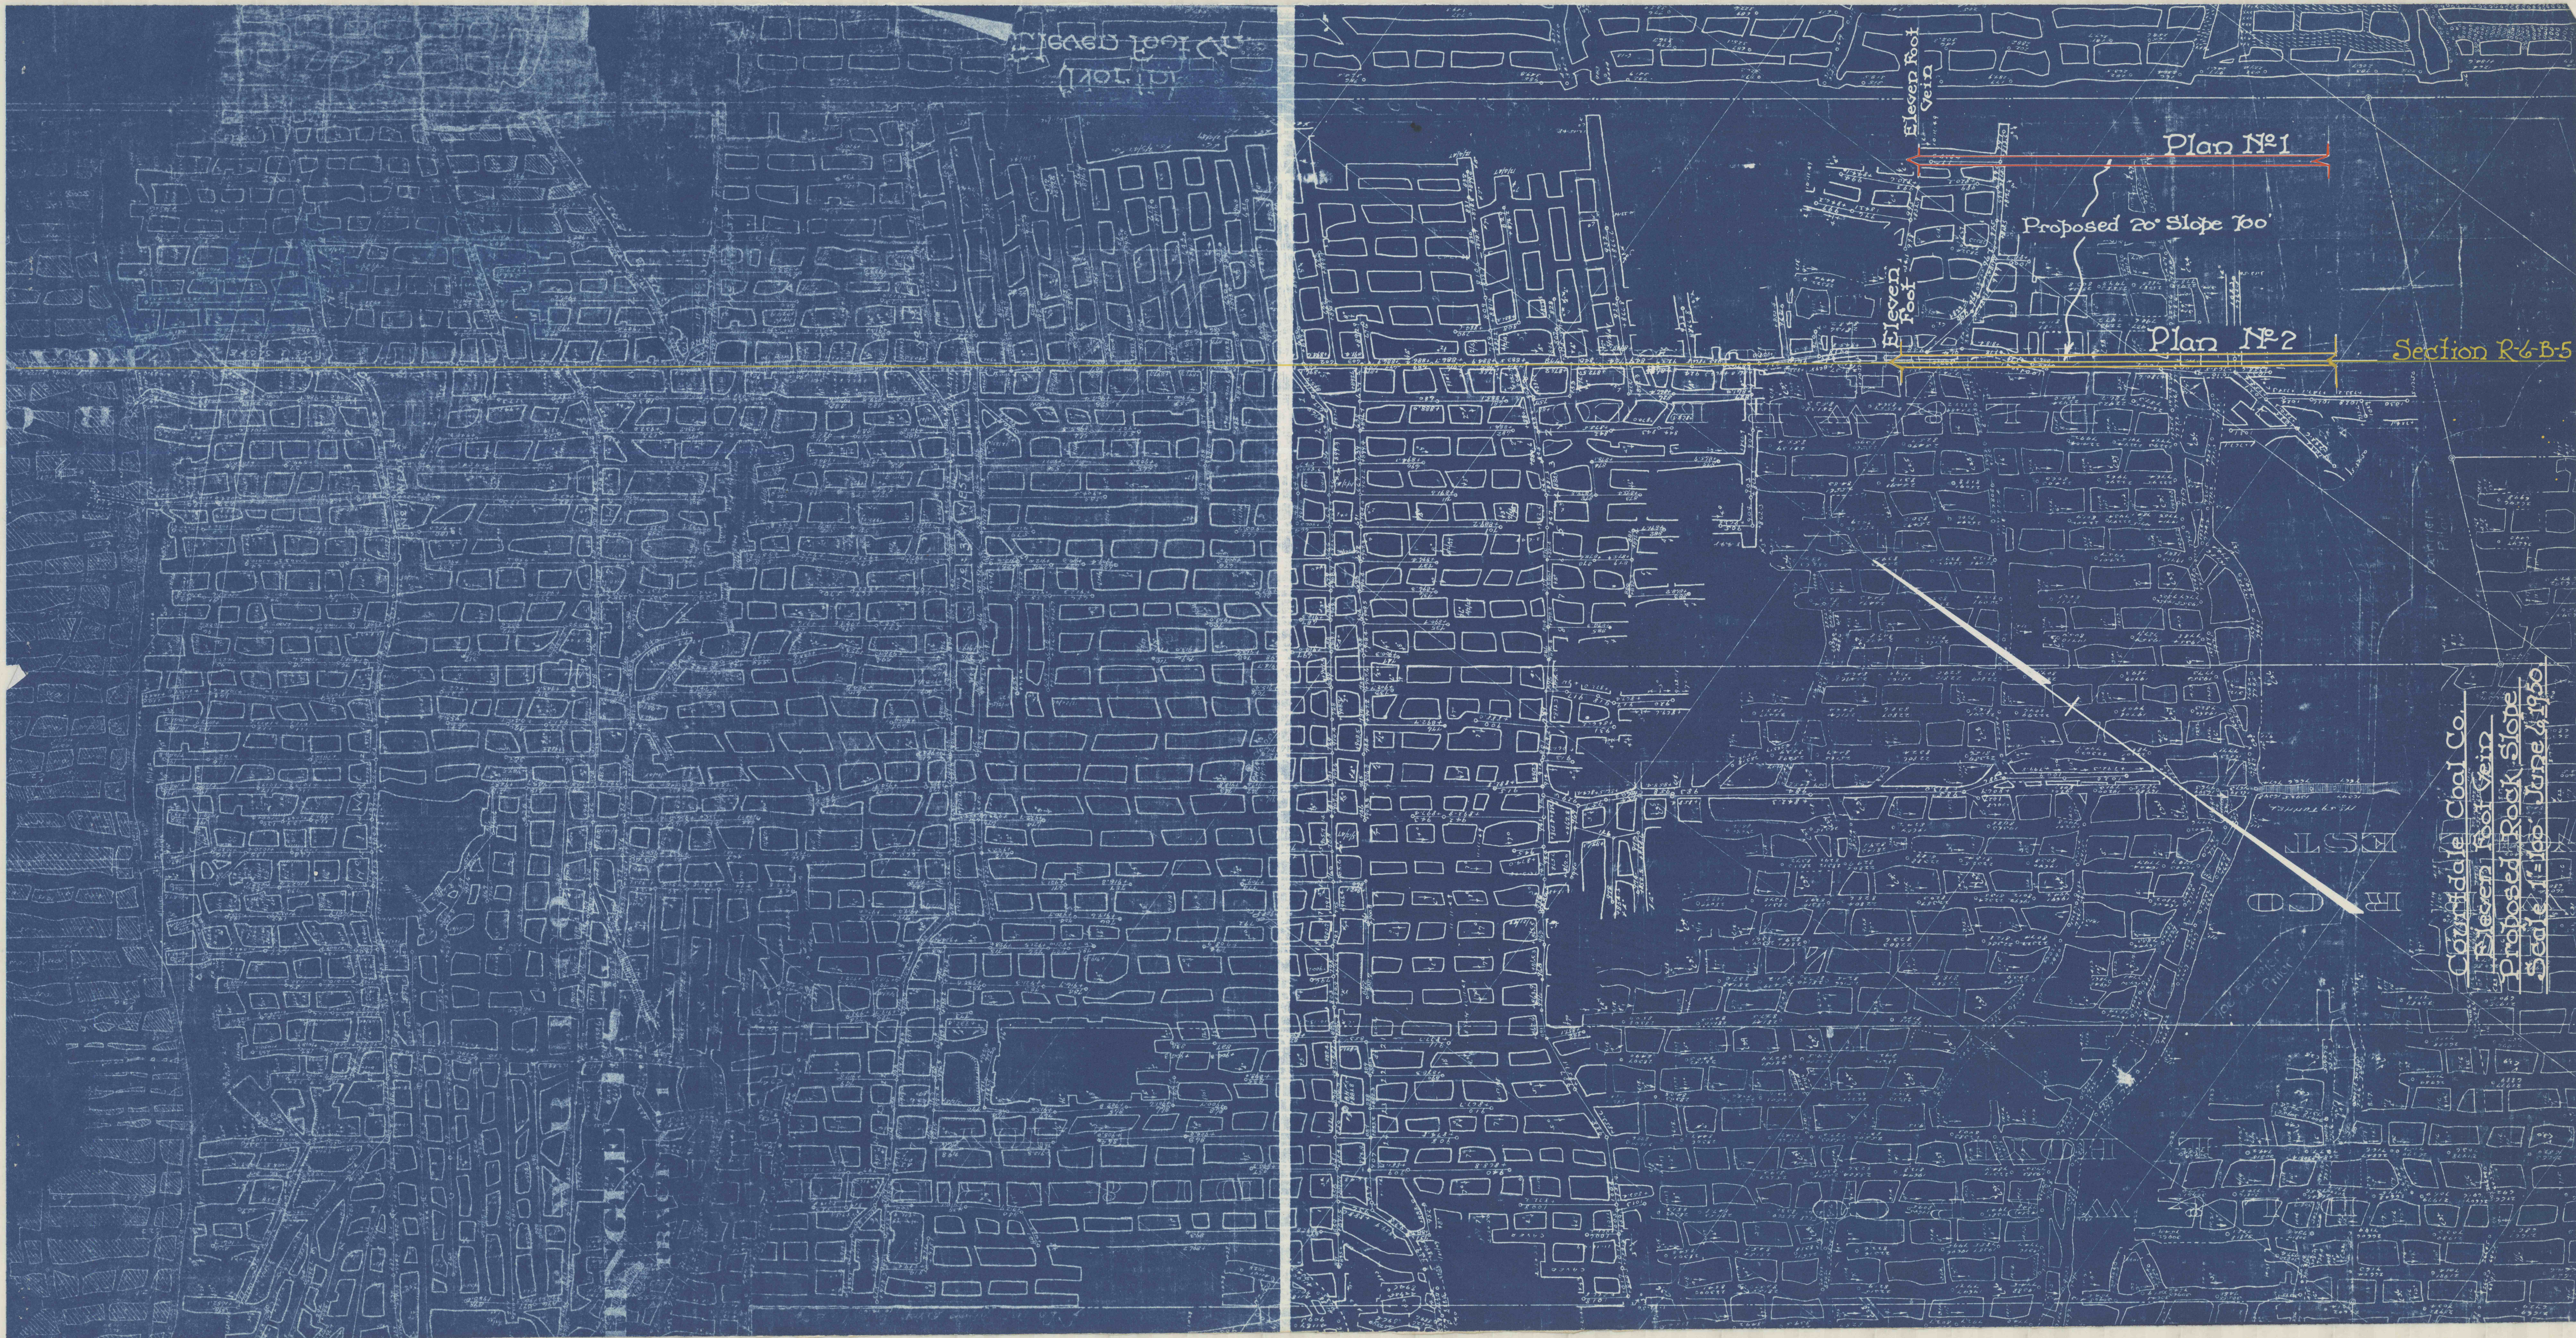

Eleven Foot Vein

Eleven Foot Vein

Eleven Foot Vein

Plan No. 1

Proposed 20' Slope 700'

Plan No. 2

Section R-6-B-5

Proposed Rock Slope
Section R-6-B-5
Scale 1" = 100' June 4, 1950