


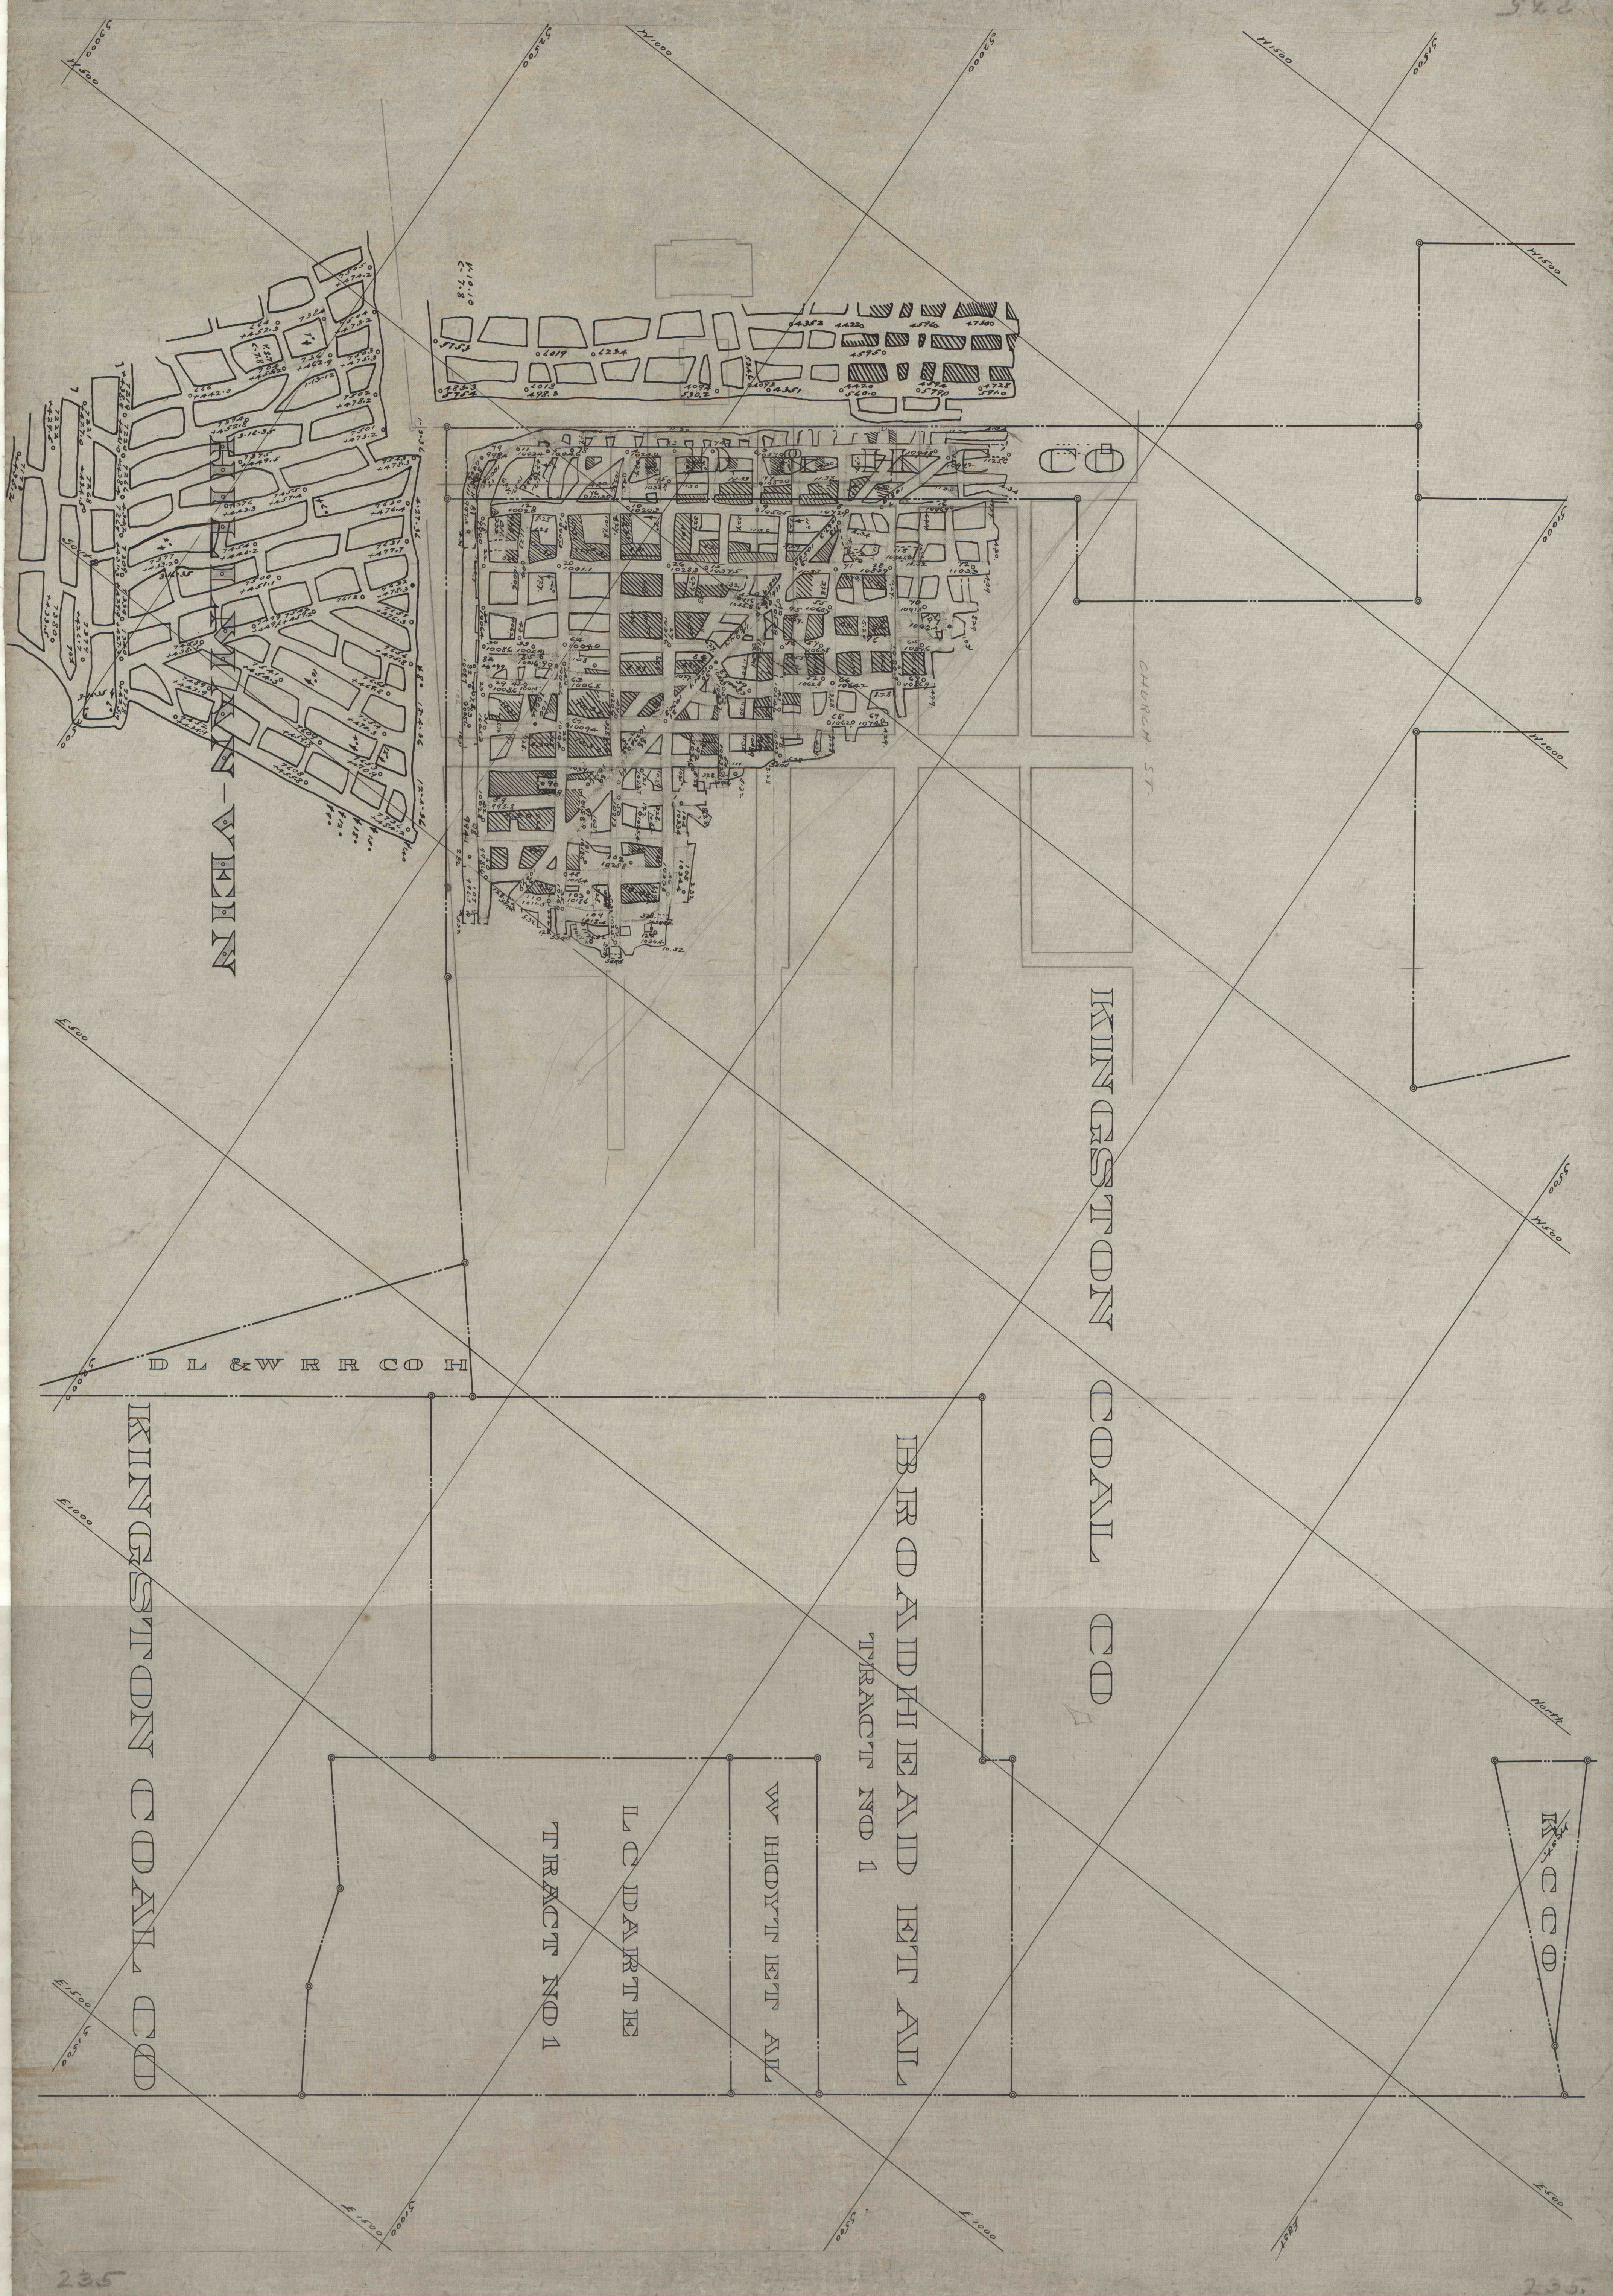

RECEIVED

North

KINGSTON COAL COD


TRACT NO 1



TRACT NO 1

DL & WRR CO H

KINGSTON COAL COD


CHURCH ST.