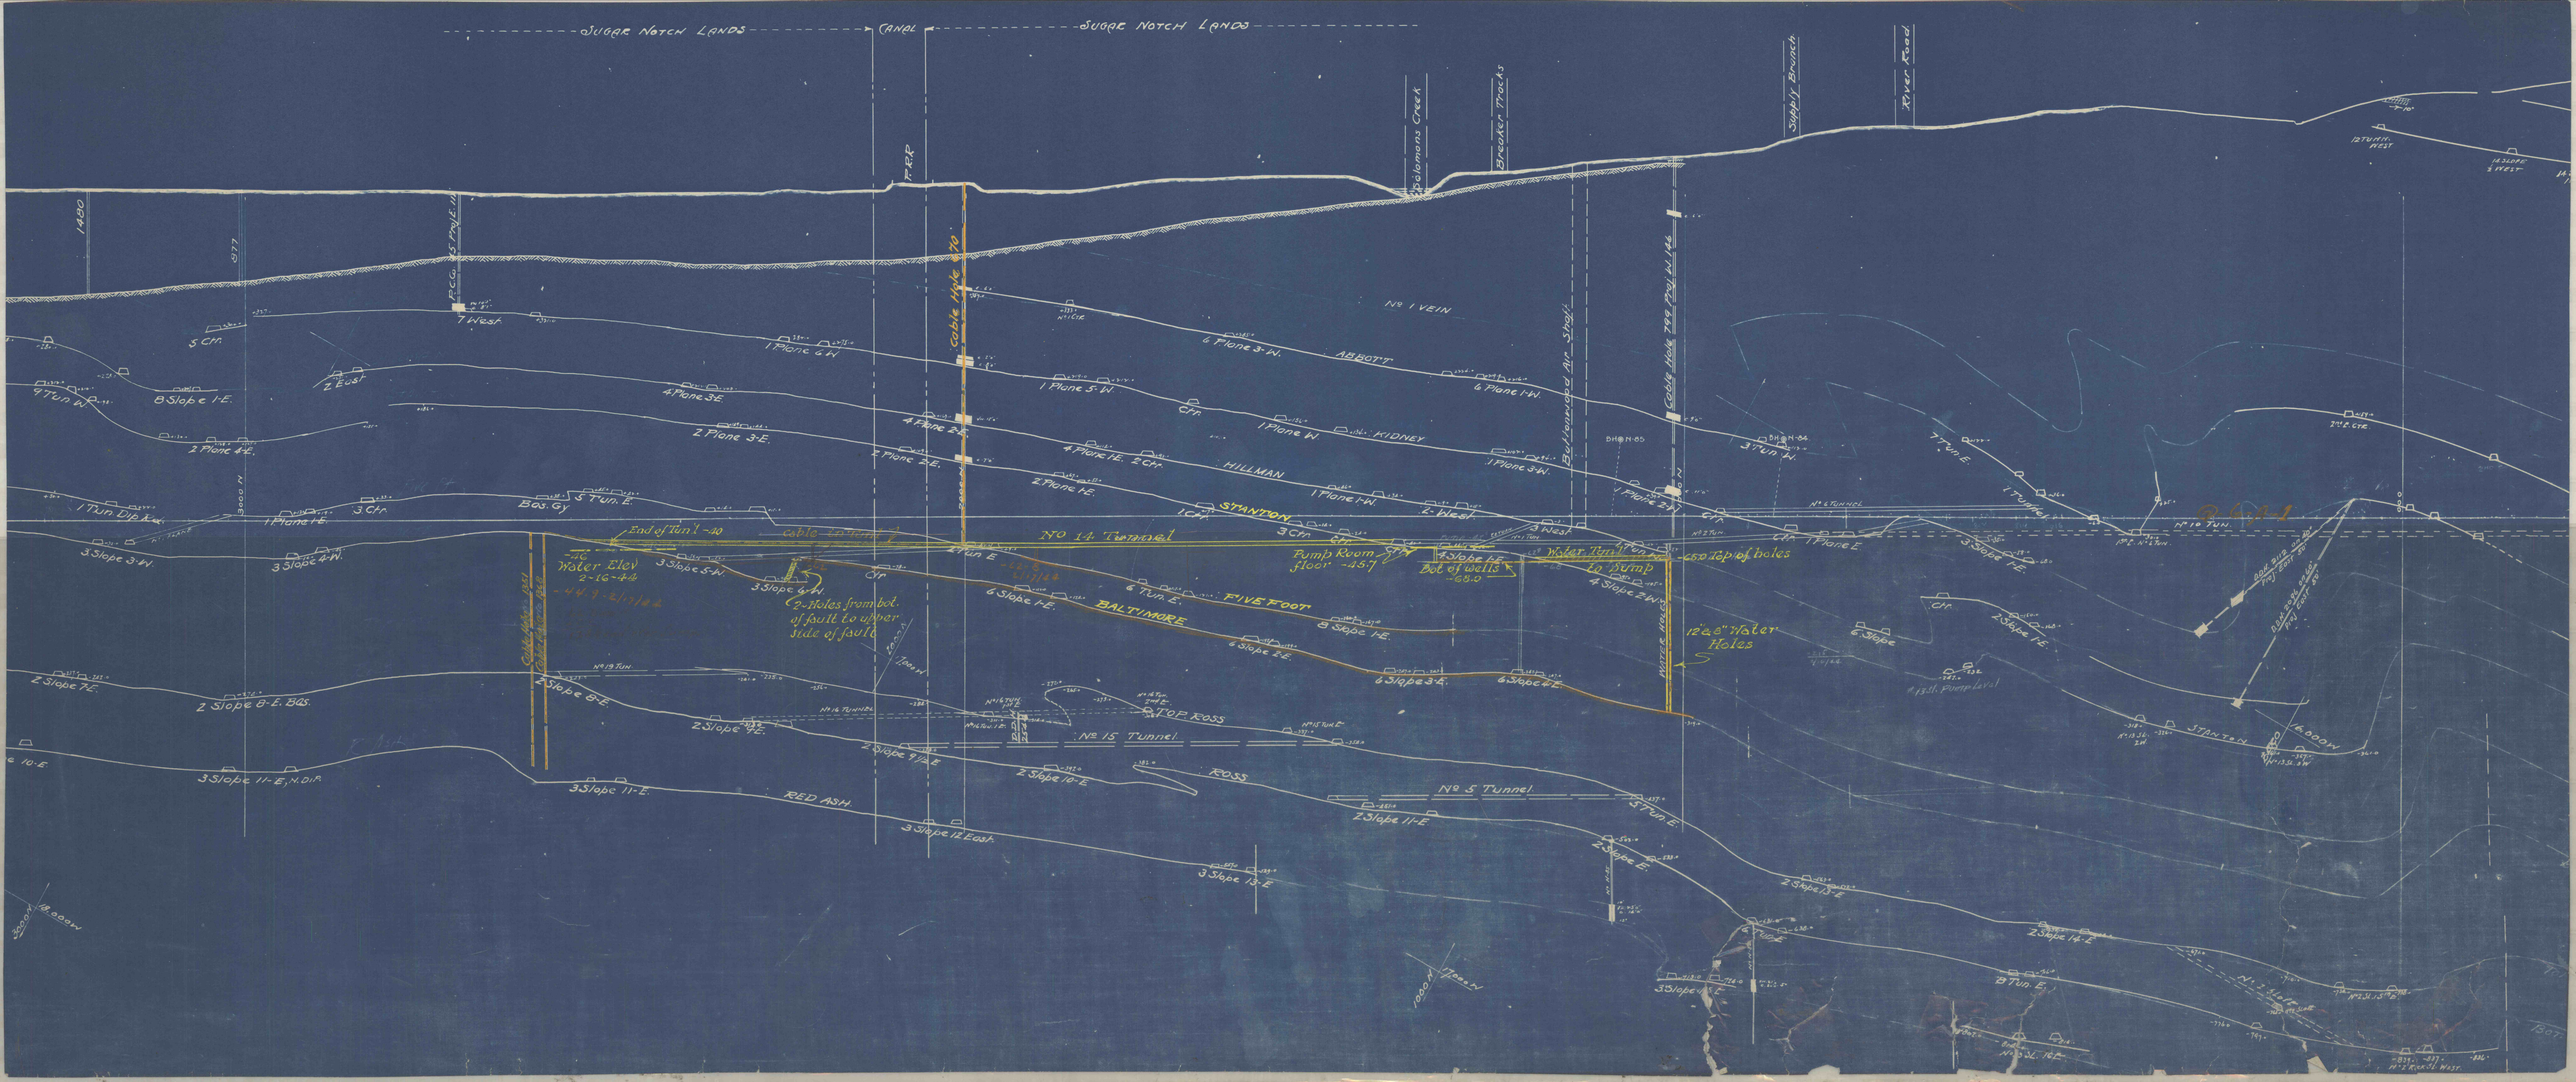
SUGAR NOTCH LANDS
CANAL
SUGAR NOTCH LANDS
P.R.R.
Solomons Creek
Breaker Tracks
River Road
Cable Hole 270
Backwarded Air Shaft
No 1 VEIN
ABBOTT
KIDNEY
HILLMAN
STANTON
No 14 Tunnel
FIVE FOOT
BALTIMORE
TOP ROSS
No 15 Tunnel
ROSS
No 5 Tunnel
RED ASH
Water Elev
2-16-44
Pump Room floor -45.7
Bot of wells -65.0
Water Tunnel
to Pump
Top of holes
12"&8" Water Holes
Cp. Holes from bot. of fault to upper side of fault
Water Holes
Pump Level
STANTON
ROOM
No 10 TUN
No 19 TUN
No 14 TUNNEL
No 15 TUN
1480
877
3800 N
3200 N
3000 N
1000 N
7000 N
3200 N 18.000 W
1500 N