


$\begin{array}{r} S2500 \\ 13000W \end{array}$

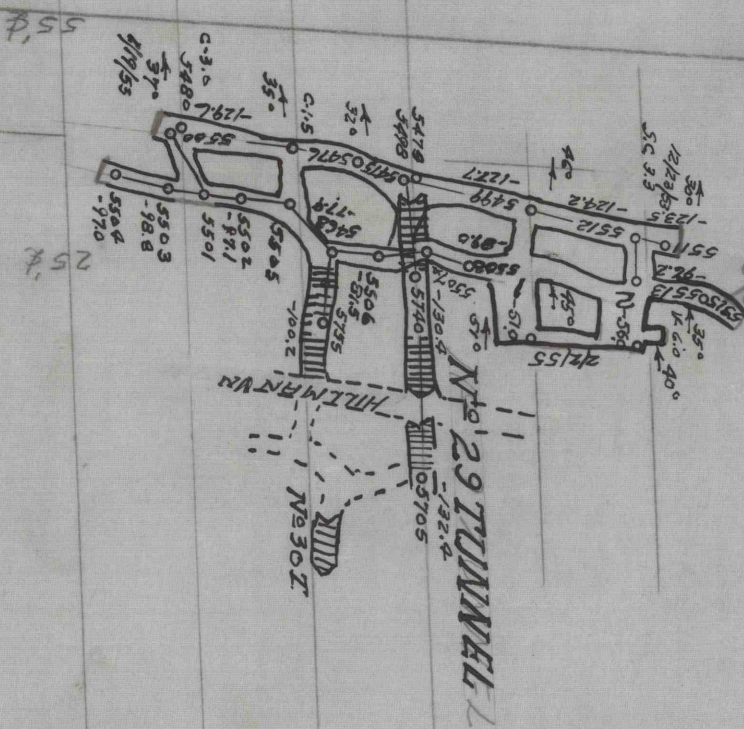

1/00