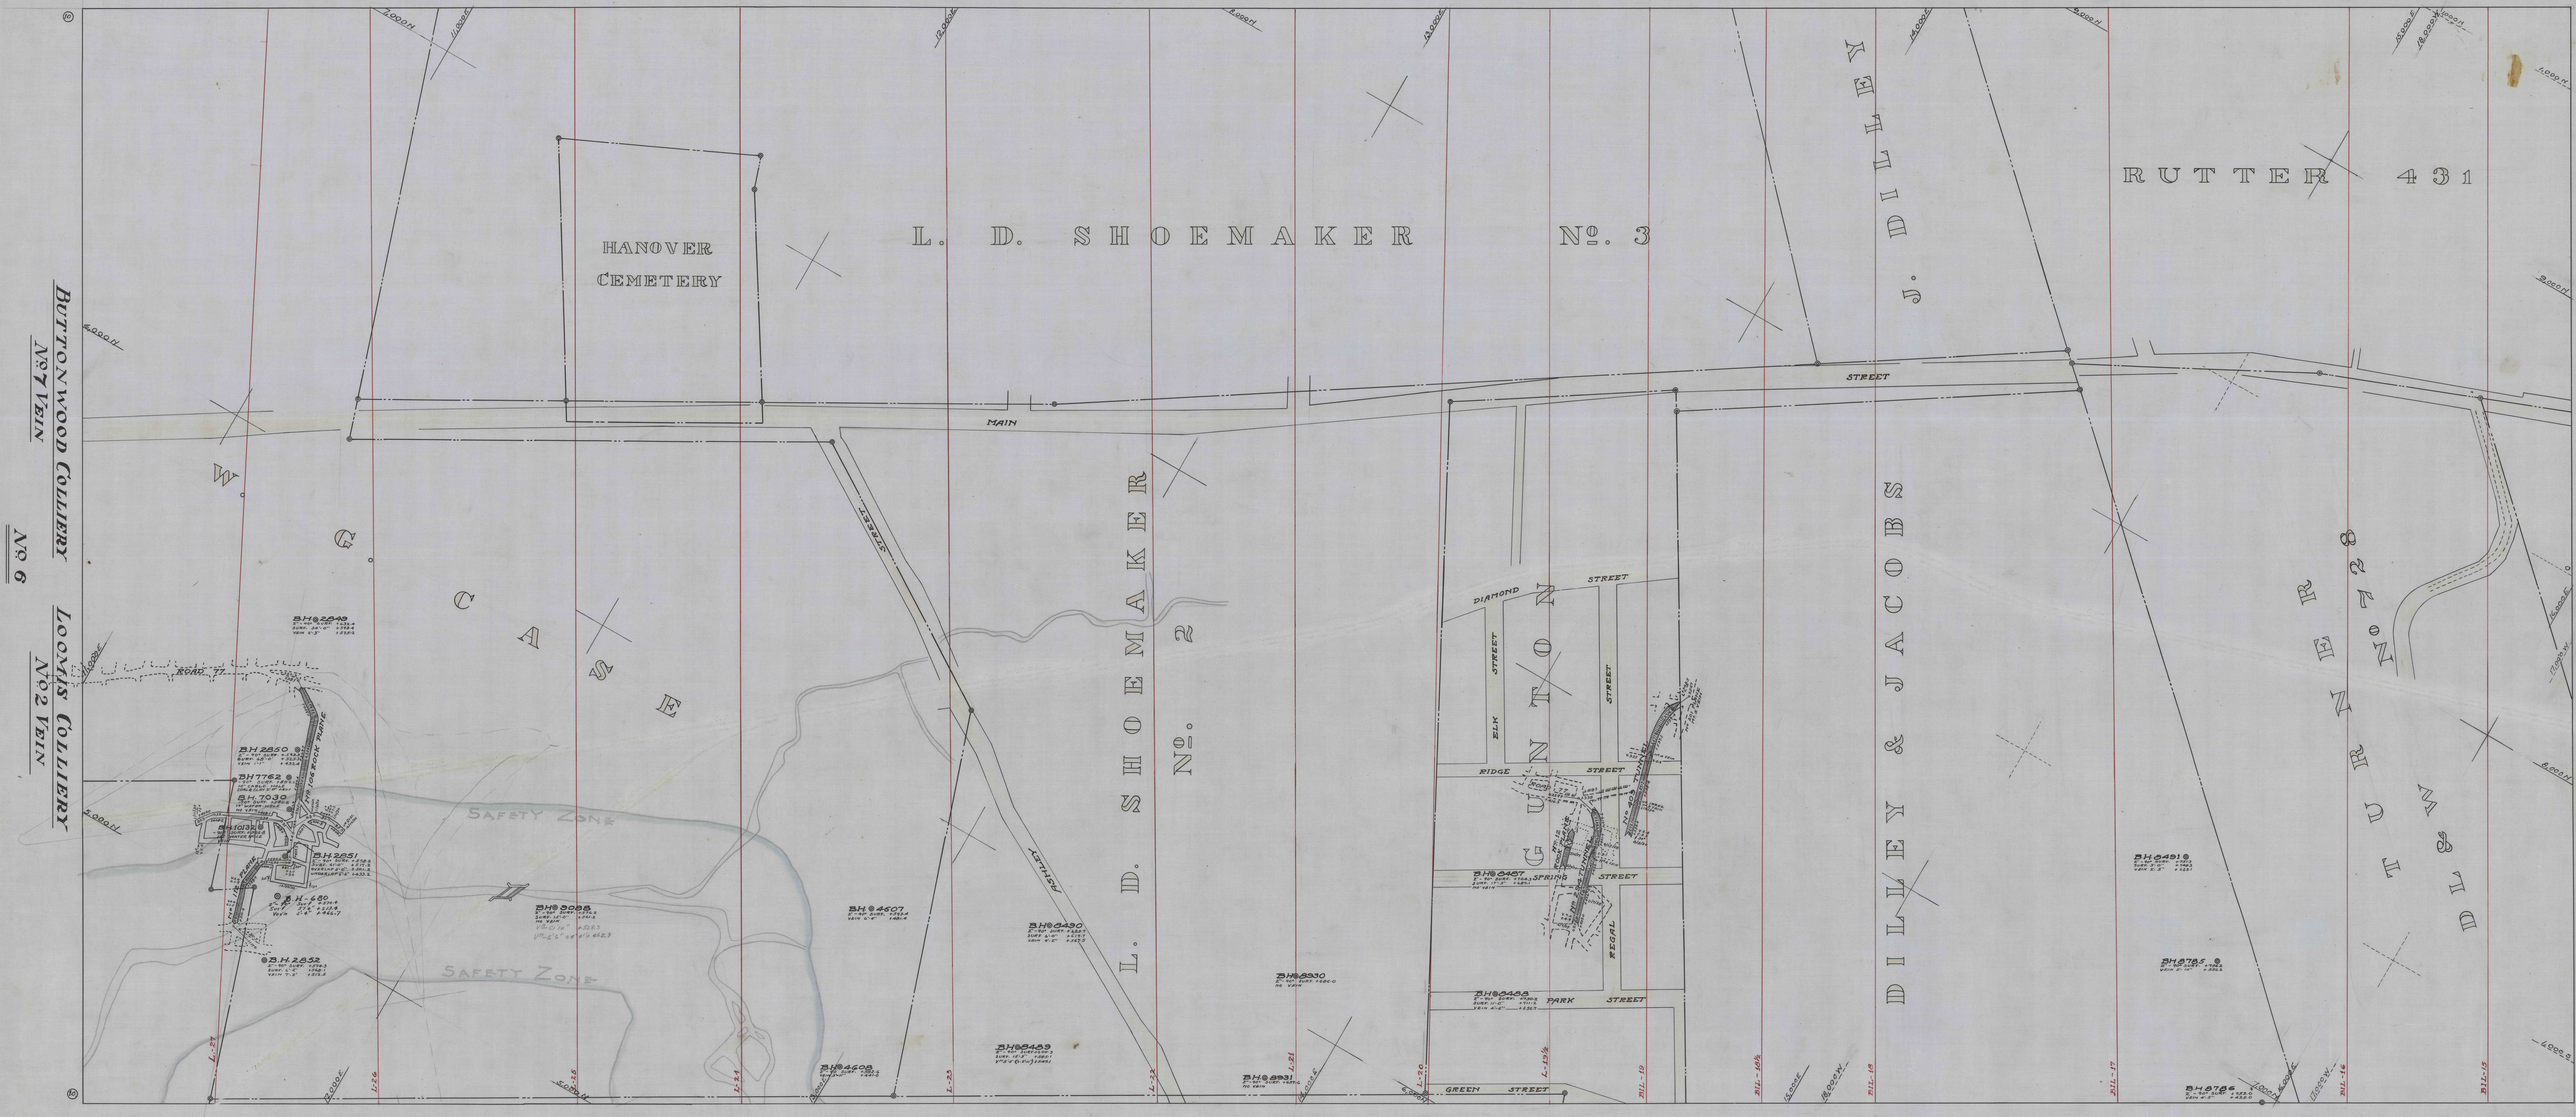
BUTTONWOOD COLLIERY
No 7 VEIN
No 6
LOOMIS COLLIERY
No 2 VEIN
HANOVER CEMETERY
L. D. SHOEMAKER No. 3
L. D. SHOEMAKER No. 2
J. DILLEY
DILLEY & JACOBS
RUTTER 431
MAIN STREET
ROAD 17
SAFETY ZONE
SAFETY ZONE
DIAMOND STREET
ELK STREET
RIDGE STREET
SPRING STREET
PARK STREET
GREEN STREET
REGAL
GUNTON
BH 2848
BH 7762
BH 7030
BH 2851
BH 2852
BH 660
BH 9006
BH 4607
BH 8430
BH 8930
BH 8469
BH 4608
BH 8931
BH 4457
BH 8468
BH 4918
BH 8785
BH 8786