


No 13

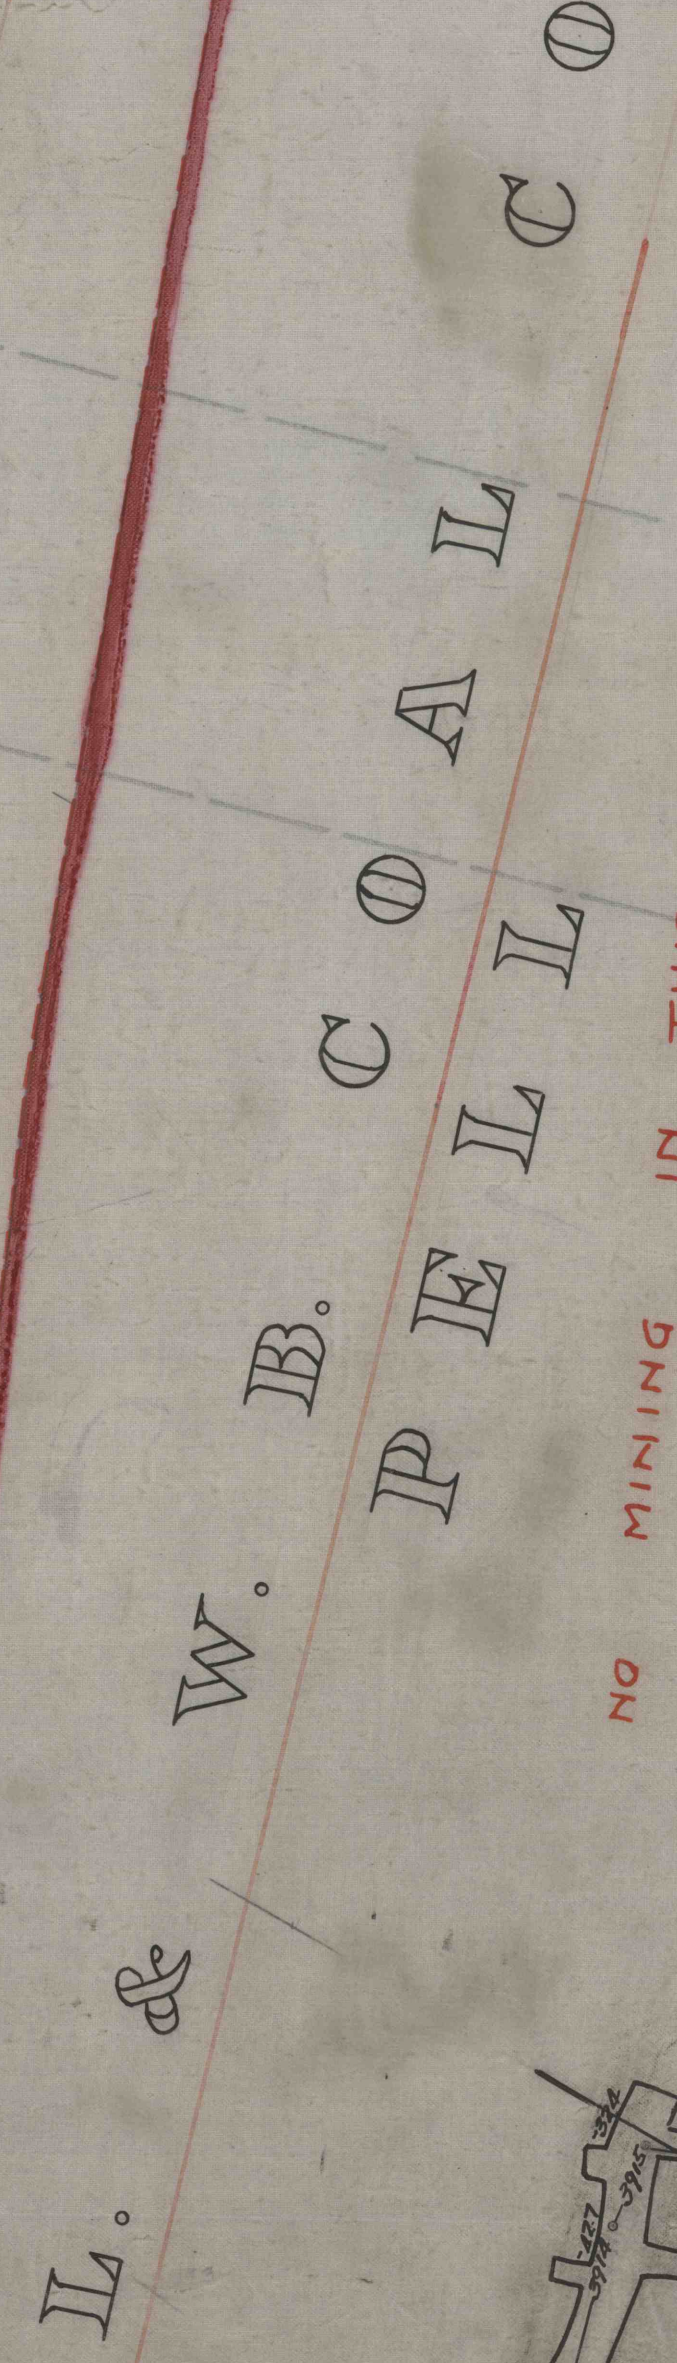

No 13