



LOOMIS N°3 SHAFT — DUNDEE SHAFT

HANOVER TOWNSHIP
LUZERNE CO. PENNA.
Engs' Office C.M.D. Scale 1" = 20'

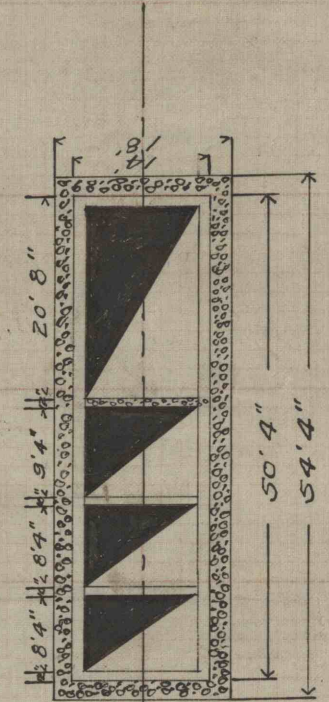

Datum Line +620.00

Section of Loomis N°3 Shaft:
Looking East lin. = 20 ft. Top of concrete +569.0

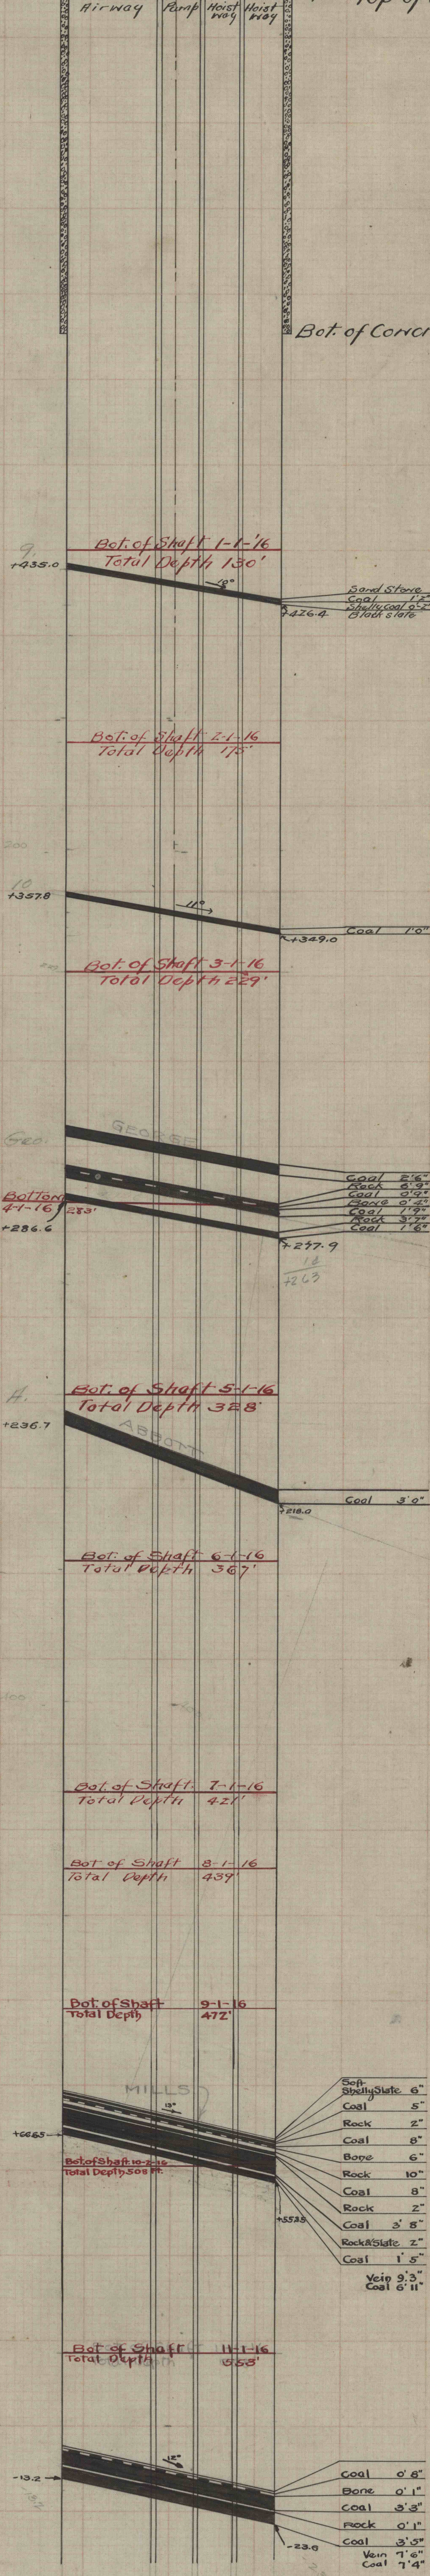

Section of Dundee Shaft:
Looking East lin. = 20 ft. Top of concrete +609.0

