



DUNDEE SHAFT  
HANOVER TOWNSHIP  
LUZERNE CO. PENNA.  
ENGRS. OFFICE C.M.D.  
SCALE 1"=20'

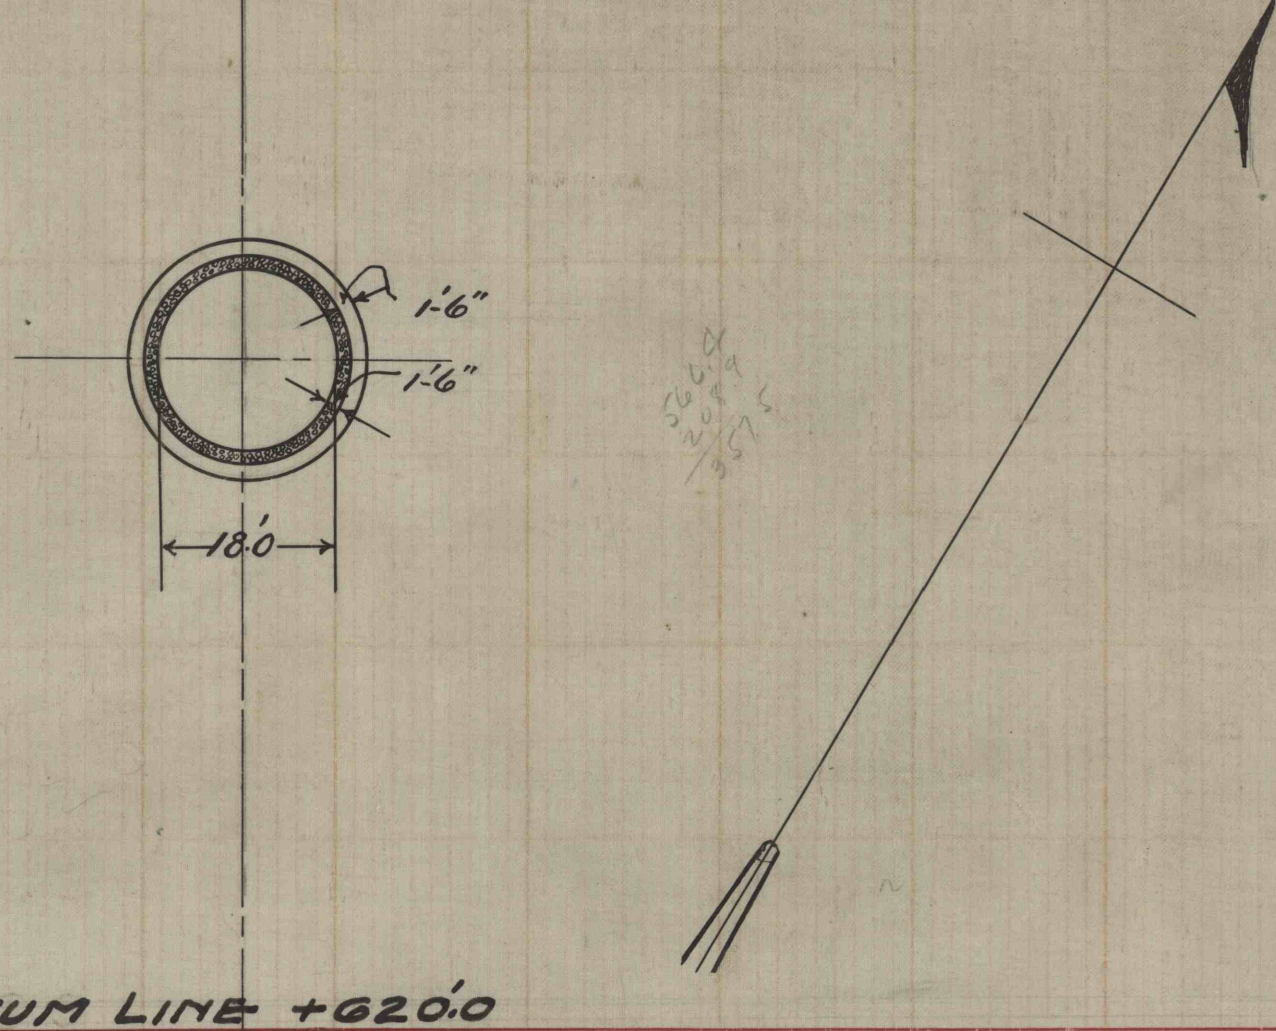

SECTION OF CIRCULAR AIR-SHAFT NEAR  
DEWEY PARK  
SCALE 1"=20.0

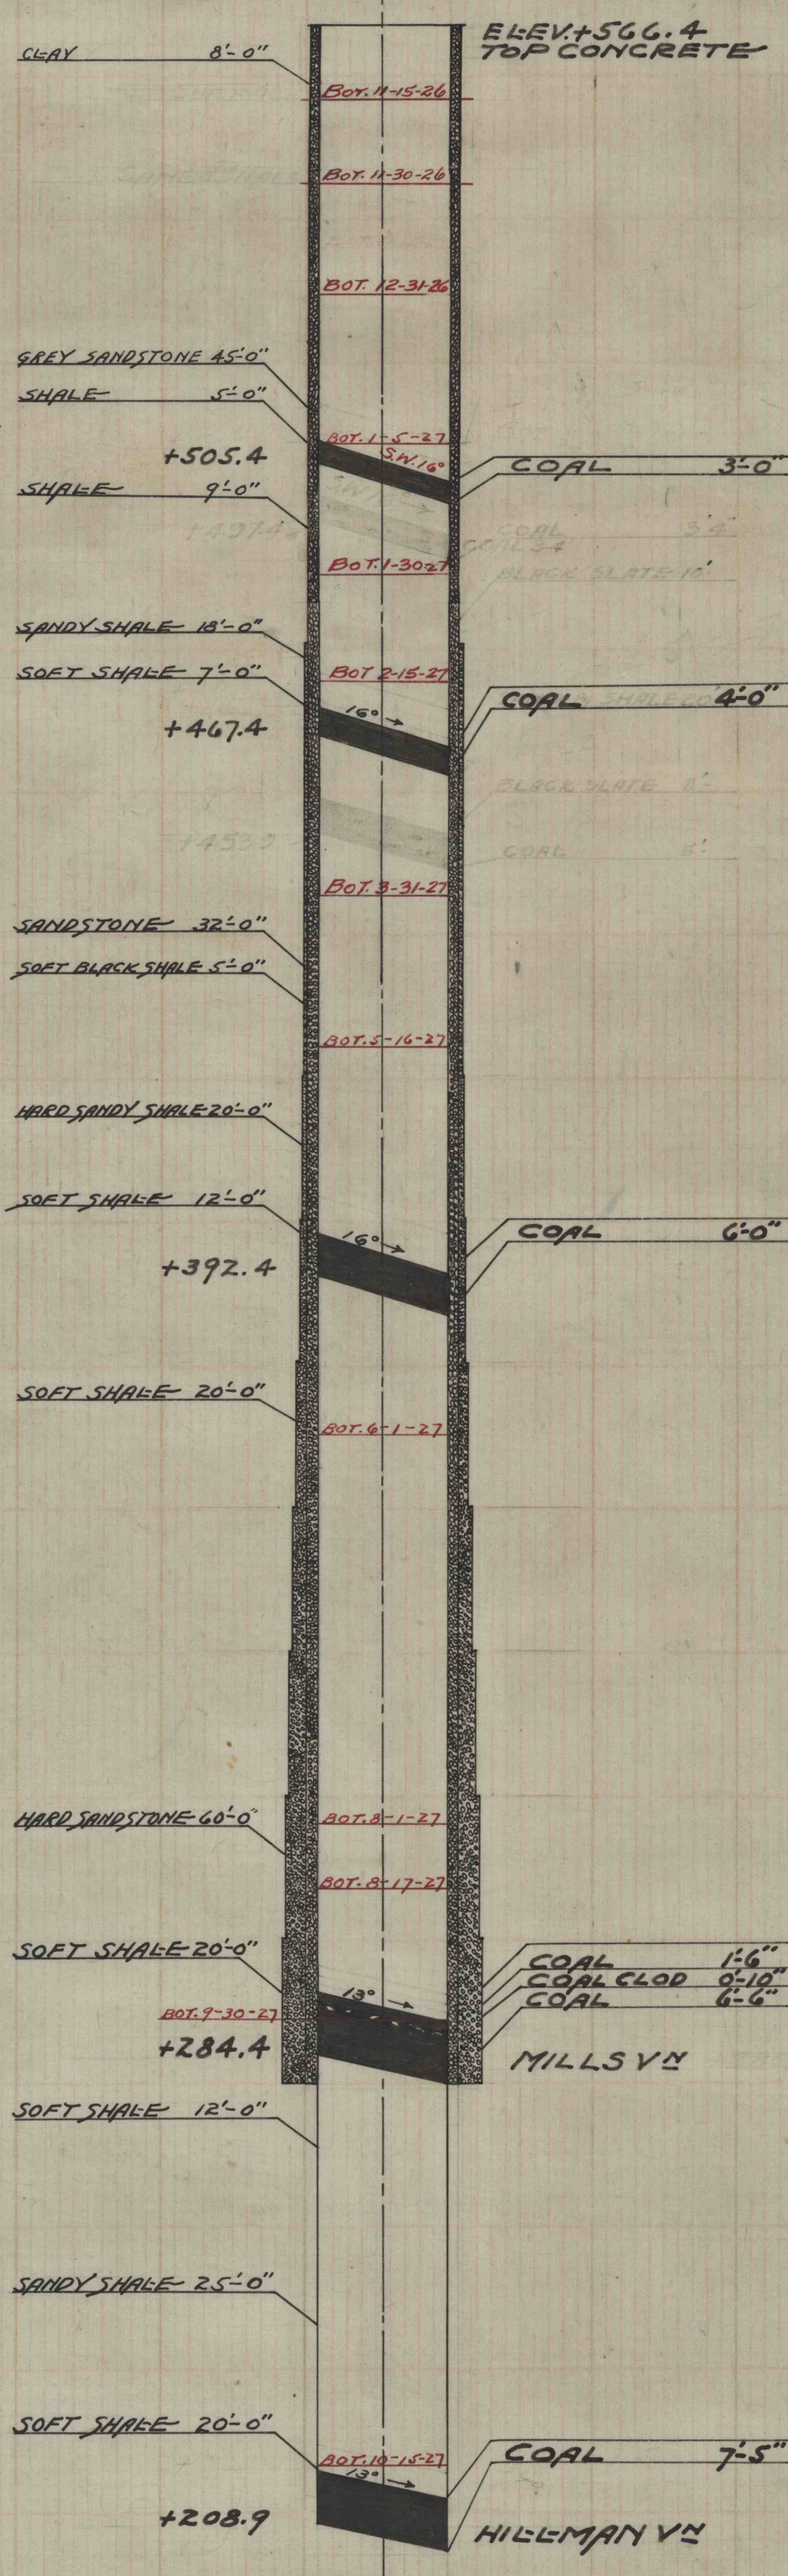

SECTION OF DUNDEE SHAFT LOOKING EAST.  
SCALE 1"=20'

