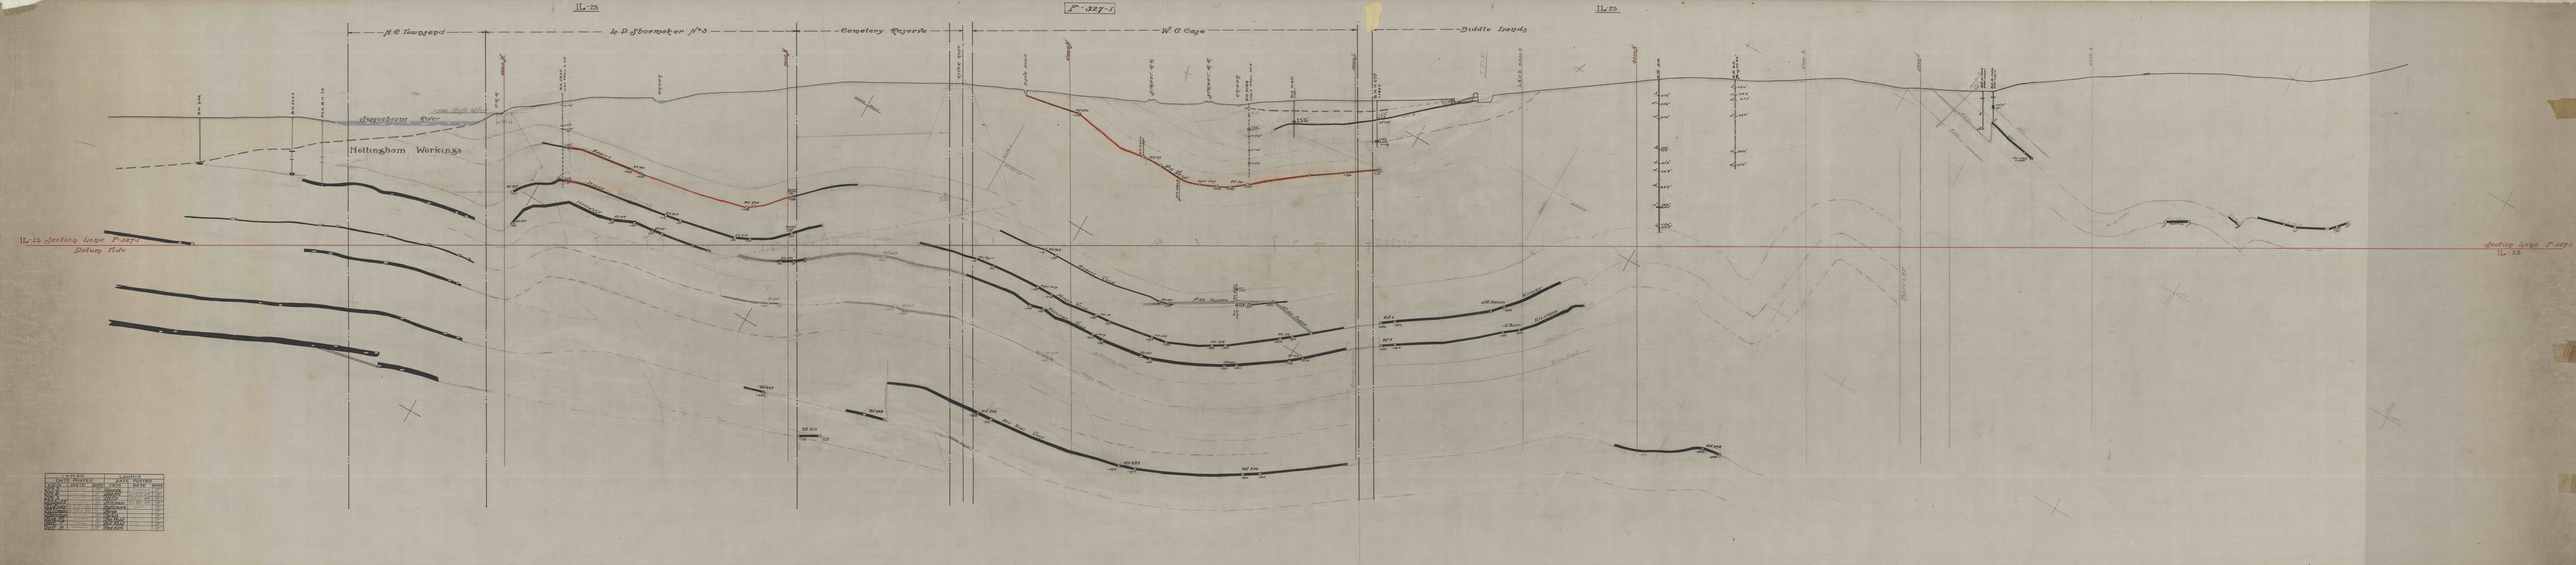

IL-25
F-327-1
IL-25
H. C. Townsend
L. D. Shoemaker No 3
Cemetery Reserve
W. C. Case
Biddle Lands
8000 N
7000 N
6000 N
5000 N
4000 N
B.H. 946
B.H. 2553
P.C.C. B.H. 73
P.R.R.
+536 High Water
Susquehanna River
60'
Nottingham Workings
B.H. 2842 +616.2 Proj E 215'
Creek
12000 East
River Road
Cave Hole
Street R.R.
Street R.R.
Creek
B.H. 9088 +576.2 Proj 45°E
B.H. N-671
B.H. N-672
STOP
L&WB 4000 S
B.H. 5A
B.H. 6A Proj W 45'
Abbott
Mills
Hillman
Robbed
RD 769
RD 487
RD 790
RD 734
RD 704
RD 417
RD 461
RD 713
Shaker Chute Ctr
RD 471
No 1 East
RD 763
RD 420
B.H. 9066
RD 77
No 5 Vein
East Gwy
RD 701
B.H. 9804
Pinch out
Abbott Vein
Mills Vein
Hillman Vein
East Gwy
RD 14
RD 431
No 82 Tunnel
B.H. 5756
No 45 Plane
RD 236
RD 476
RD 119
RD 425
RD 250
RD 124
Baltimore Vein
Forge Vein
Barrier Pillar
Rd 6
Rd 7
3 Pl. Basin
1 Sl Basin
Kidney
Hillman
Stanton
Five Foot
Rd 923
Rd 783
Bot Ross Vein
RD 893
Rd 850
Rd 876
IL-25 Section Line F-327-1
Datum Tide
Section Line F-327-1
IL-25

INMAN			LOOMIS		
DATE POSTED			DATE POSTED		
VEIN	DATE	NAME	VEIN	DATE	NAME
No 5	—	R	George	—	R
No 4	—	R	Abbott	6-22-49	R
No 3	—	R	Mills	7-6-49	R
Abbott	—	R	Hillman	7-29-49	R
Kidney	9-28-50	R	Baltimore	—	R
Hillman	9-28-50	R	Forge		R
Stanton	—	R	Twin		R
Five Ft.	—	R	Top Ross		R
Balt. T.	—	R	Bot. Ross		R
Balt. B.	—	R	Red Ash		R