


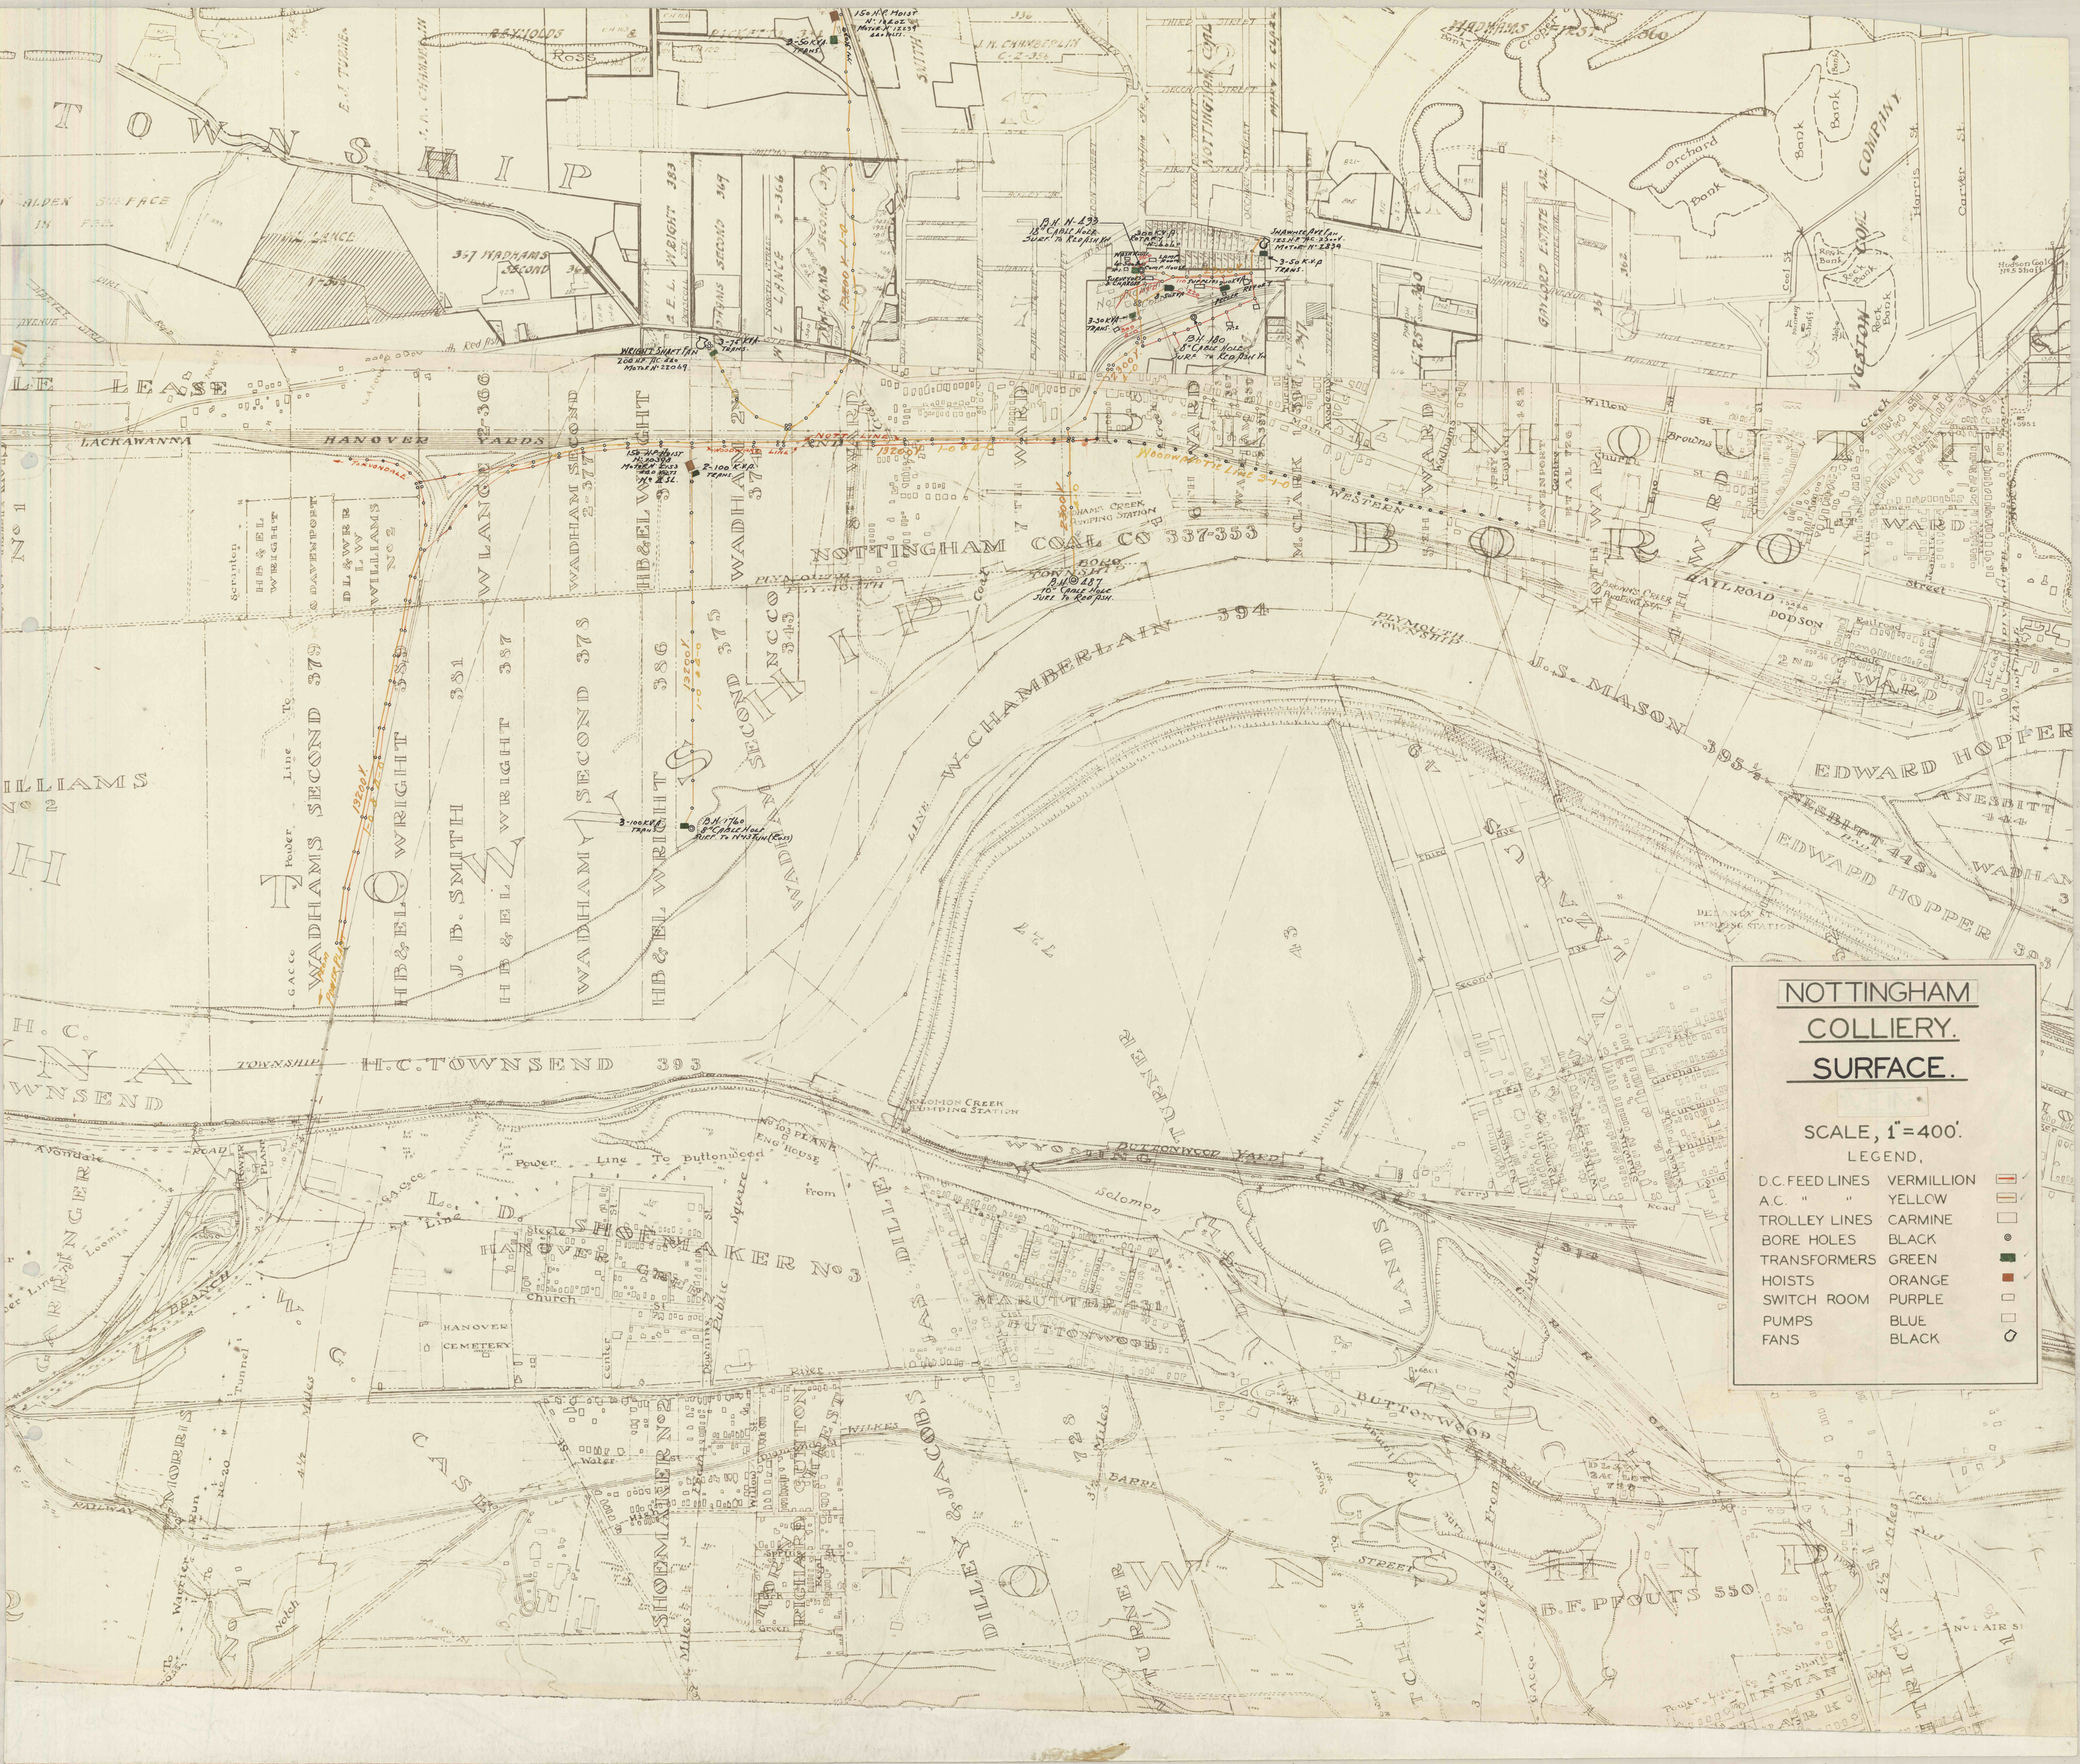

NOTTINGHAM
COLLIERY.
SURFACE.

SCALE, 1"=400'.

LEGEND.

D.C. FEED LINES	VERMILLION	
A.C. "	YELLOW	
TROLLEY LINES	CARMINE	
BORE HOLES	BLACK	
TRANSFORMERS	GREEN	
HOISTS	ORANGE	
SWITCH ROOM	PURPLE	
PUMPS	BLUE	
FANS	BLACK	