


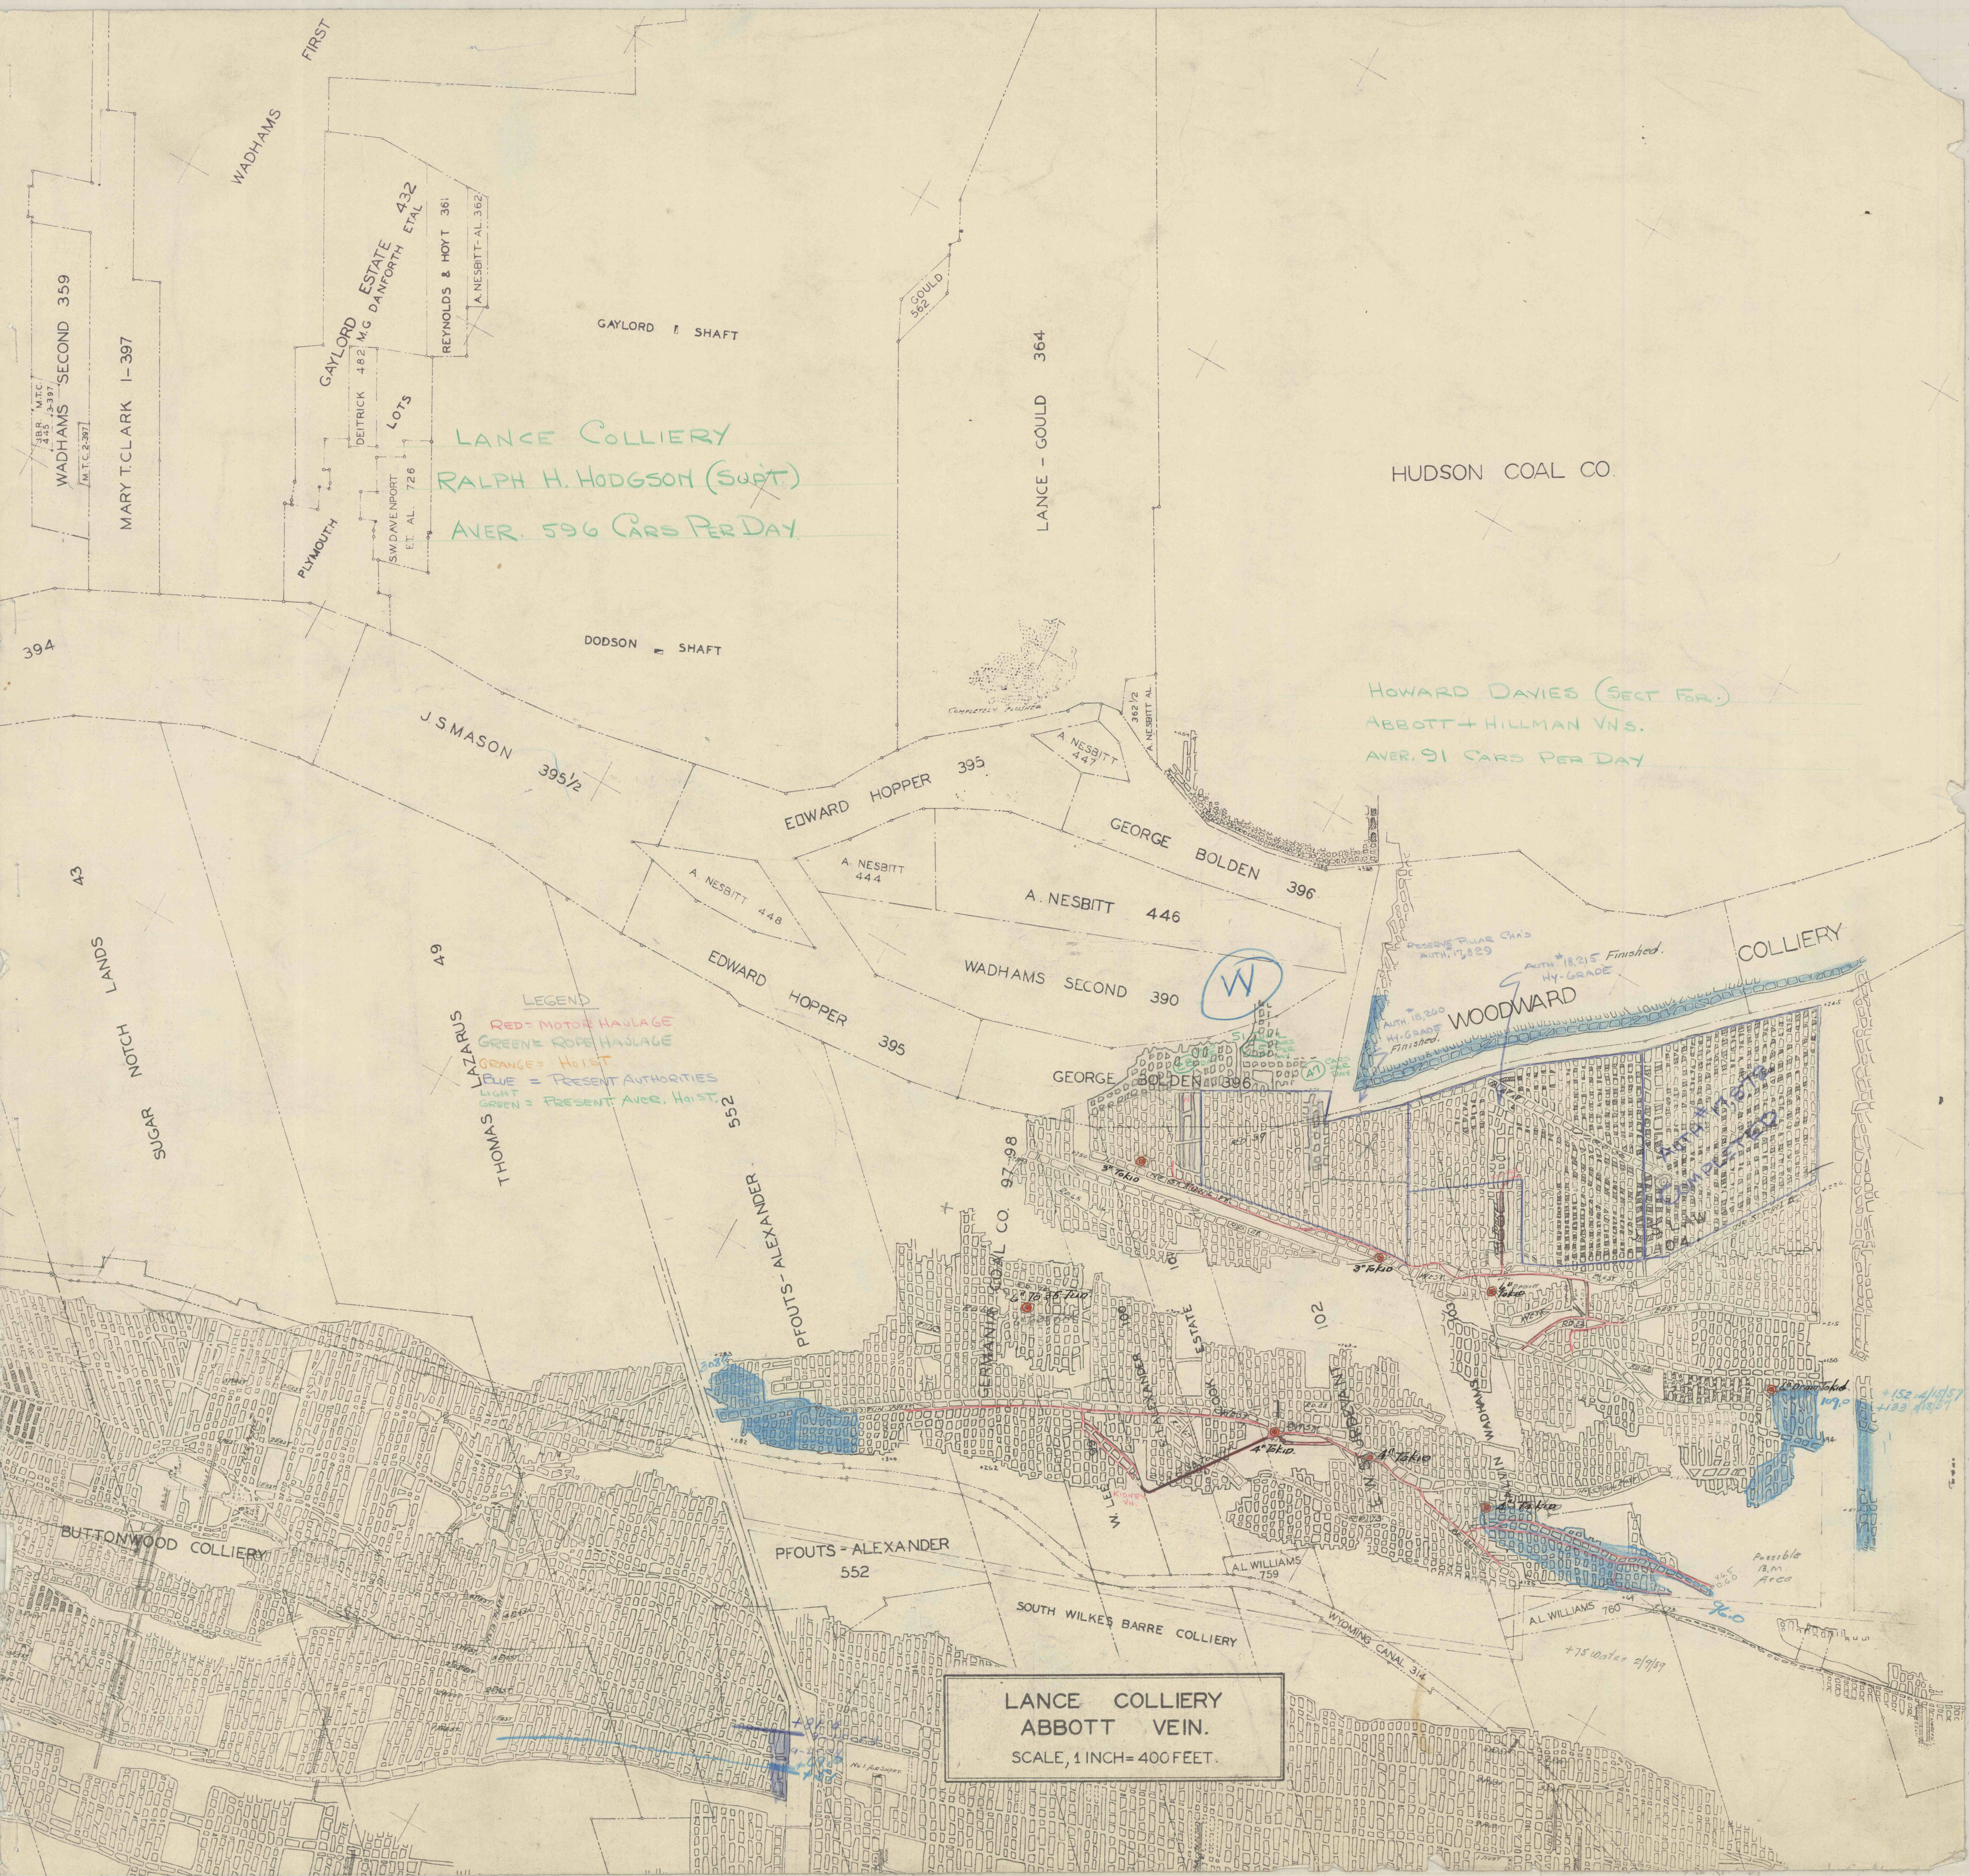

LANCE COLLIERY
RALPH H. HODGSON (SUPT.)
AVER. 596 CARS PER DAY

HUDSON COAL CO.

HOWARD DAVIES (SECT FOR)
ABBOTT + HILLMAN VNS.
AVER. 91 CARS PER DAY

LEGEND
RED = MOTOR HAULAGE
GREEN = ROPE HAULAGE
ORANGE = HOIST
BLUE = PRESENT AUTHORITIES
LIGHT GREEN = PRESENT AVER. HOIST

LANCE COLLIERY
ABBOTT VEIN.
SCALE, 1 INCH = 400 FEET.