


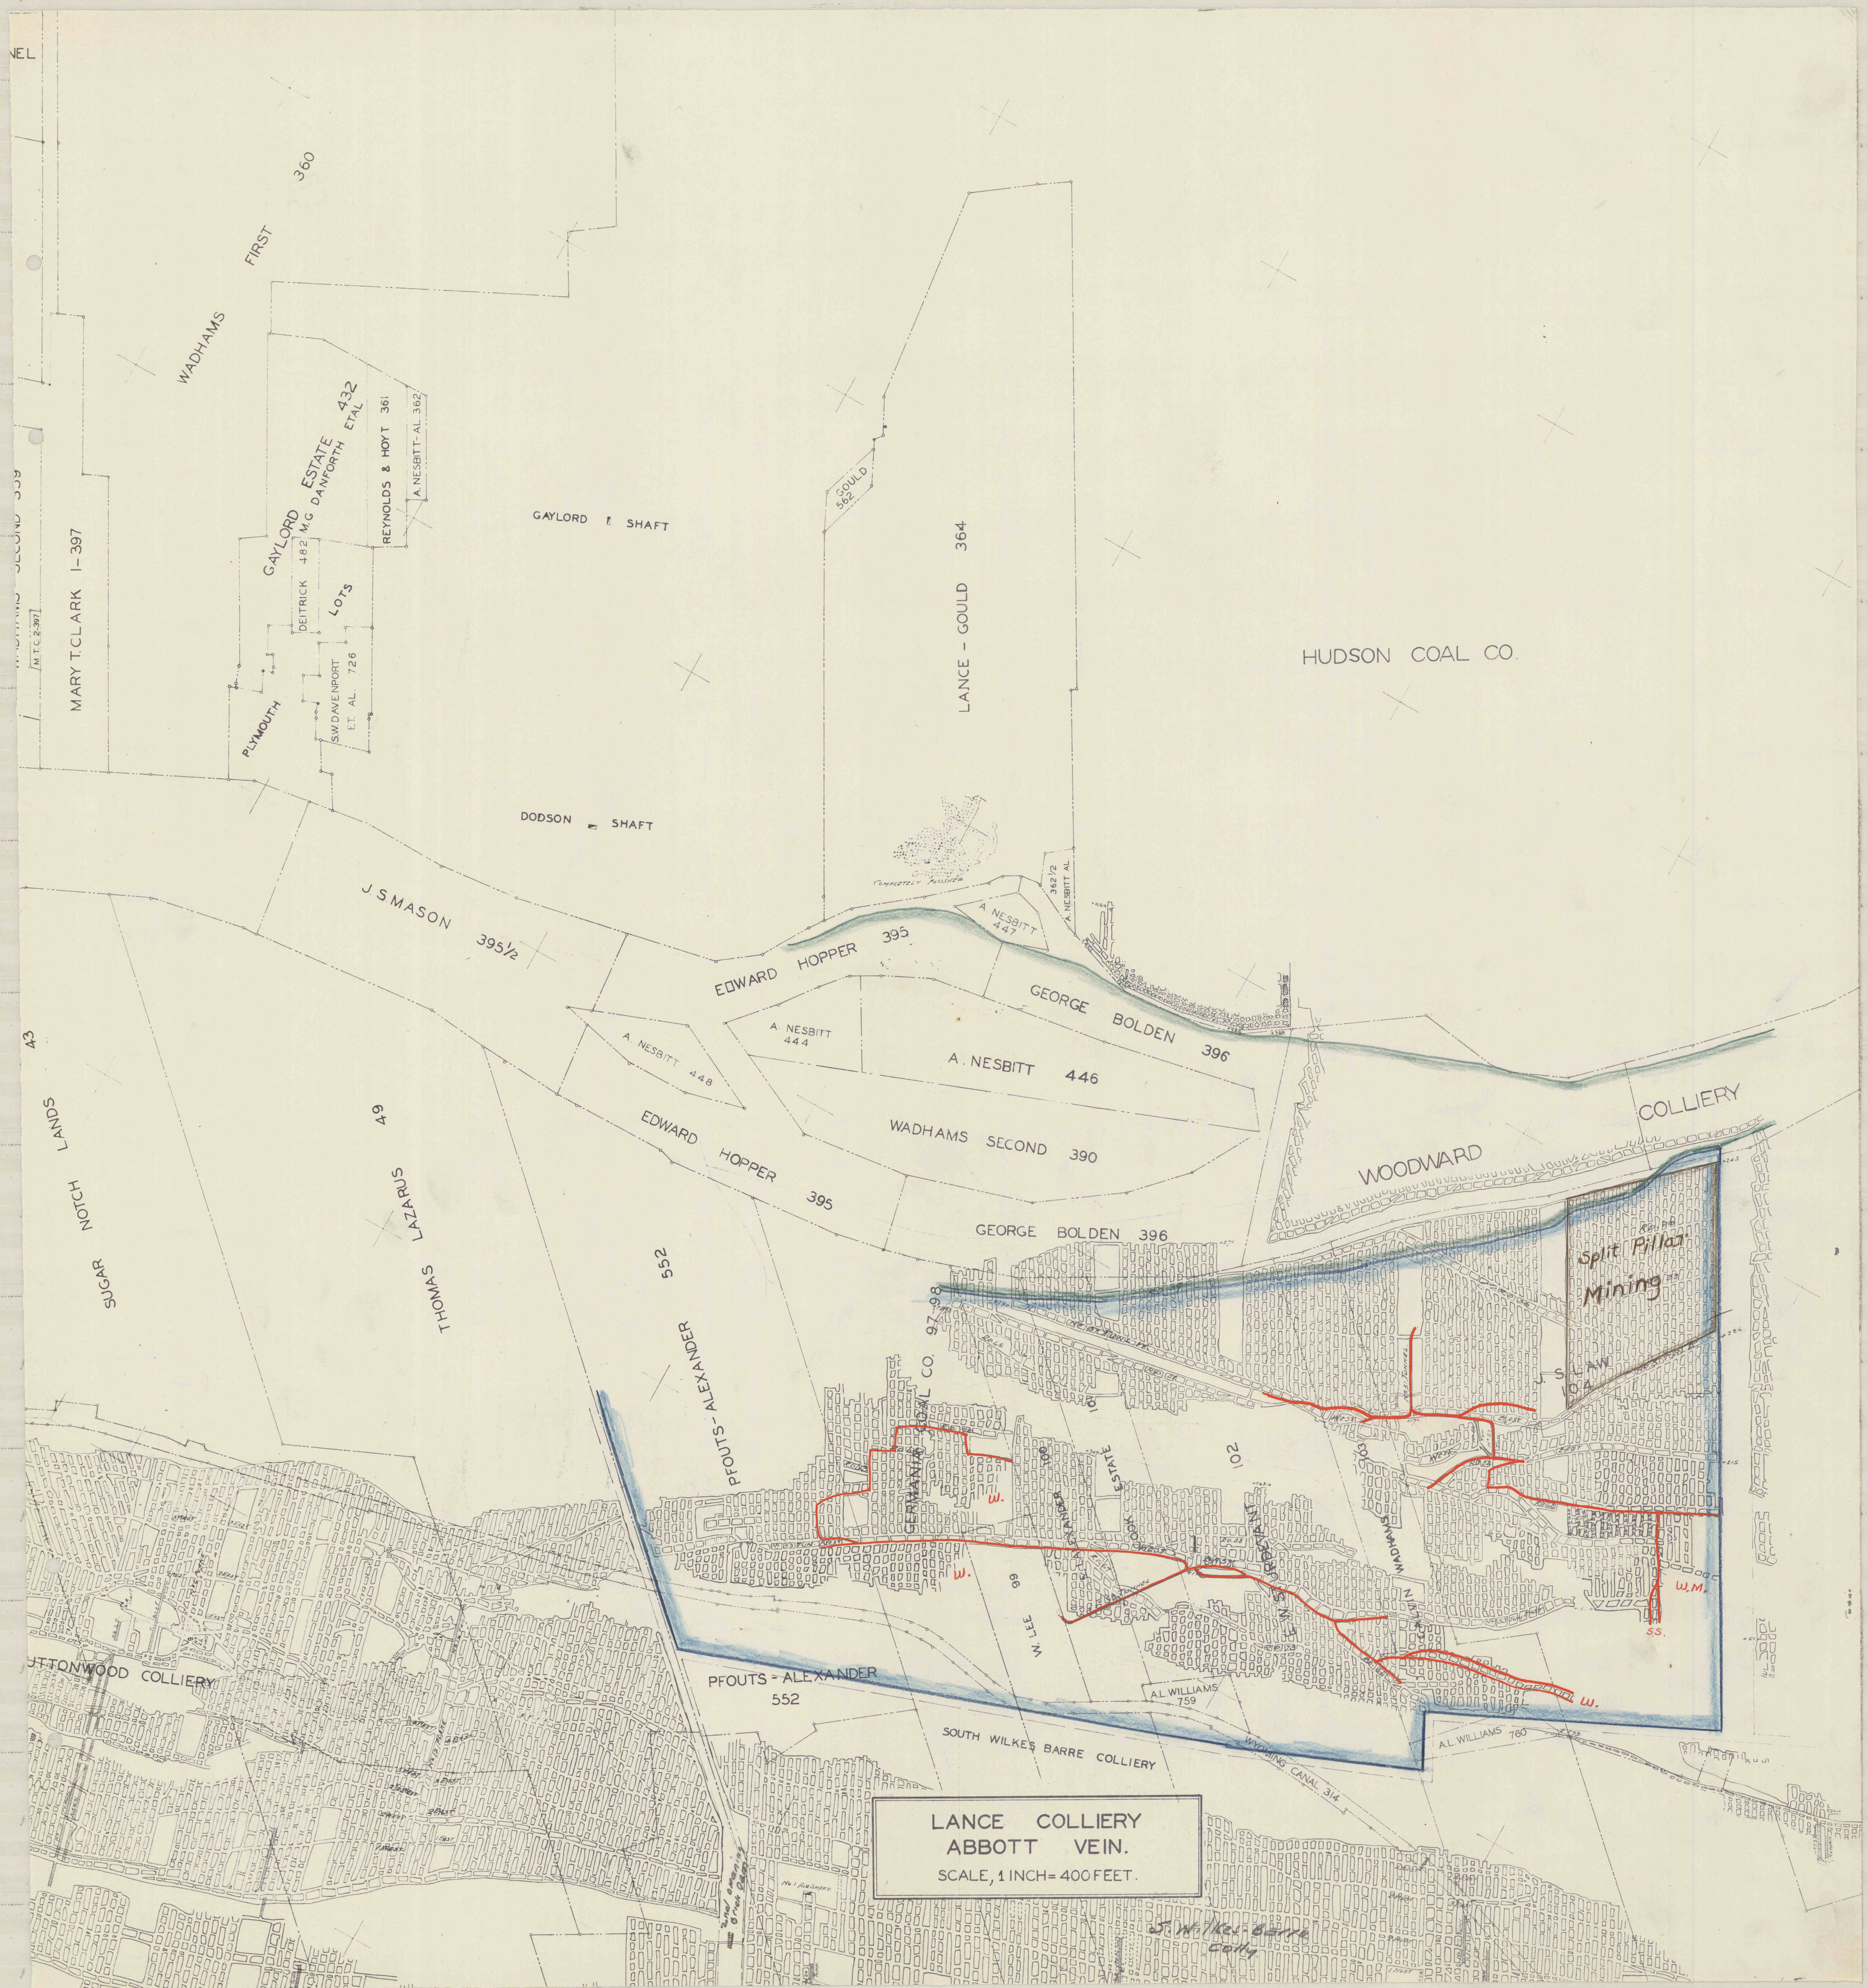

LANCE COLLIERY
ABBOTT VEIN.
SCALE, 1 INCH = 400 FEET.