


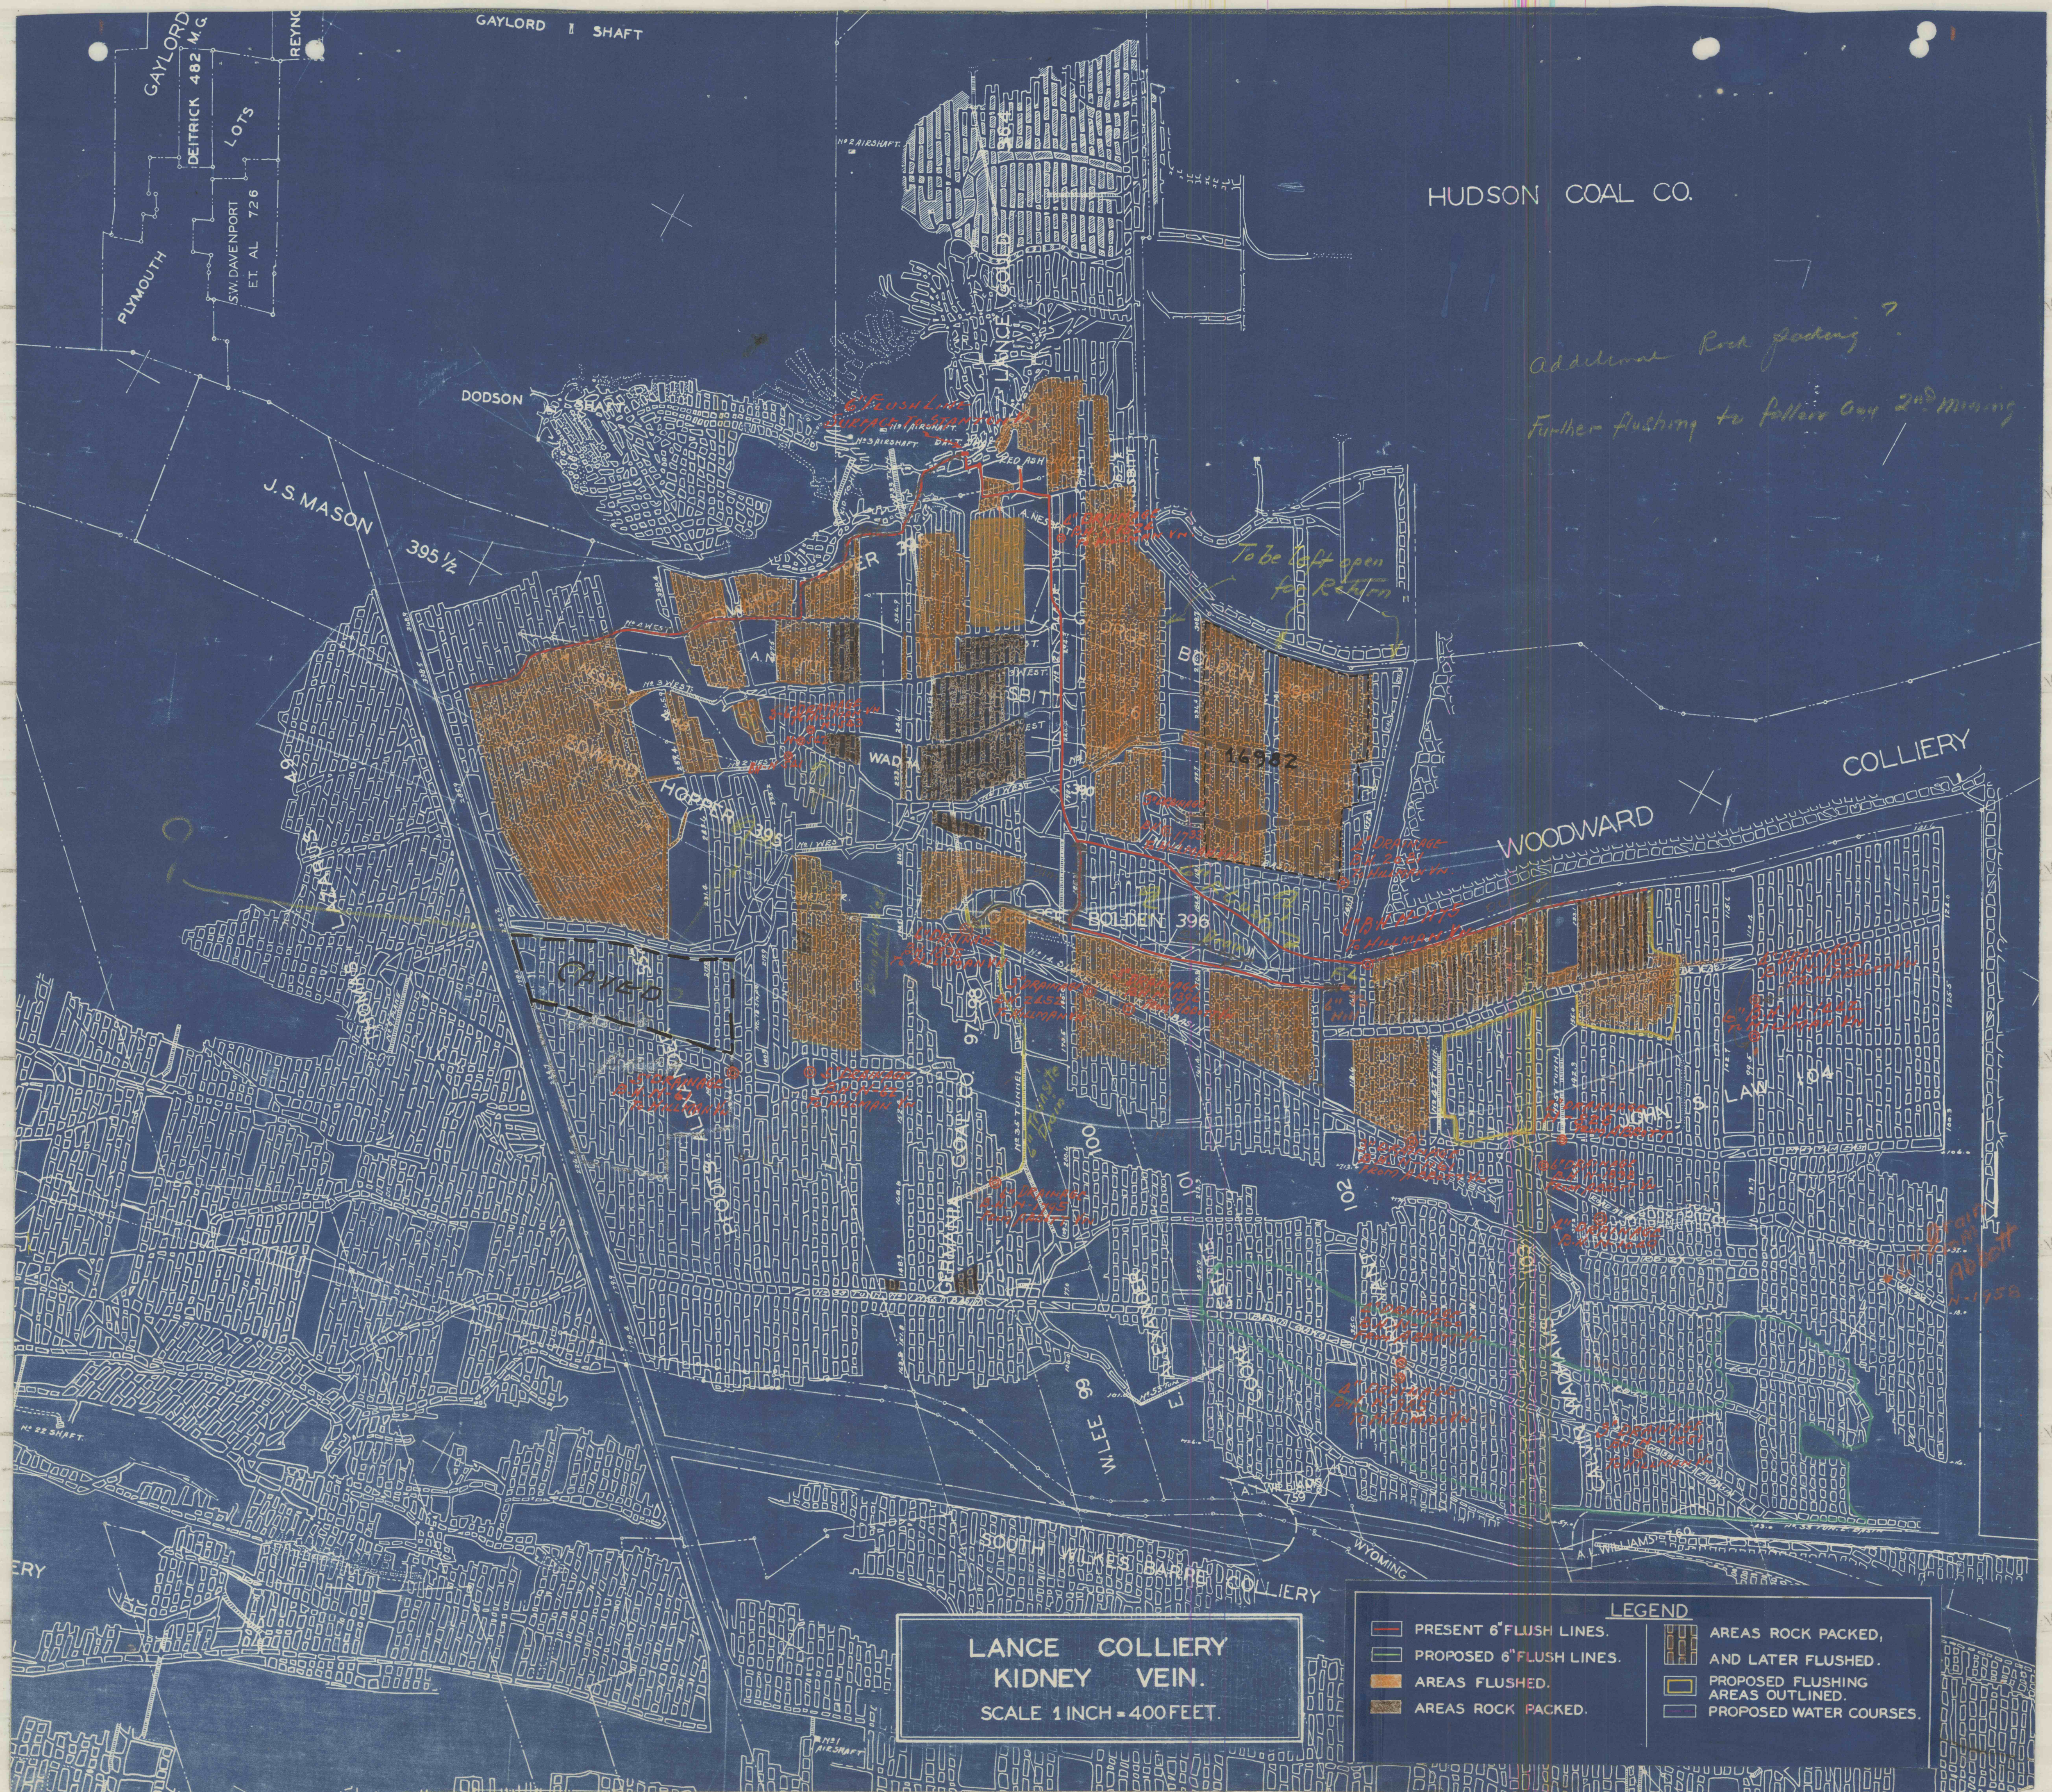

HUDSON COAL CO.

Additional Rock packing?
Further flushing to follow on 2nd mining

LANCE COLLIERY
KIDNEY VEIN.
SCALE 1 INCH = 400 FEET.

LEGEND

PRESENT 6" FLUSH LINES.	AREAS ROCK PACKED, AND LATER FLUSHED.
PROPOSED 6" FLUSH LINES.	PROPOSED FLUSHING AREAS OUTLINED.
AREAS FLUSHED.	PROPOSED WATER COURSES.
AREAS ROCK PACKED.	