


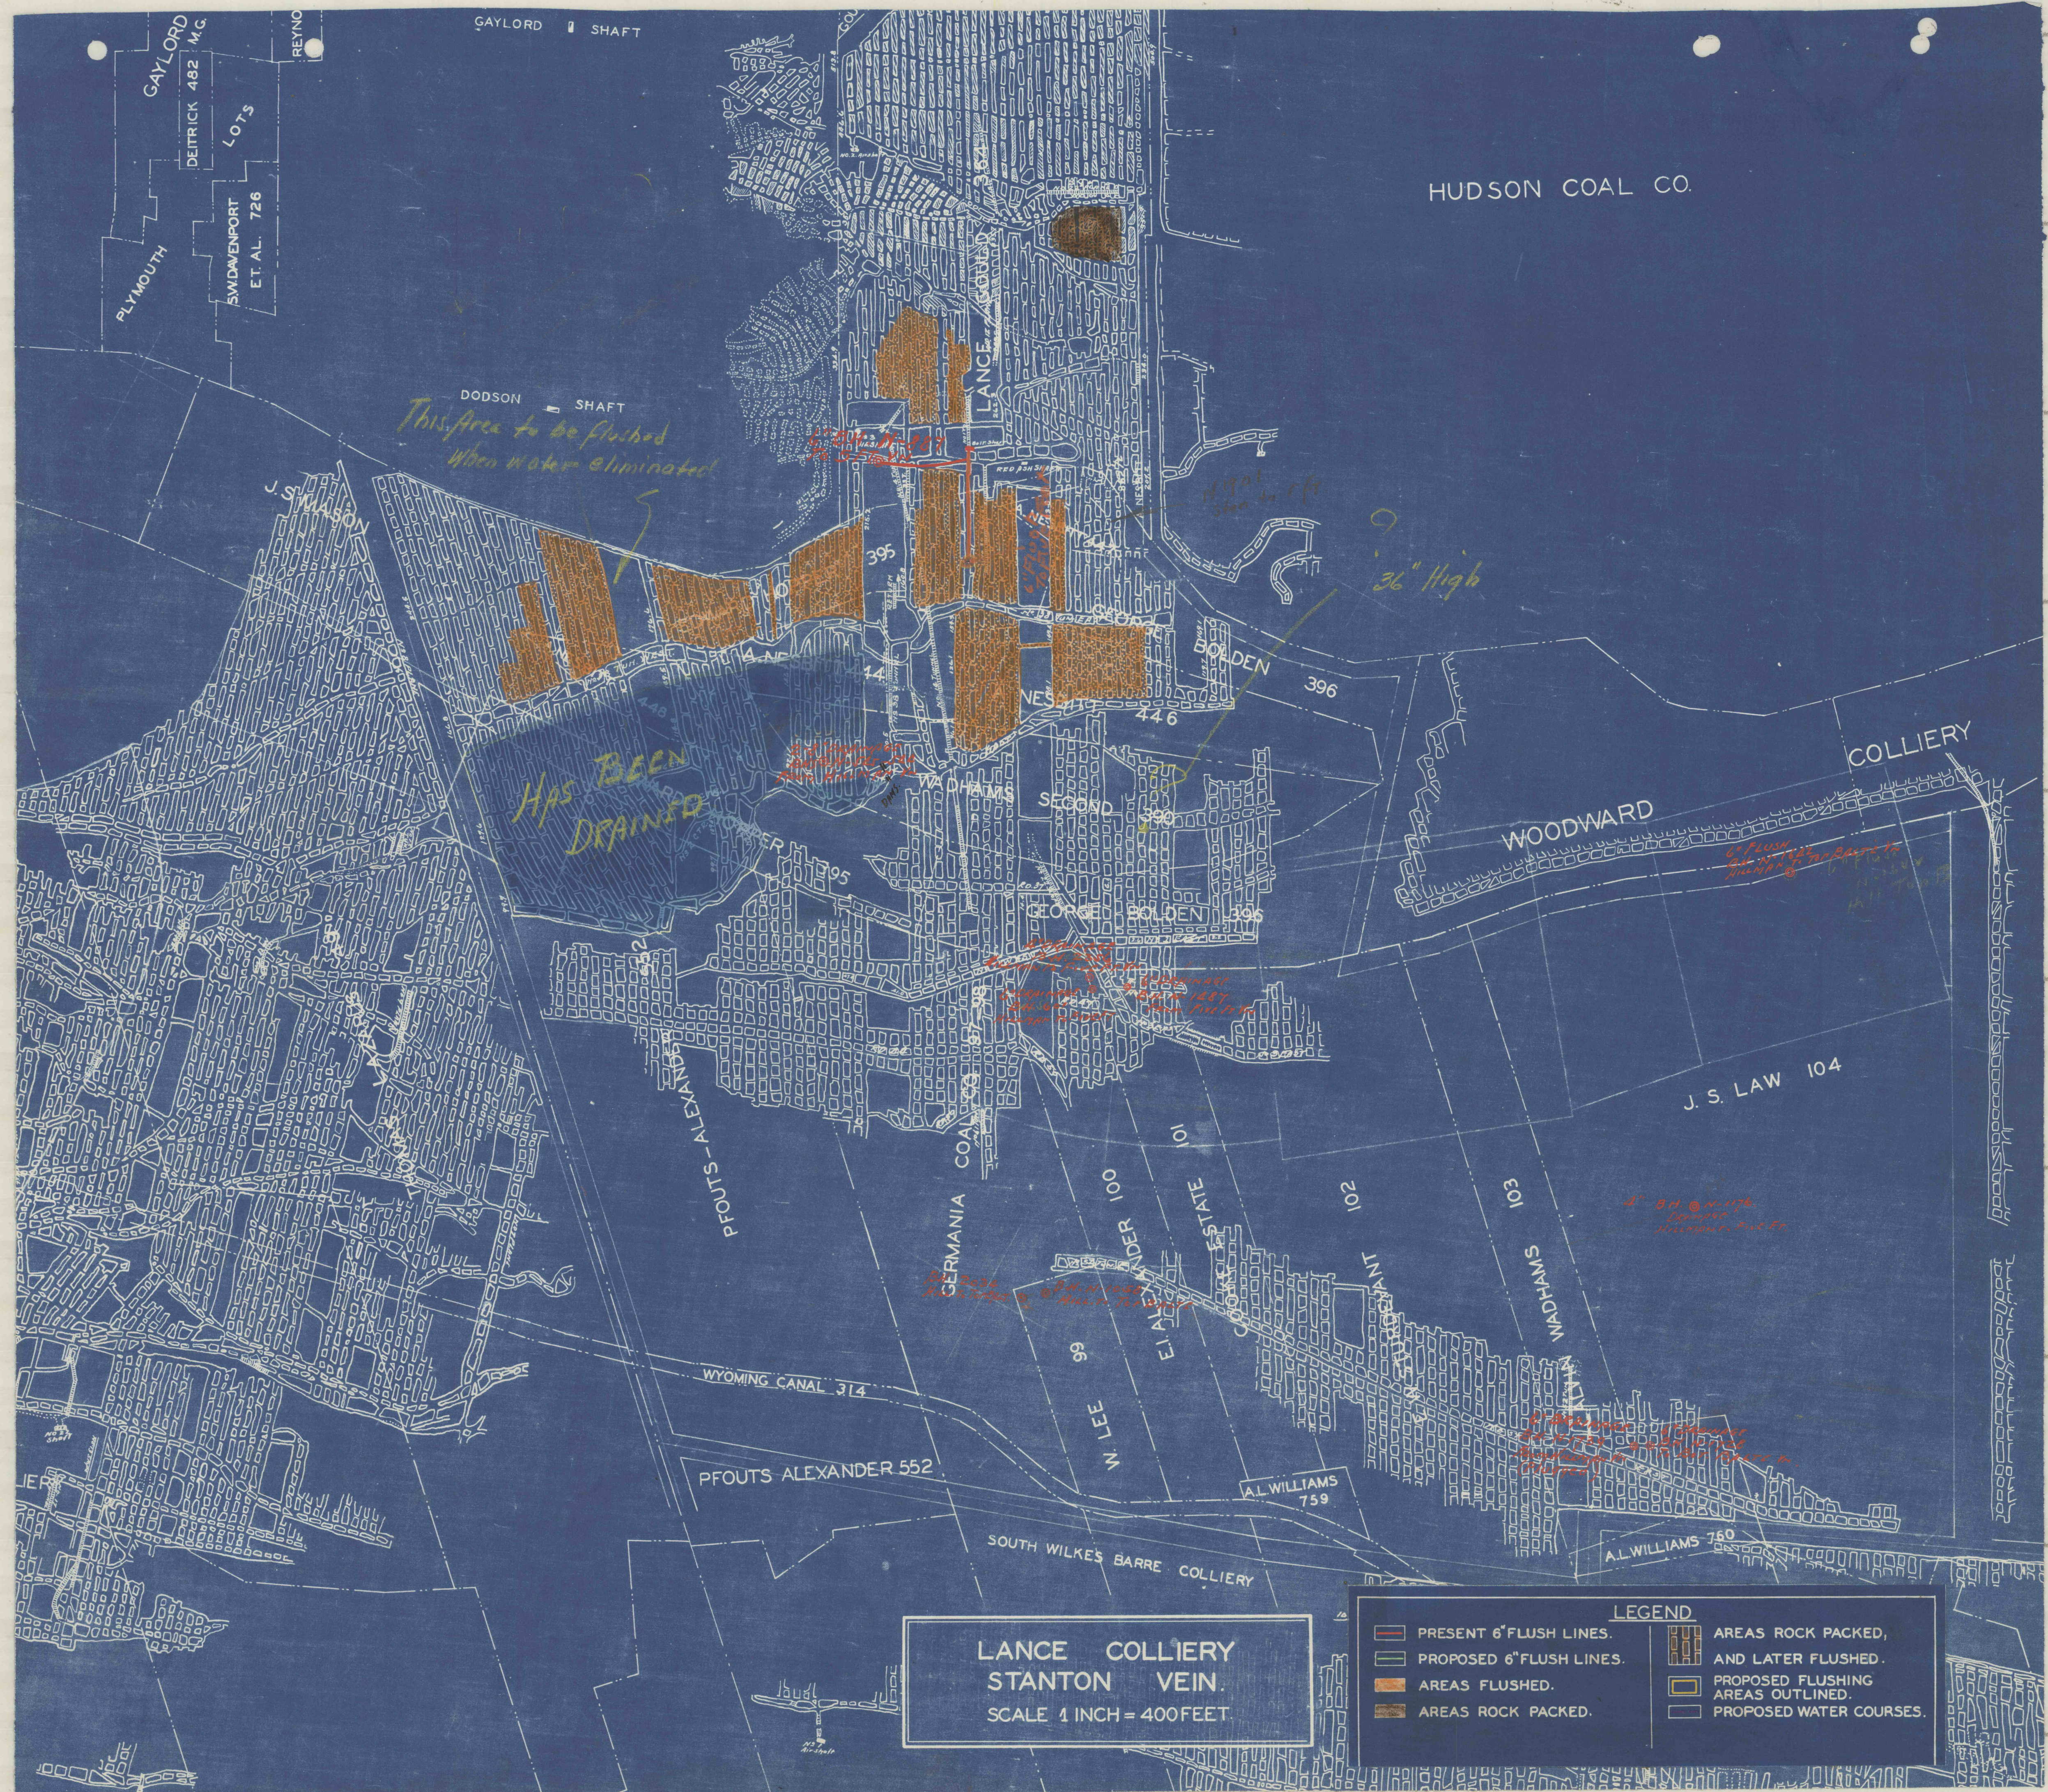

HUDSON COAL CO.

*This Area to be flushed
when water eliminated*

*HAS BEEN
DRAINED*

36" High

*6" Flush
with water
from 100 ft*

*4" 3 H. @ 100 ft
DRAINAGE
WATER 100 ft*

*4" 3 H. @ 100 ft
DRAINAGE
WATER 100 ft*

LANCE COLLIERY
STANTON VEIN.

SCALE 1 INCH = 400 FEET

LEGEND

- | | |
|--------------------------|--|
| PRESENT 6" FLUSH LINES. | AREAS ROCK PACKED,
AND LATER FLUSHED. |
| PROPOSED 6" FLUSH LINES. | PROPOSED FLUSHING
AREAS OUTLINED. |
| AREAS FLUSHED. | PROPOSED WATER COURSES. |
| AREAS ROCK PACKED. | |