


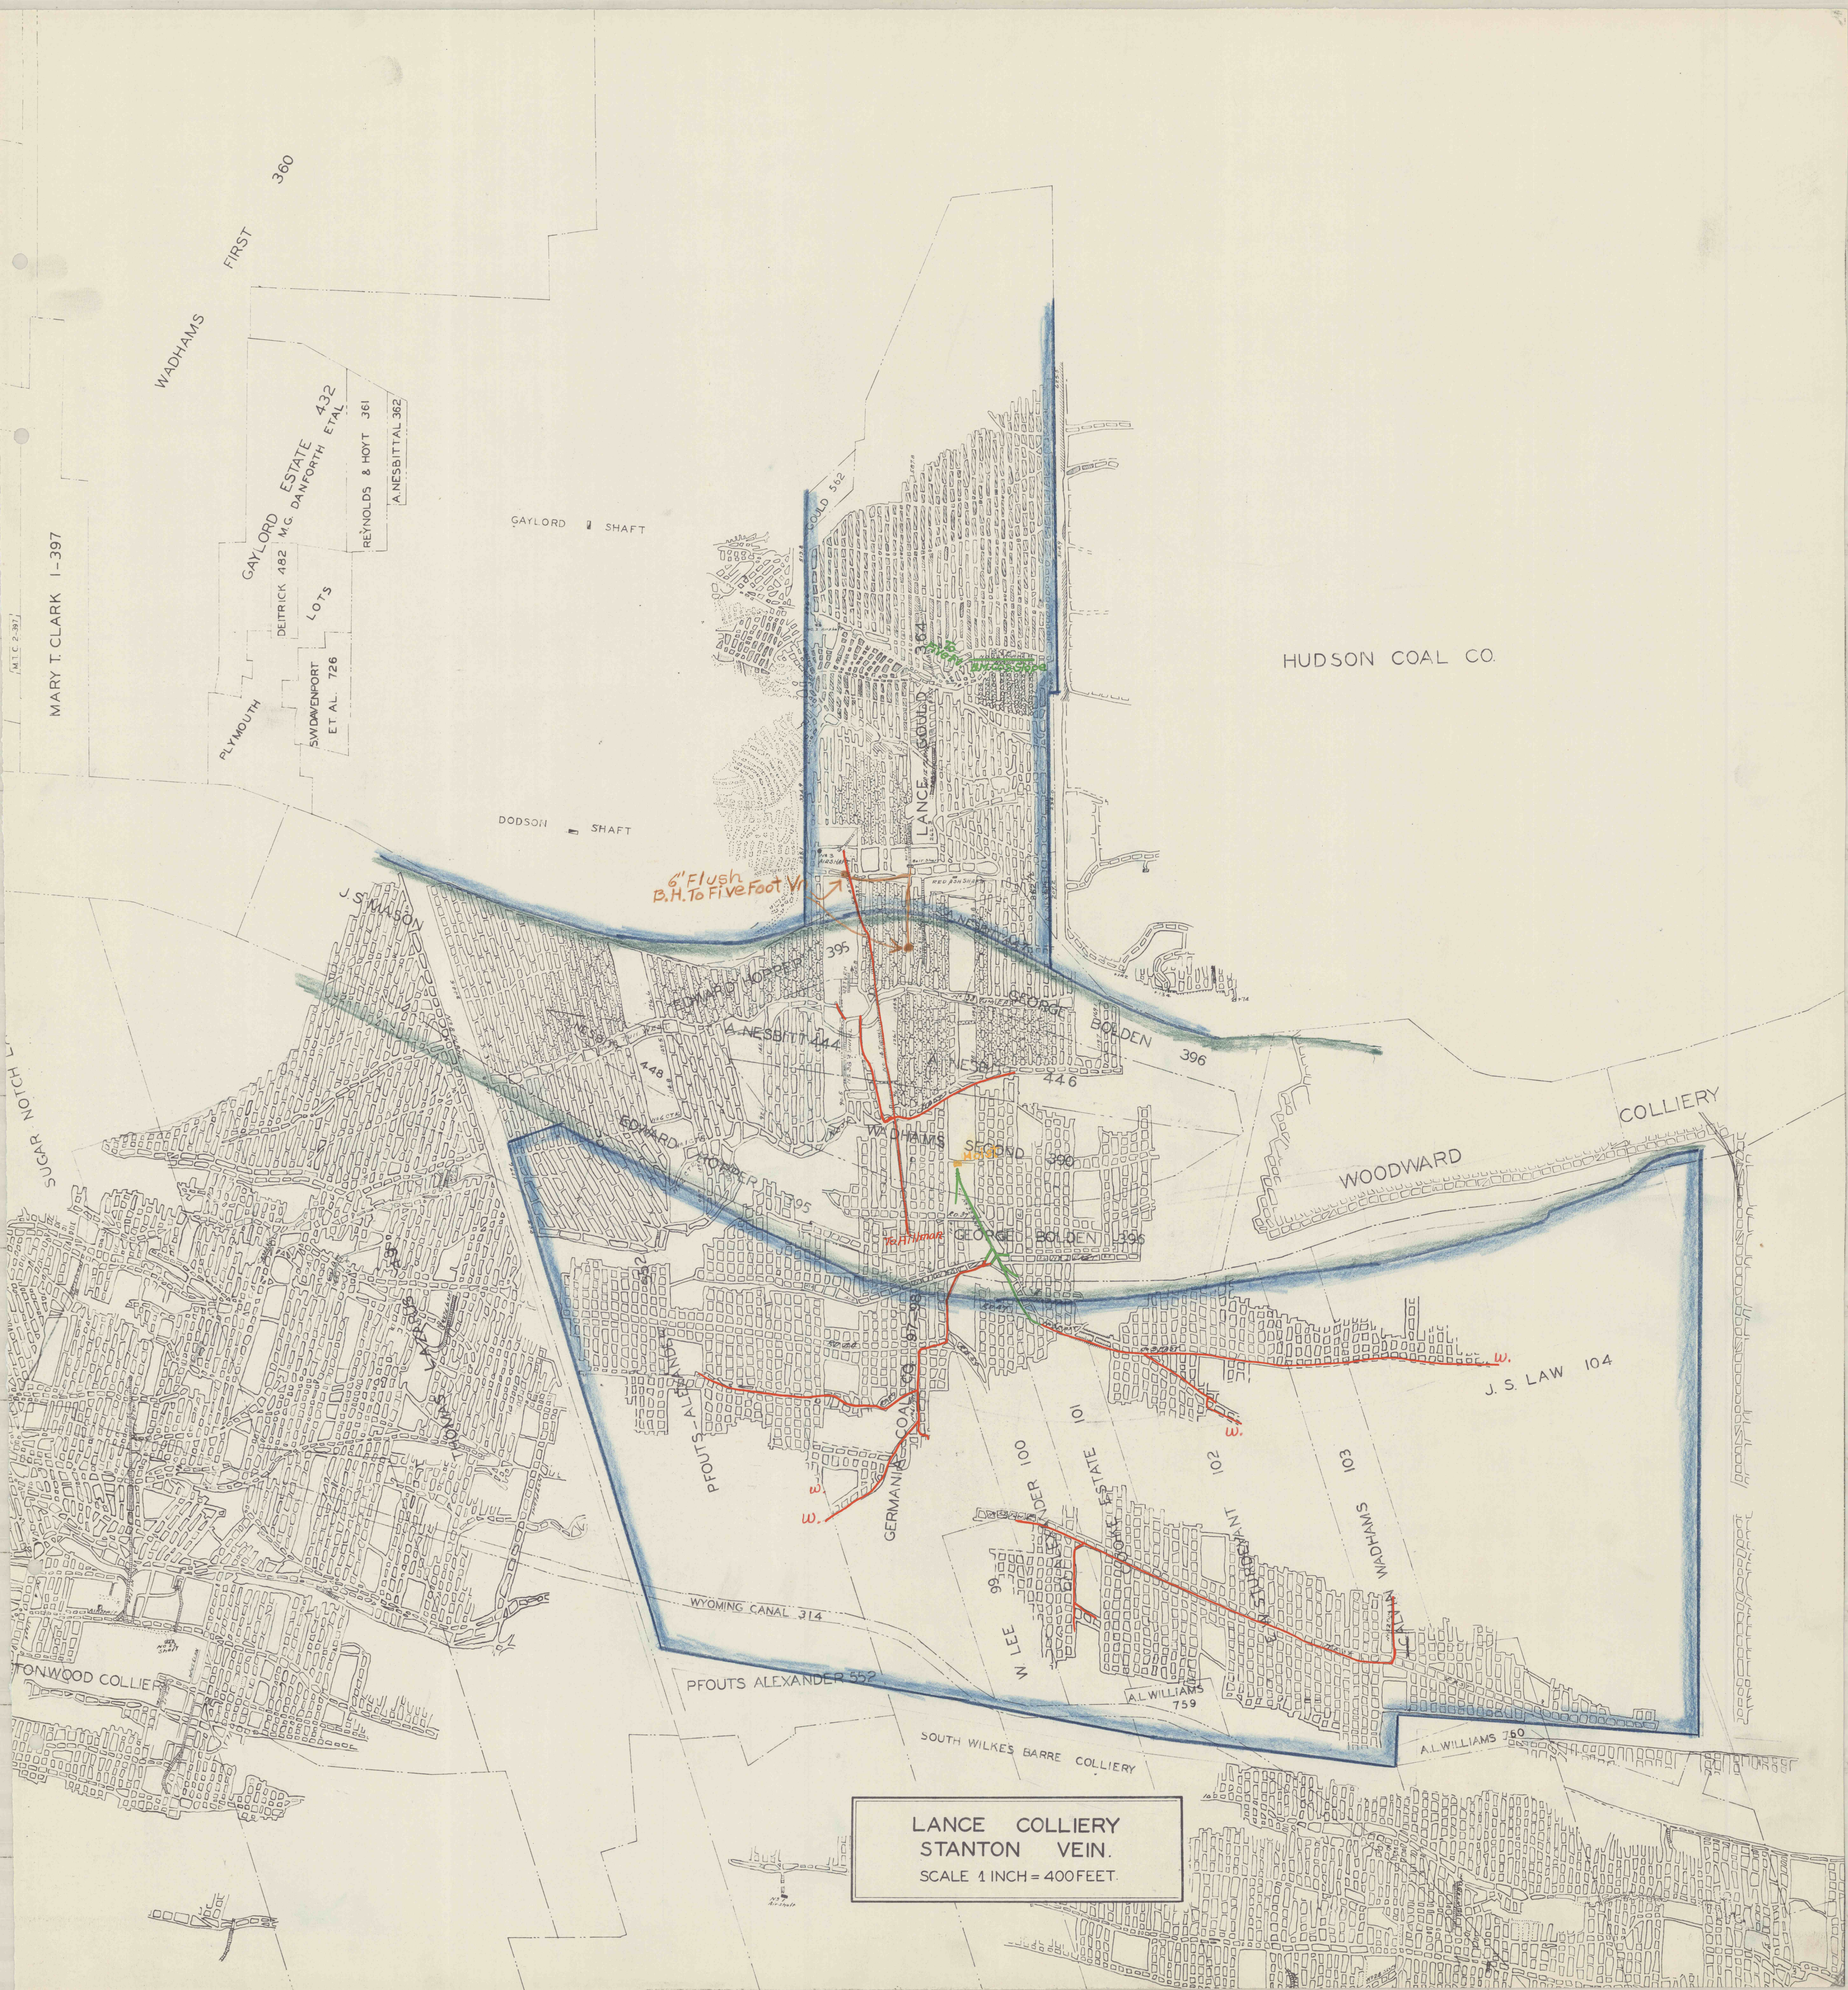

MARY T. CLARK 1-397

FIRST

360

WADHAMS

PLYMOUTH
DETRICK 482
GAYLORD ESTATE 432
M.C. DANFORTH ET AL
REYNOLDS & HOYT 361
A. NESBITT 362

GAYLORD SHAFT

DODSON SHAFT

HUDSON COAL CO.

COLLIERY

WOODWARD

J. S. LAW 104

WYOMING CANAL 314

PFOUTS ALEXANDER 552

SOUTH WILKES BARRE COLLIERY

LANCE COLLIERY
STANTON VEIN.

SCALE 1 INCH = 400 FEET.