


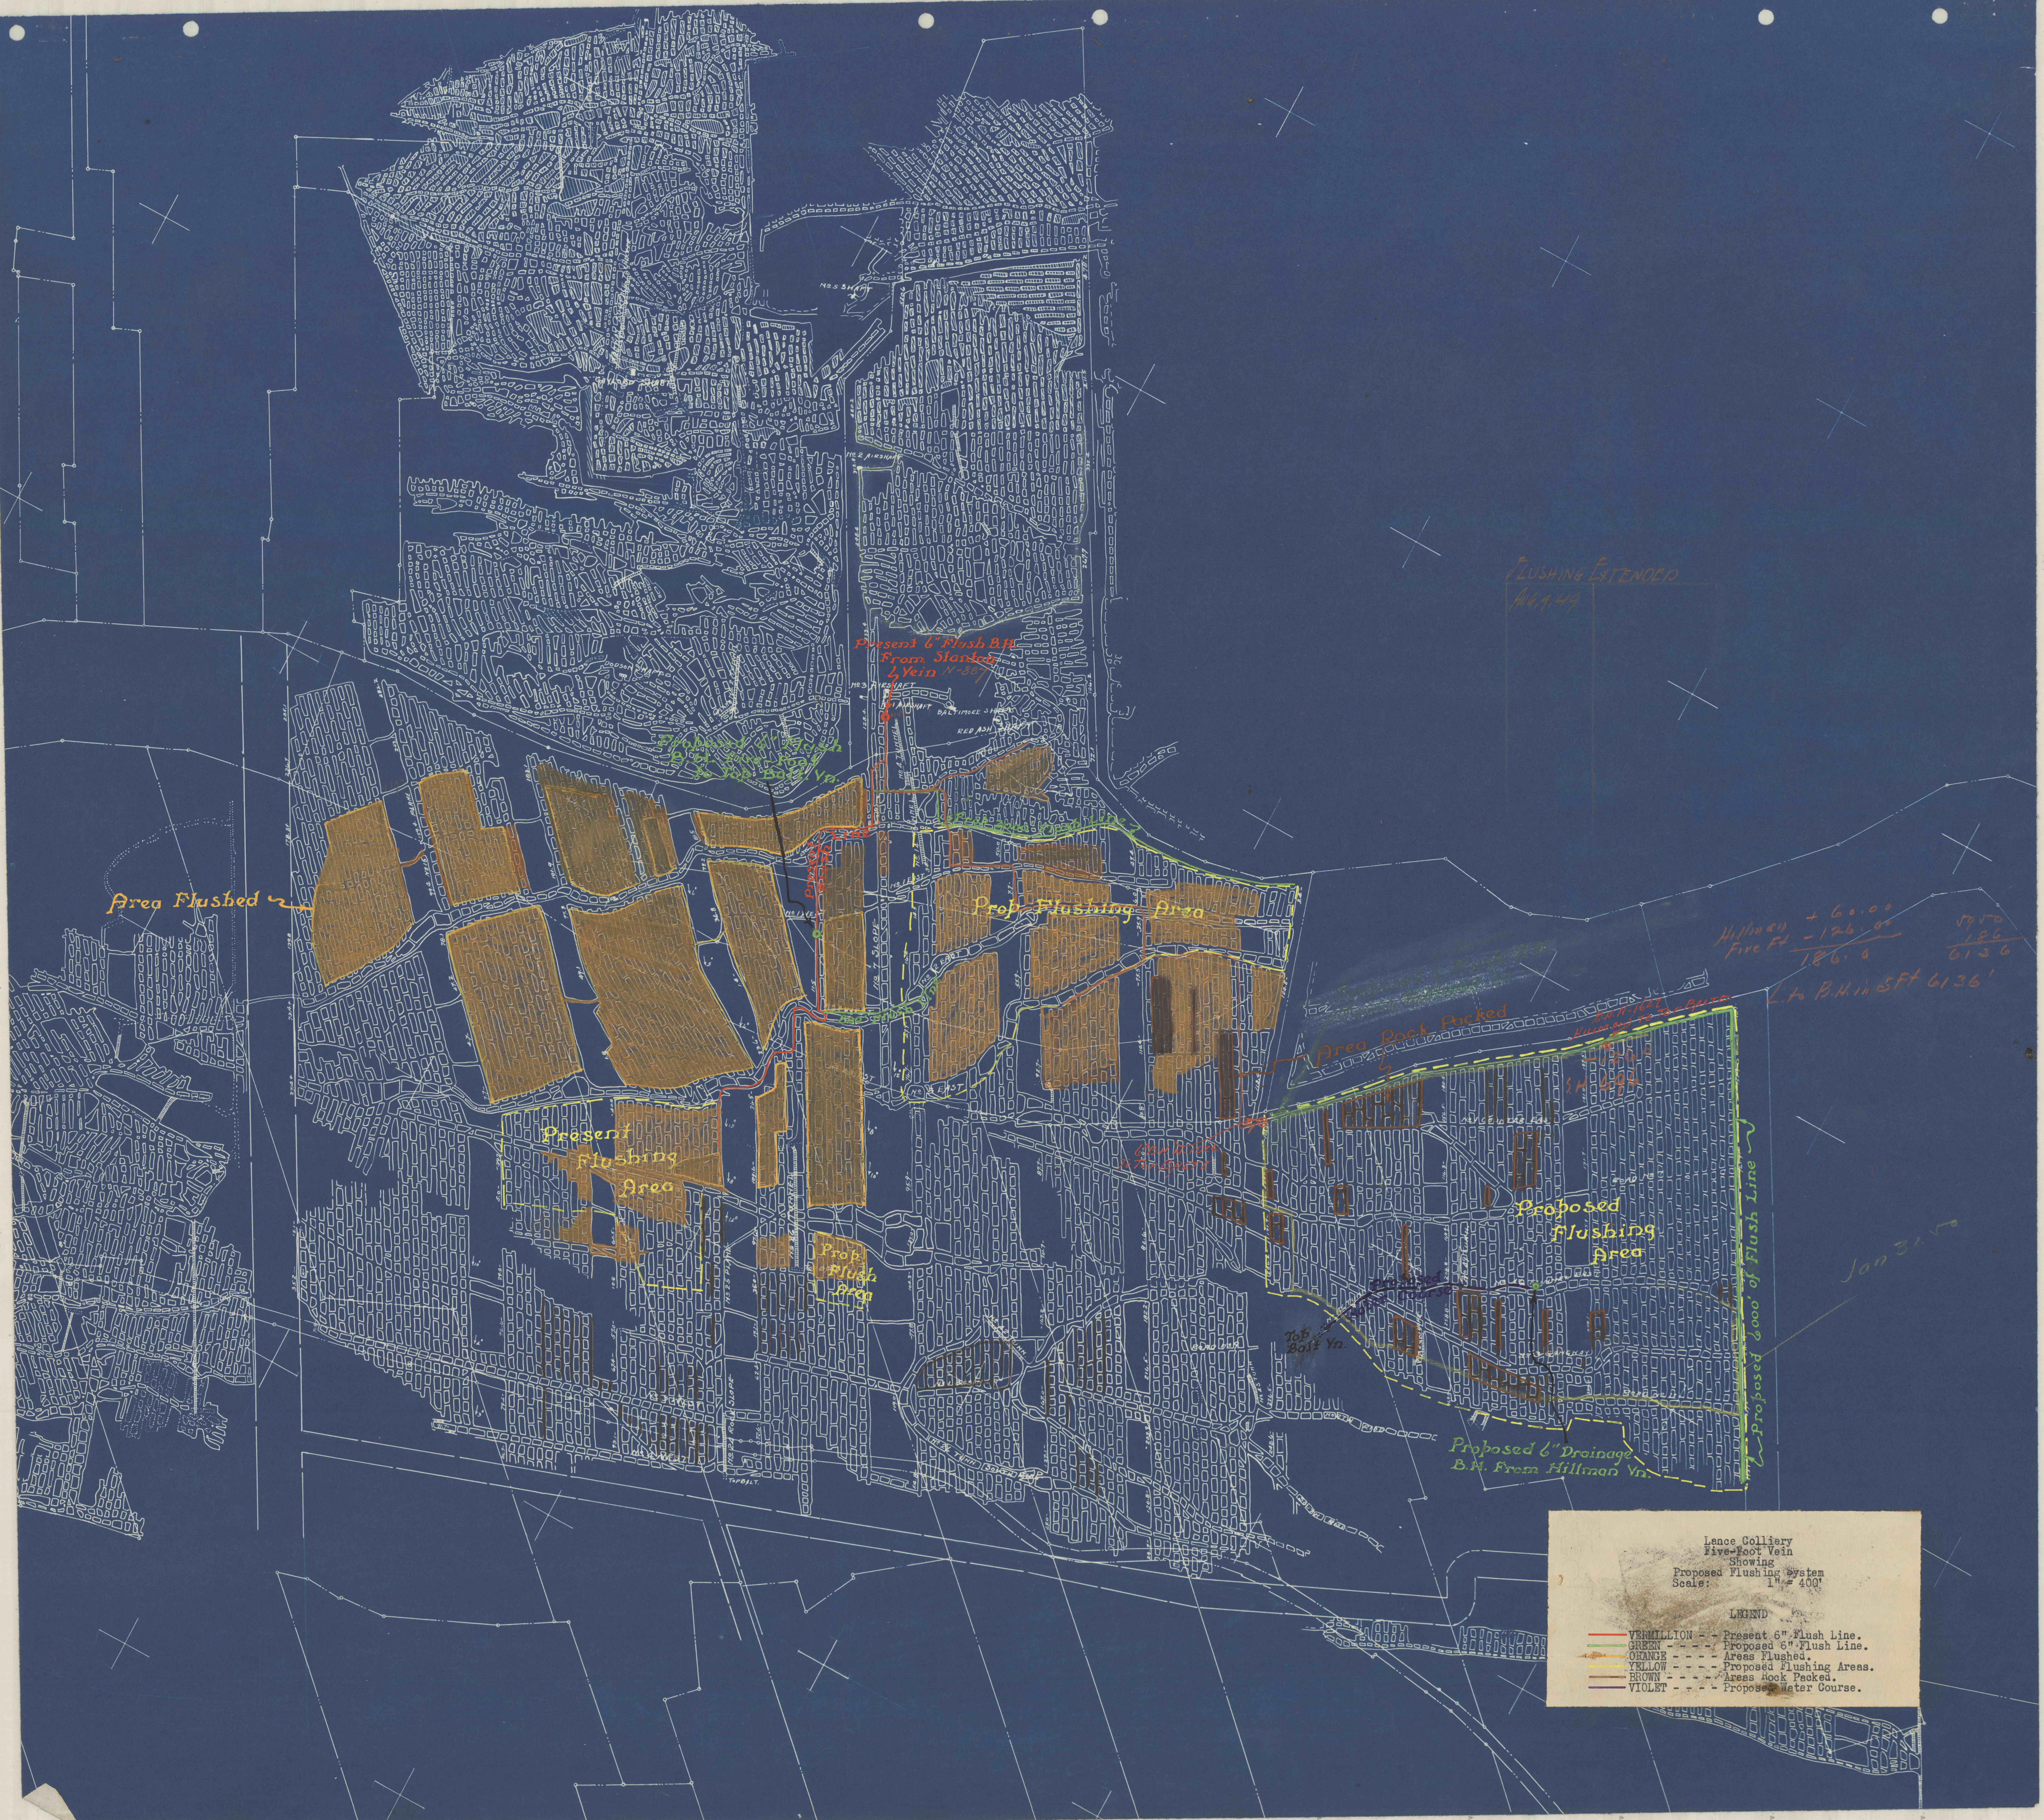

Flushing Extended
Aug. 1915

Hillman + 60.00
Five Ft - 126.00
186.00
186.00
6136'
L to B.H. in 5 Ft 6136'

Jan 31 1915

Lance Colliery
Five-foot Vein
Showing
Proposed Flushing System
Scale: 1" = 400'

LEGEND

VERMILLION	- - -	Present 6" Flush Line.
GREEN	- - -	Proposed 6" Flush Line.
ORANGE	- - -	Areas Flushed.
YELLOW	- - -	Proposed Flushing Areas.
BROWN	- - -	Areas Back Packed.
VIOLET	- - -	Proposed Water Course.