


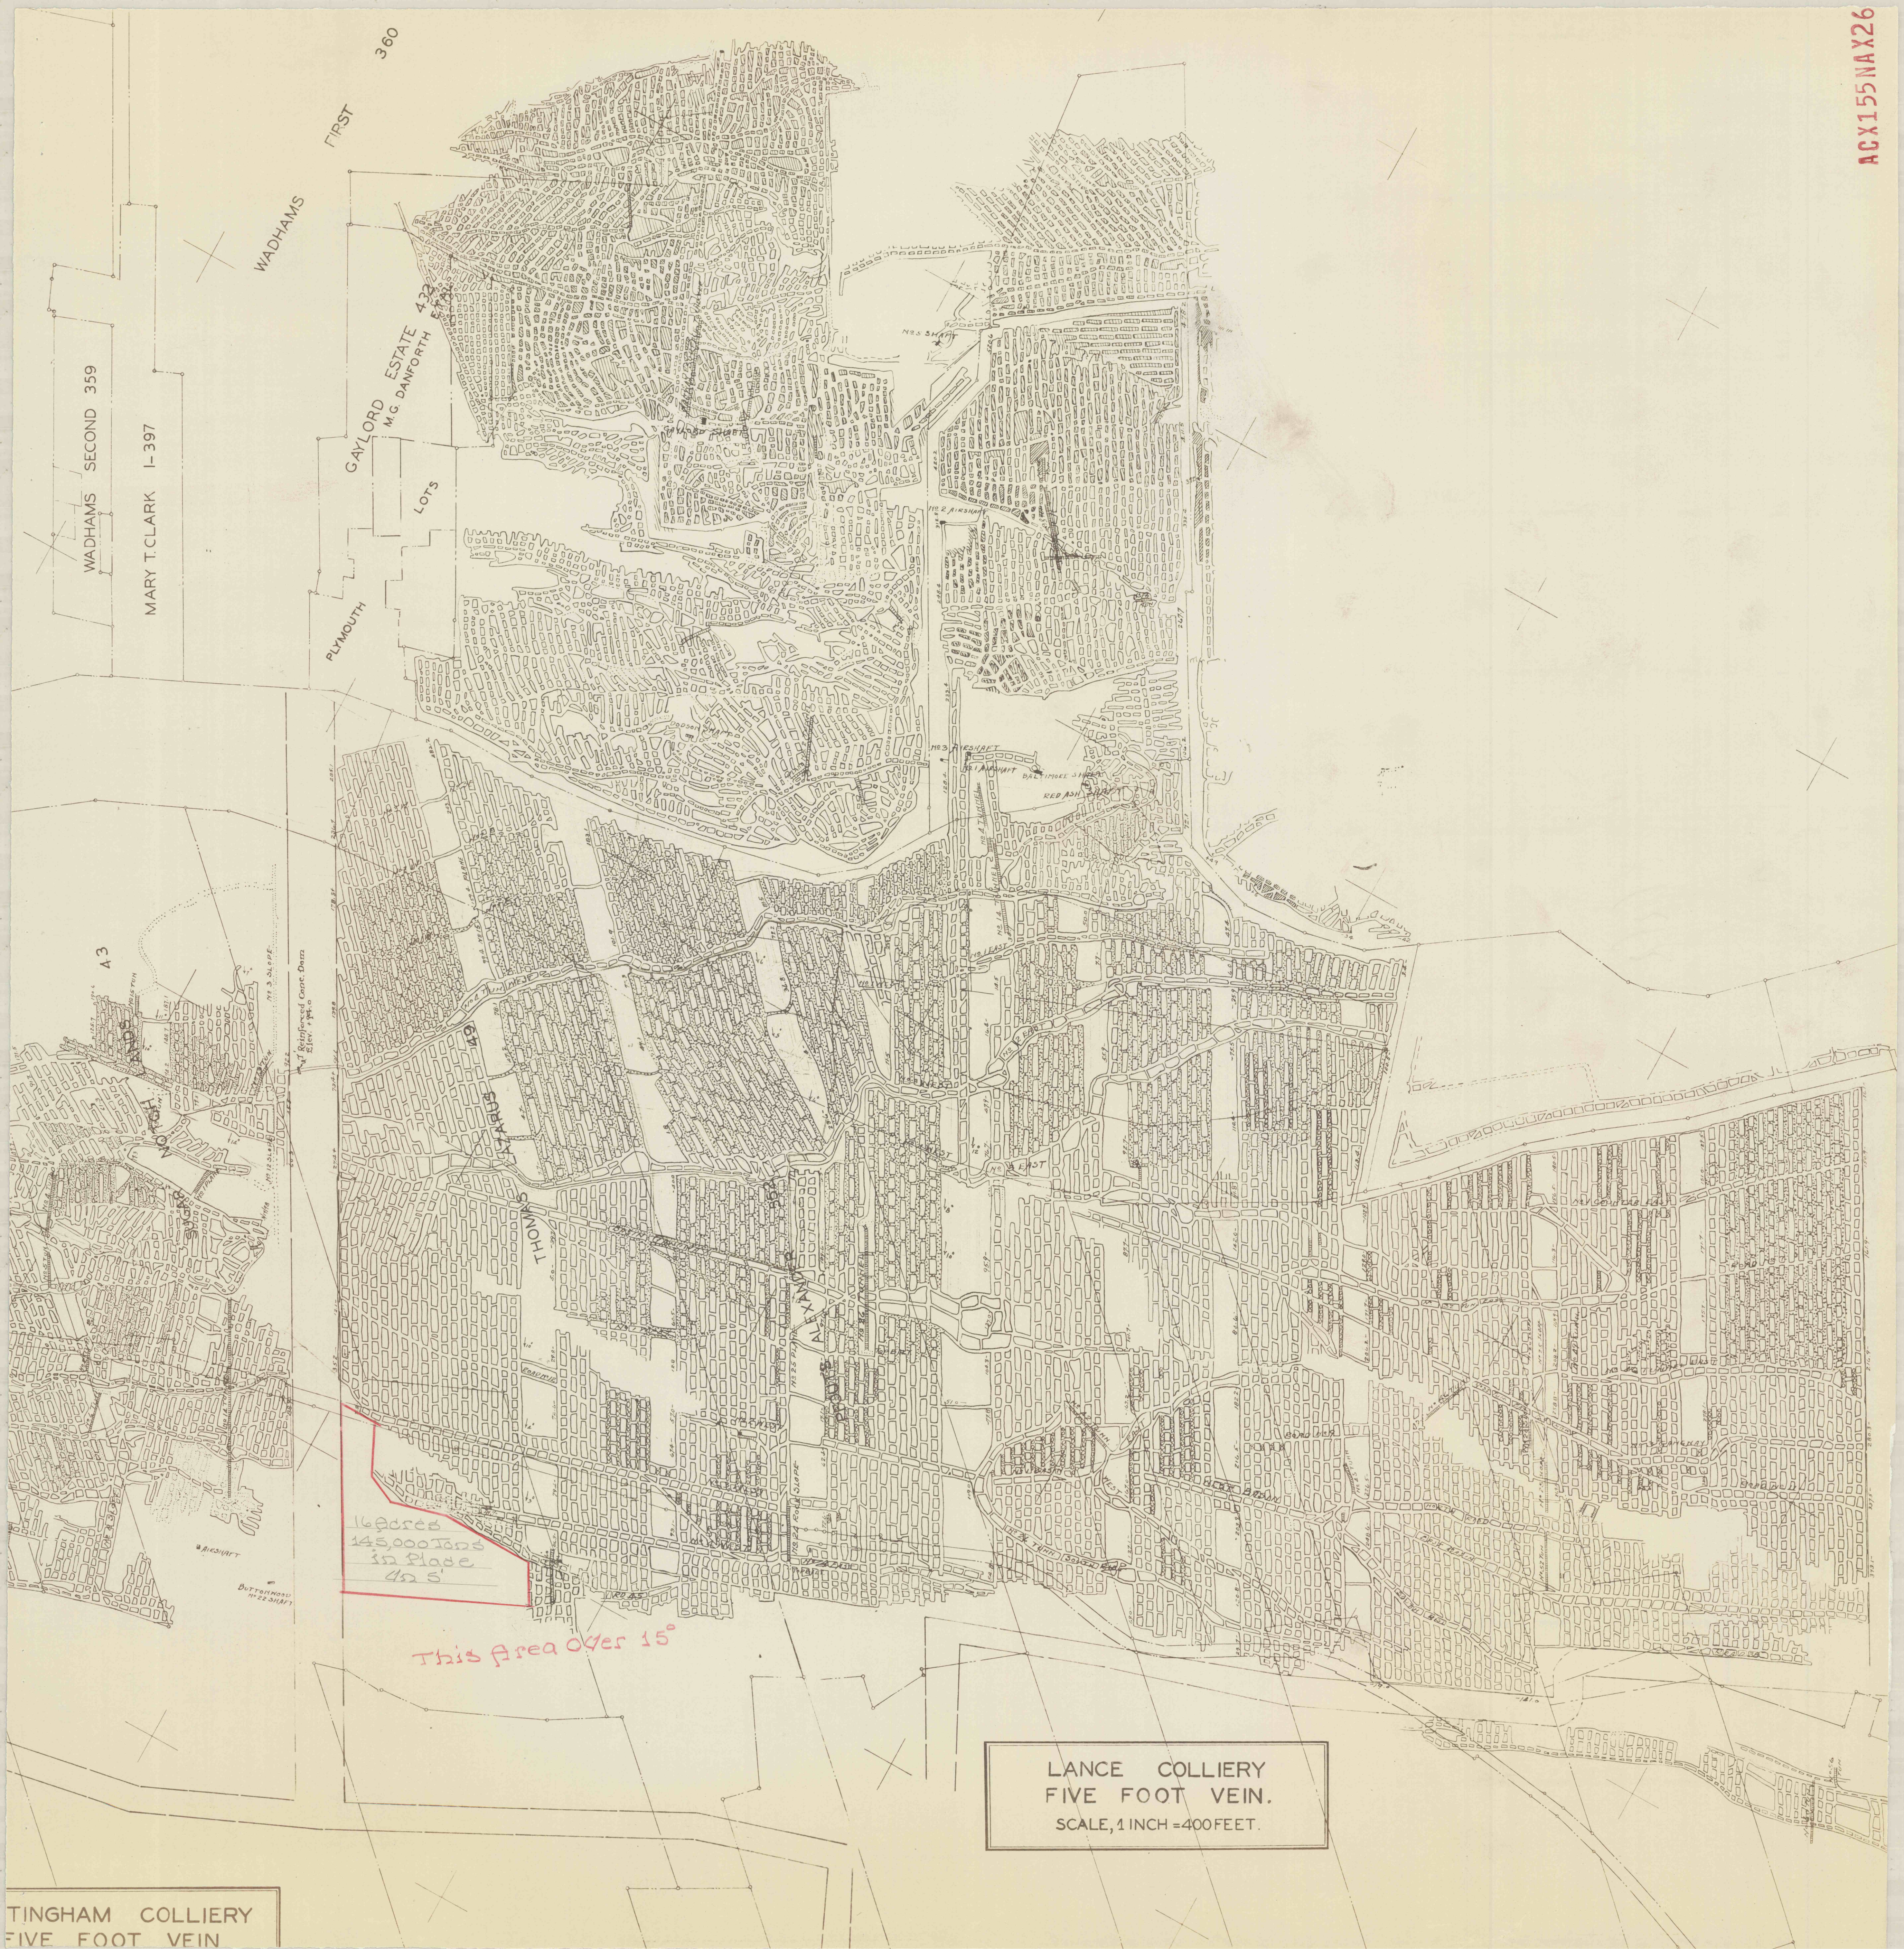

360

WADHAMS

FIRST

GAYLORD ESTATE
M.G. DANFORTH

LOTS

PLYMOUTH

WADHAMS SECOND 359

MARY T. CLARK 1-397

A 3

16 acres
145,000 tons
in place
425'

THOMAS

This Area Over 15°

LANCE COLLIERY
FIVE FOOT VEIN.
SCALE, 1 INCH = 400 FEET.

TINGHAM COLLIERY
FIVE FOOT VEIN

ACX155NAX26