


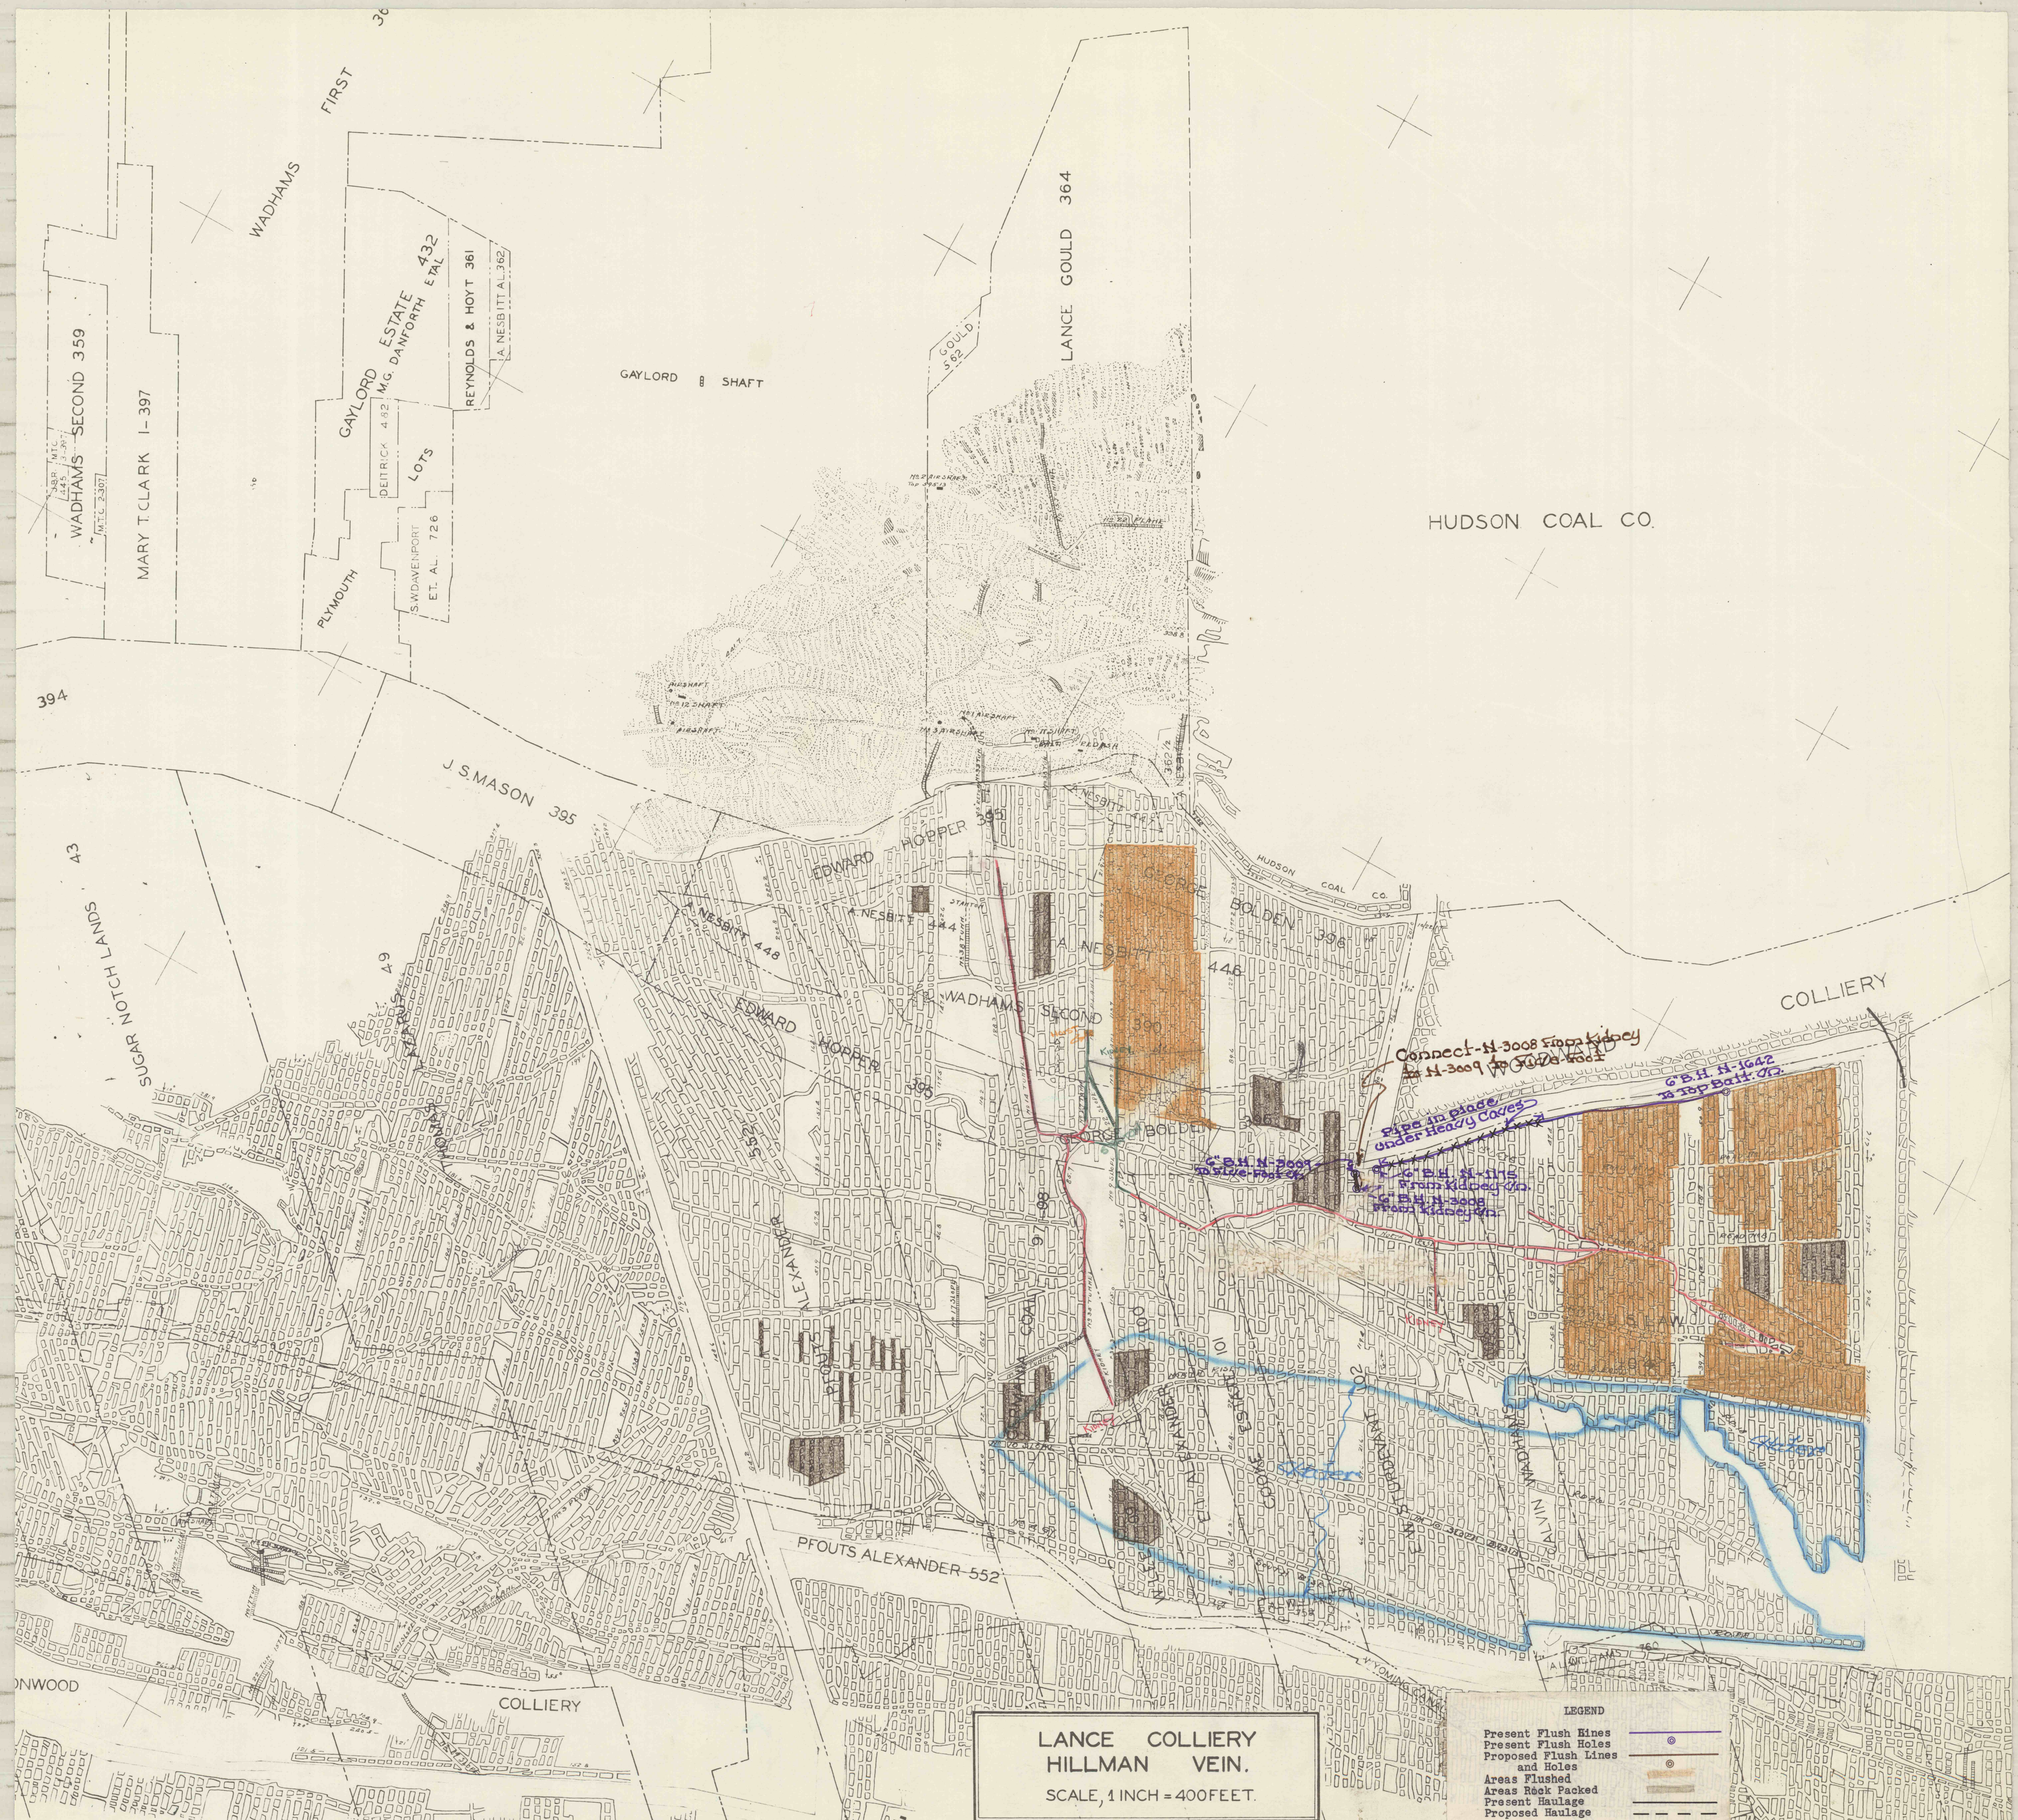

WADHAMS SECOND 359
MARY T CLARK 1-397
GAYLORD ESTATE 432
M.G. DANFORTH EAL
REYNOLDS & HOYT 361
A. NESBITT AL 362
DETRICK 492
PLYMOUTH
SWDAVENPORT
ET. AL. 726

GAYLORD SHAFT

GOULD 562

LANCE GOULD 364

HUDSON COAL CO.

J.S. MASON 395

SUGAR NOTCH LANDS 43

EDWARD HOPPER

EDWARD HOPPER

A. NESBITT 444

HOPPER 395

WADHAMS SECOND 390

A. NESBITT 446

BOLDEN 396

Connect H-3008 from Kidecy
to H-3009 to Gode Road

Pipe in place
under heavy covers

C.B.H. H-3001
from Kidecy to
C.B.H. H-3008
from Kidecy to

C.B.H. H-1642
to Top Batt. Dr.

PFOOTS ALEXANDER-552

LANCE COLLIERY
HILLMAN VEIN.

SCALE, 1 INCH = 400 FEET.

LEGEND

- Present Flush Lines
- Present Flush Holes
- Proposed Flush Lines and Holes
- Areas Flushed
- Areas Rock Packed
- Present Haulage
- Proposed Haulage