


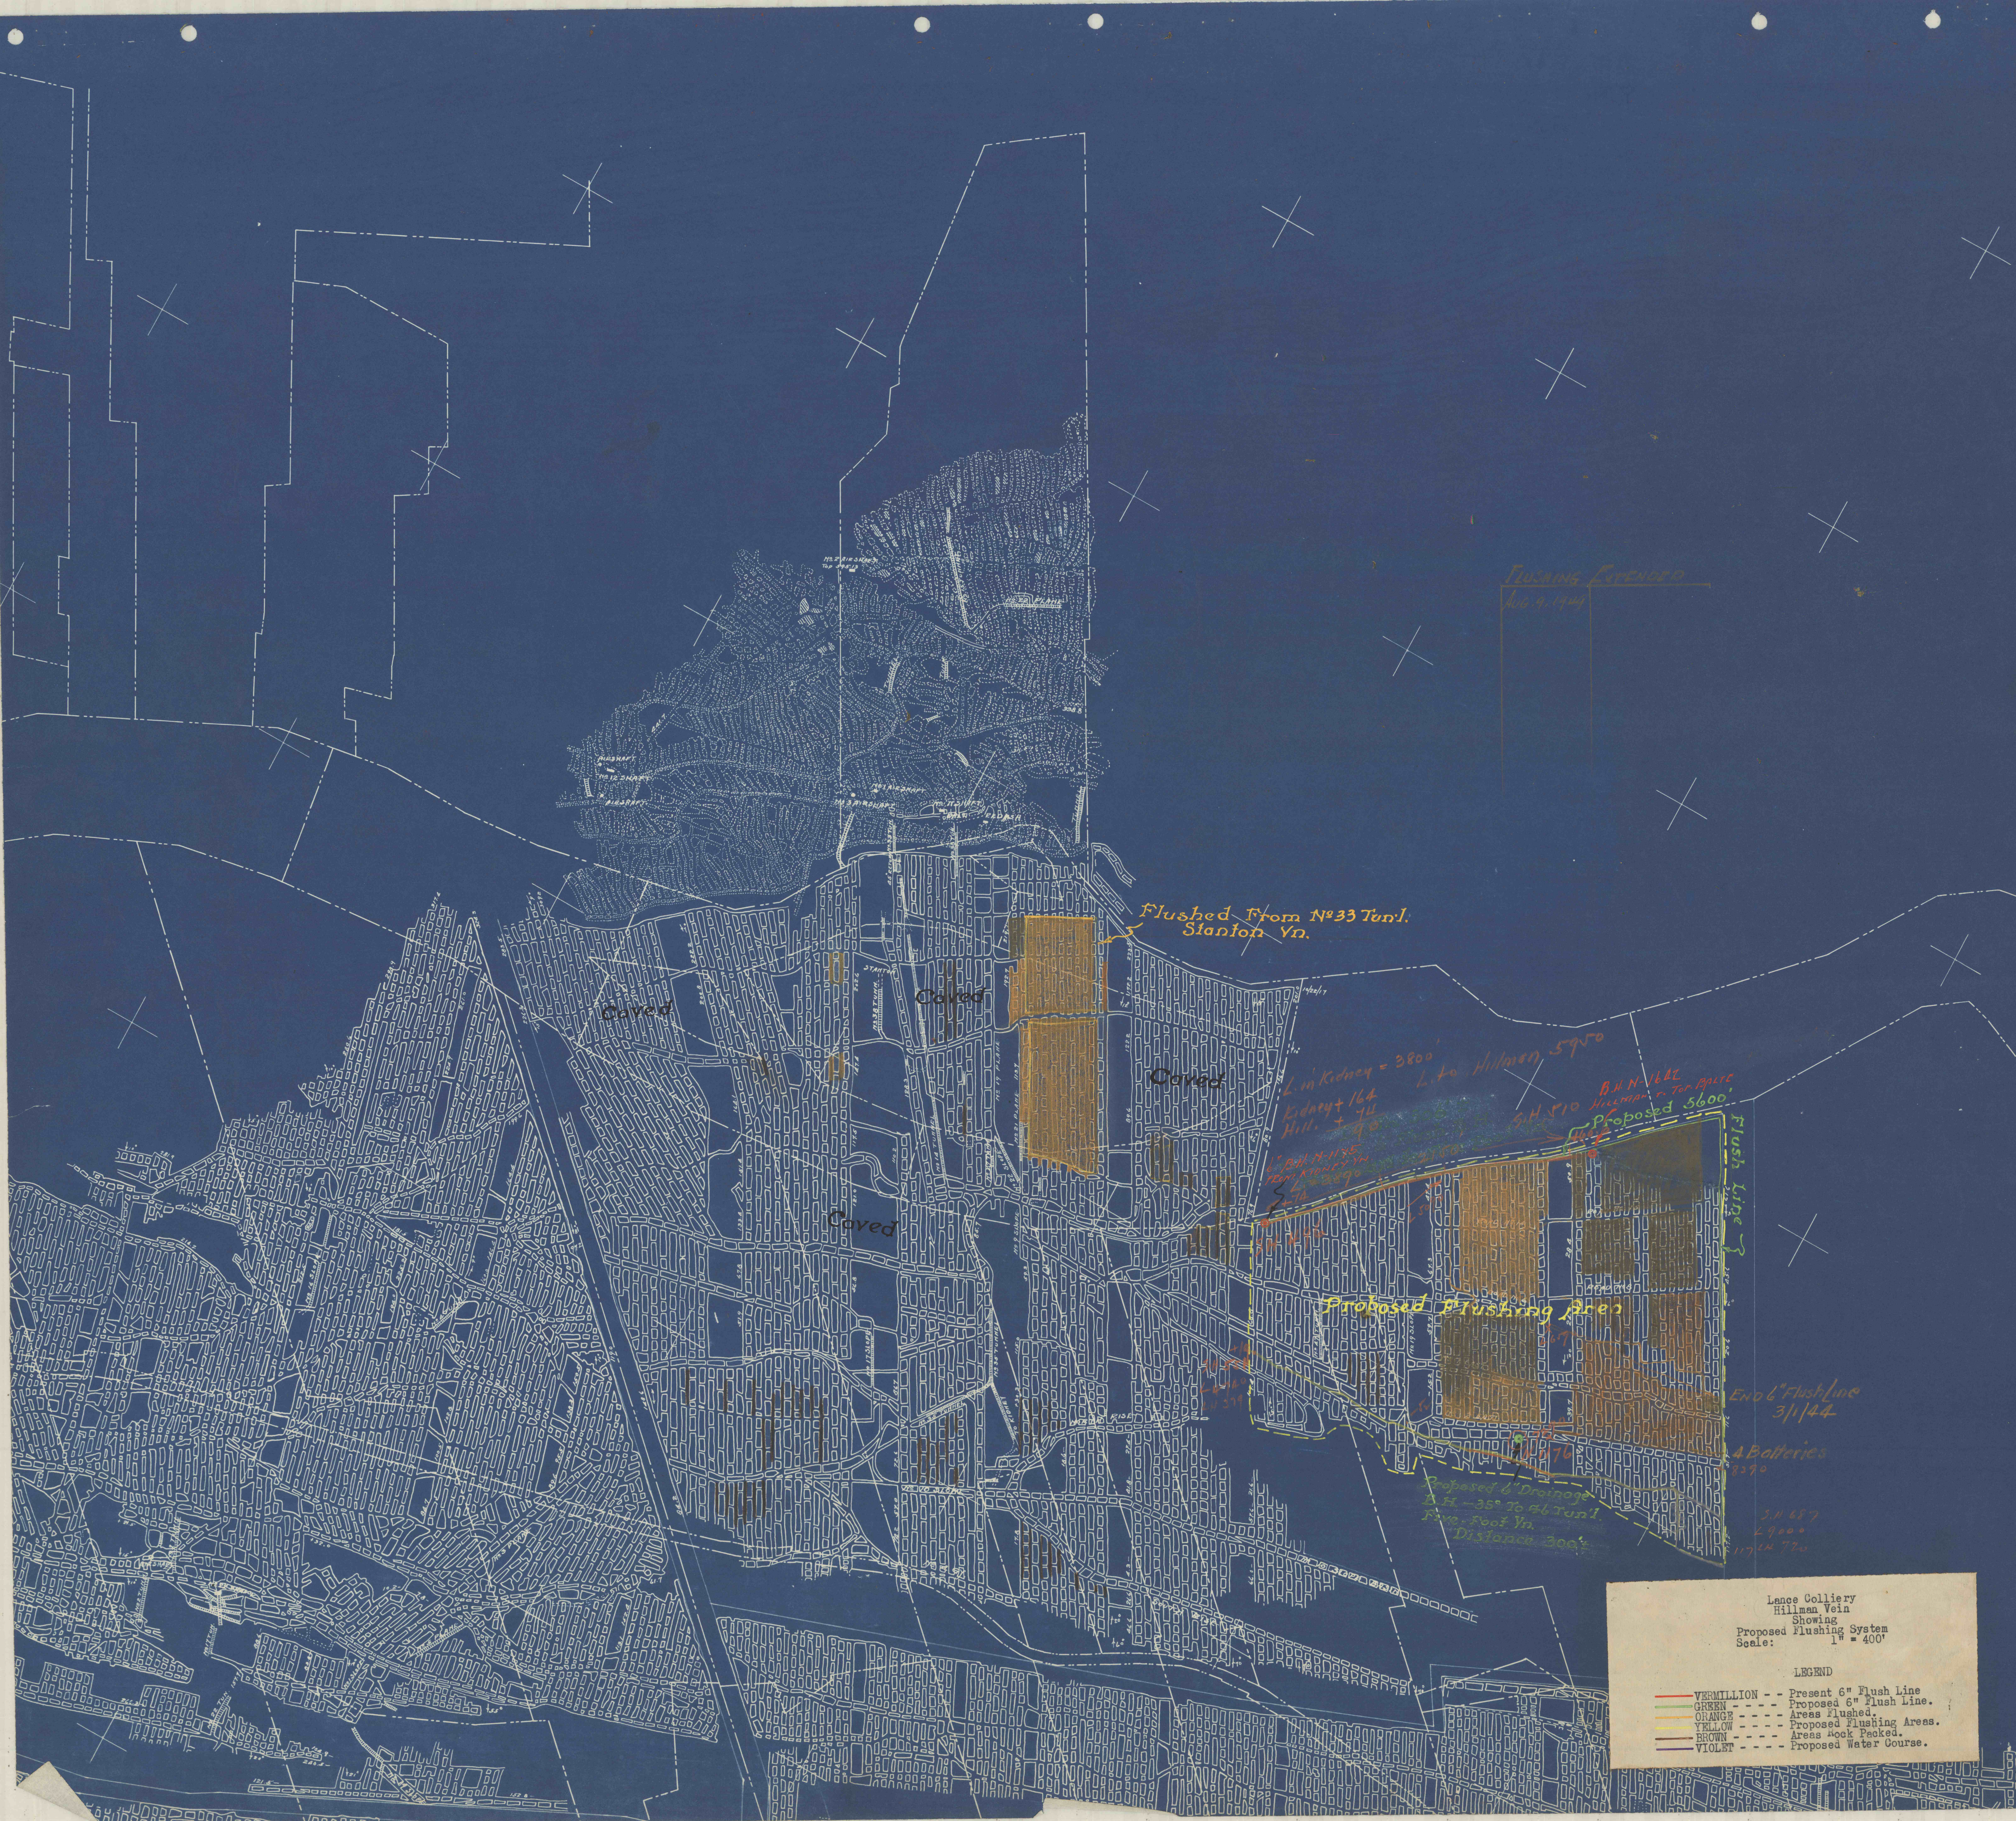

Lance Colliery
Hillman Vein
Showing
Proposed Flushing System
Scale: 1" = 400'

LEGEND

- VERMILLION - - Present 6" Flush Line
- GREEN - - - - Proposed 6" Flush Line.
- ORANGE - - - - Areas Flushed.
- YELLOW - - - - Proposed Flushing Areas.
- BROWN - - - - Areas Rock Packed.
- VIOLET - - - - Proposed Water Course.