


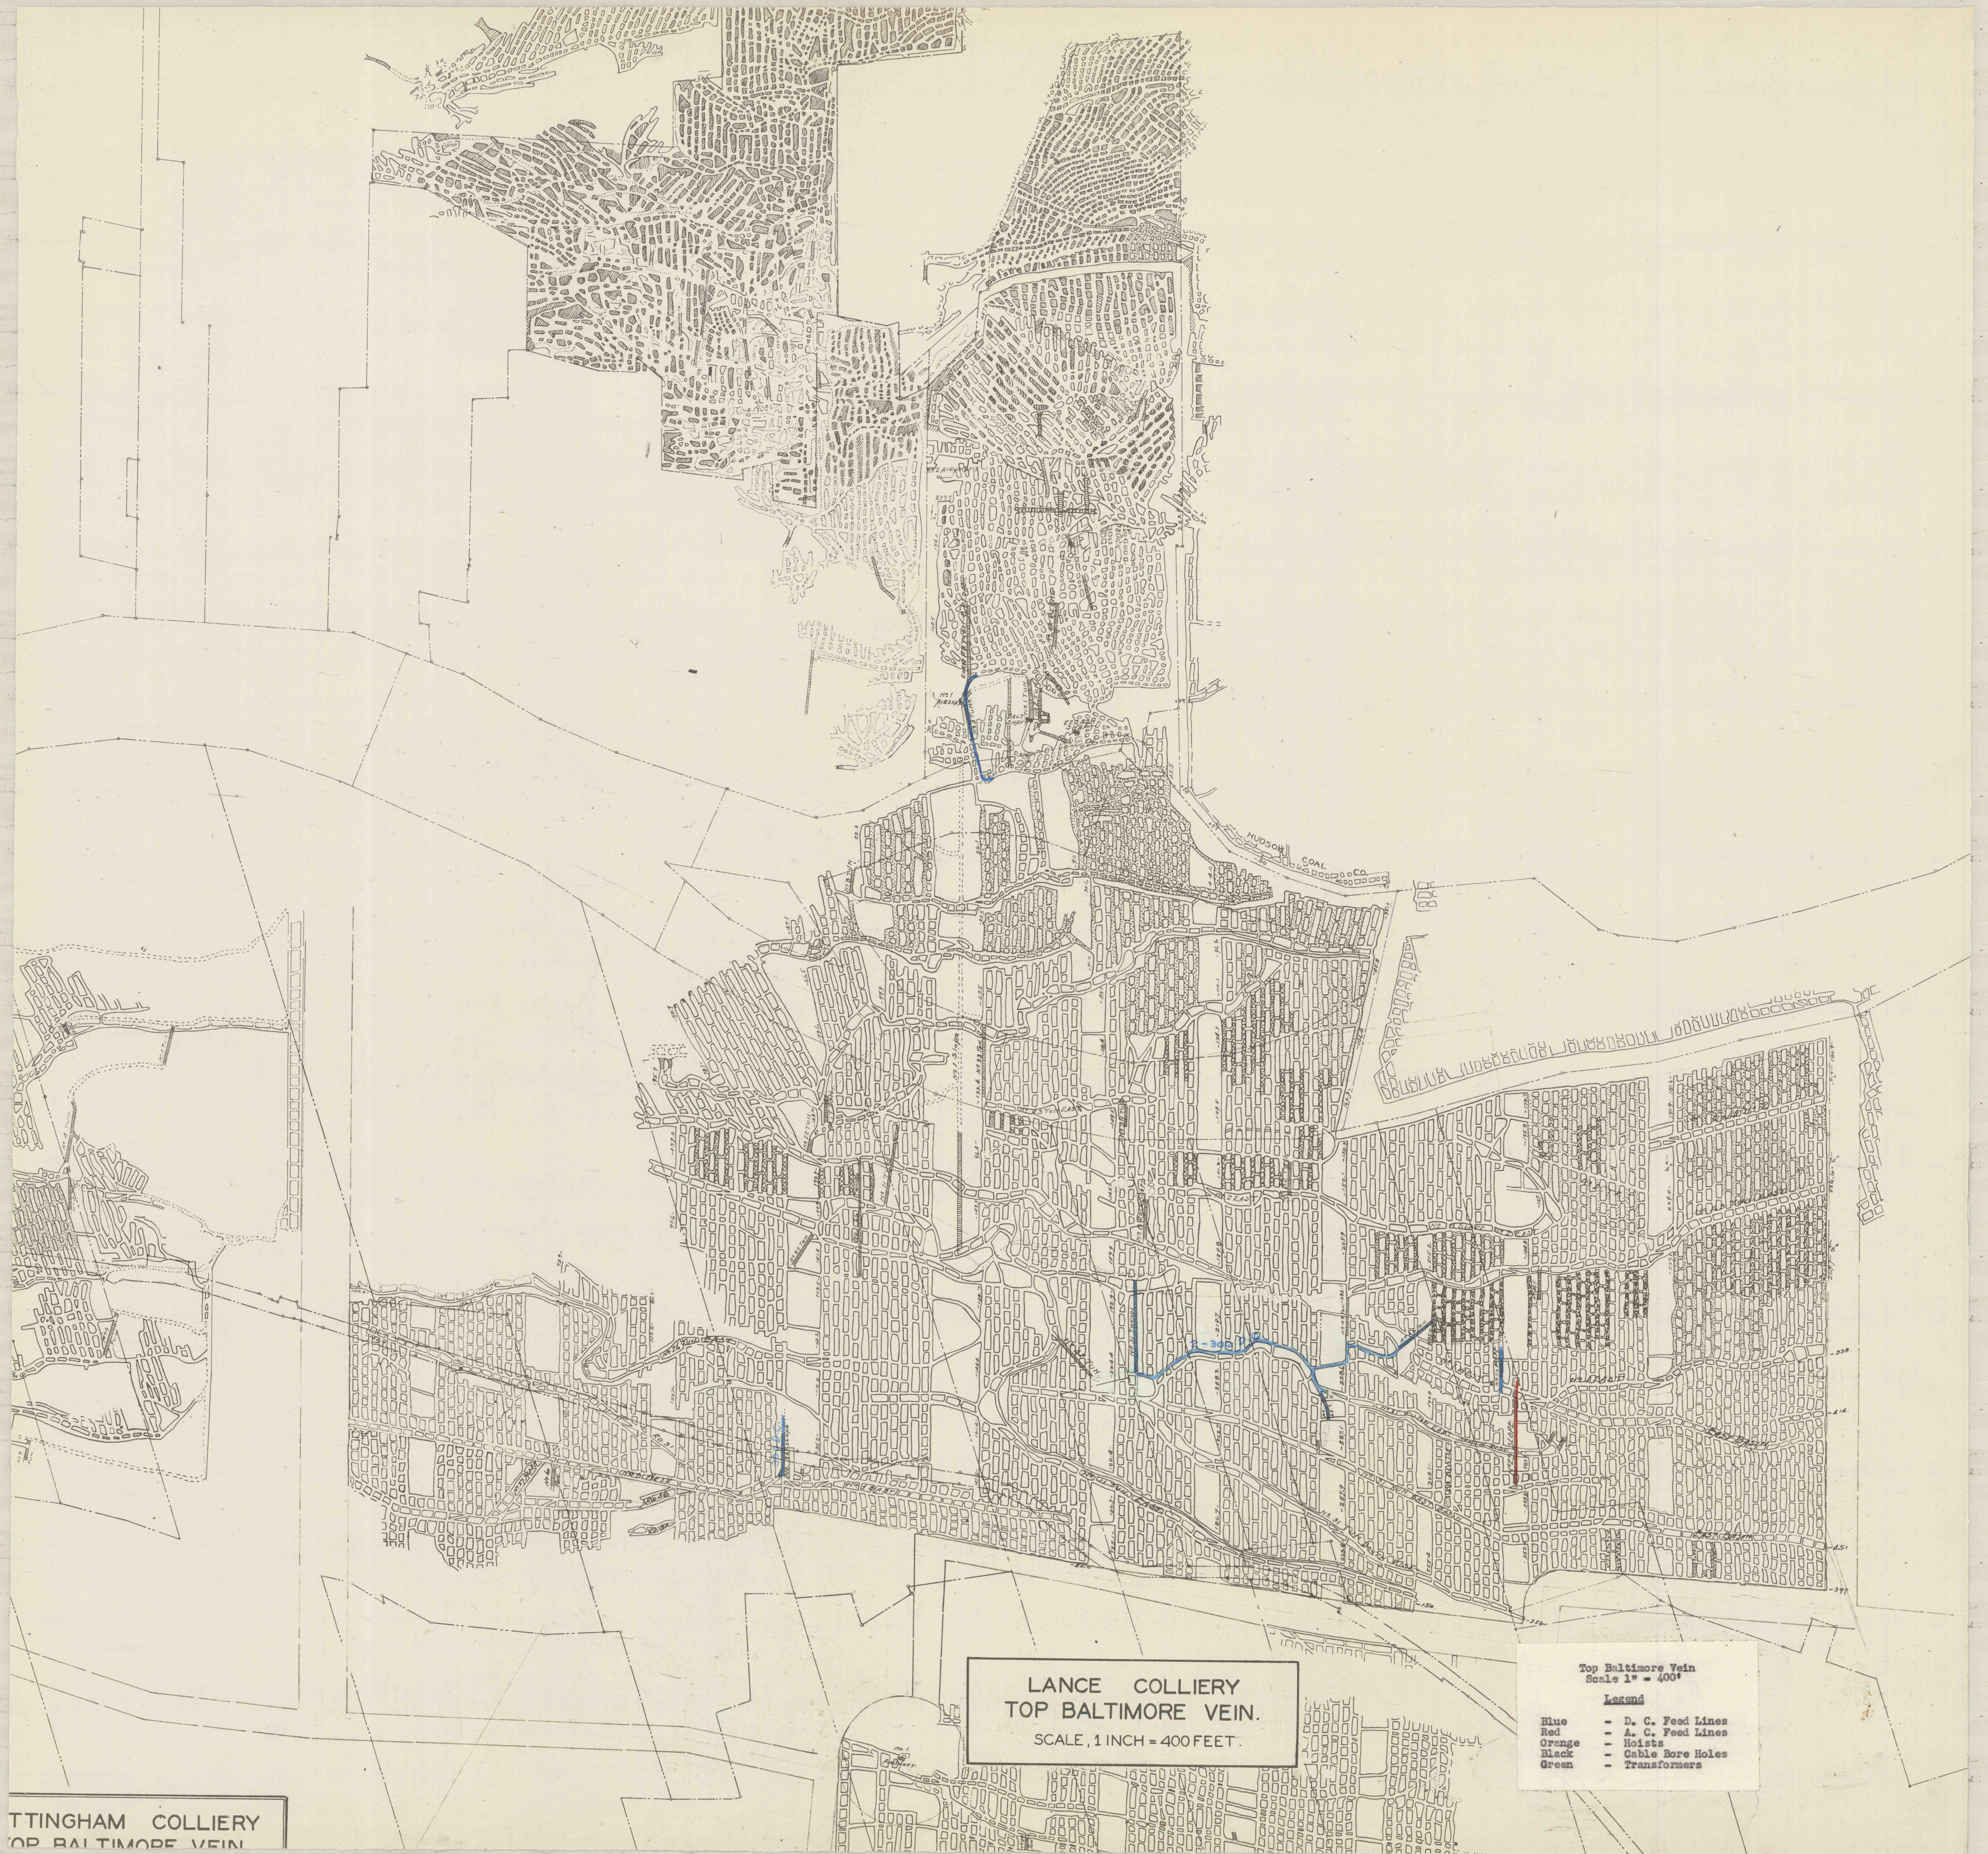

LANCE COLLIERY
TOP BALTIMORE VEIN.
SCALE, 1 INCH = 400 FEET.

- Top Baltimore Vein
Scale 1" = 400'
- Legend
- Blue - D. C. Feed Lines
 - Red - A. C. Feed Lines
 - Orange - Hoists
 - Black - Cable Bore Holes
 - Green - Transformers

TTINGHAM COLLIERY
OP BALTIMORE VEIN