


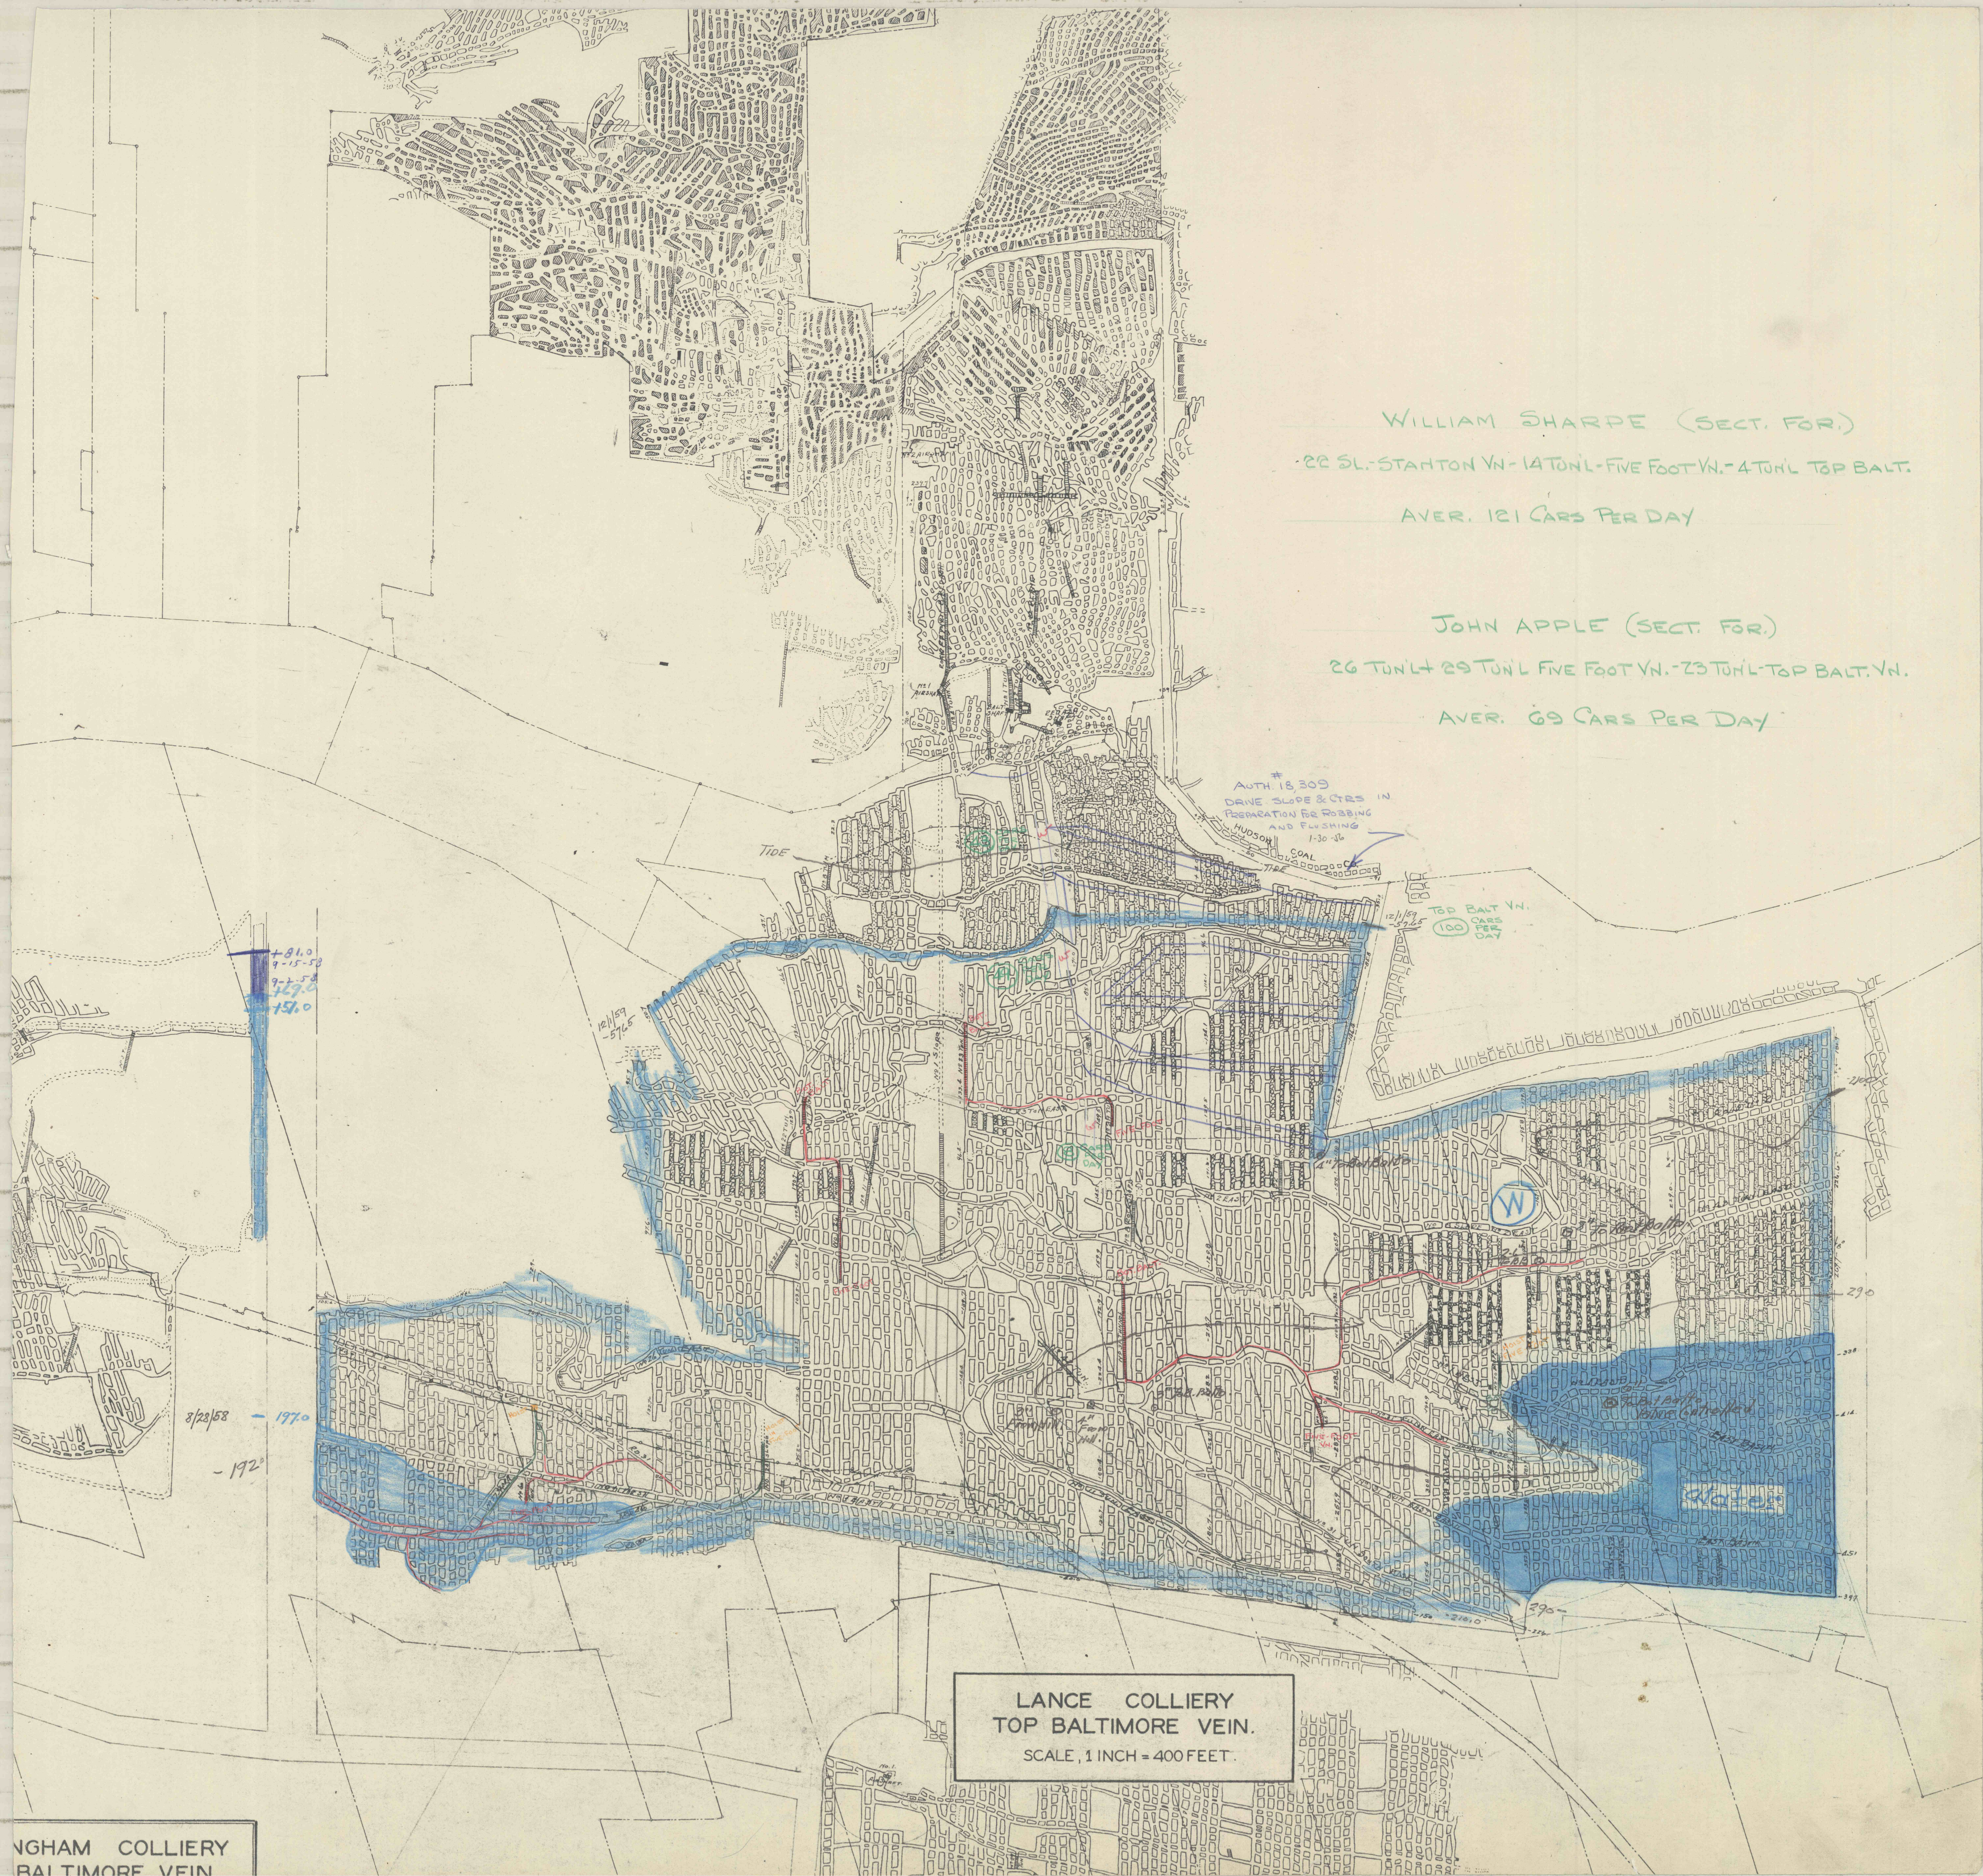

WILLIAM SHARPE (SECT. FOR.)

22 SL-STANTON VN-14 TONL-FIVE FOOT VN.-4 TONL TOP BALT.

AVR. 121 CARS PER DAY

JOHN APPLE (SECT. FOR.)

26 TONL+29 TONL FIVE FOOT VN.-23 TONL-TOP BALT.VN.

AVR. 69 CARS PER DAY

AUTH. 18,309
DRIVE SLOPE & CTRS IN
PREPARATION FOR ROBBING
AND FLUSHING
HUDSON
1-30-56

TOP BALT VN.
100
CARS
PER
DAY

+81.0
9-15-58
7-1-58
157.0

8/23/58 - 1970

- 1920

LANCE COLLIERY
TOP BALTIMORE VEIN.
SCALE, 1 INCH = 400 FEET.

NGHAM COLLIERY
BALTIMORE VEIN